




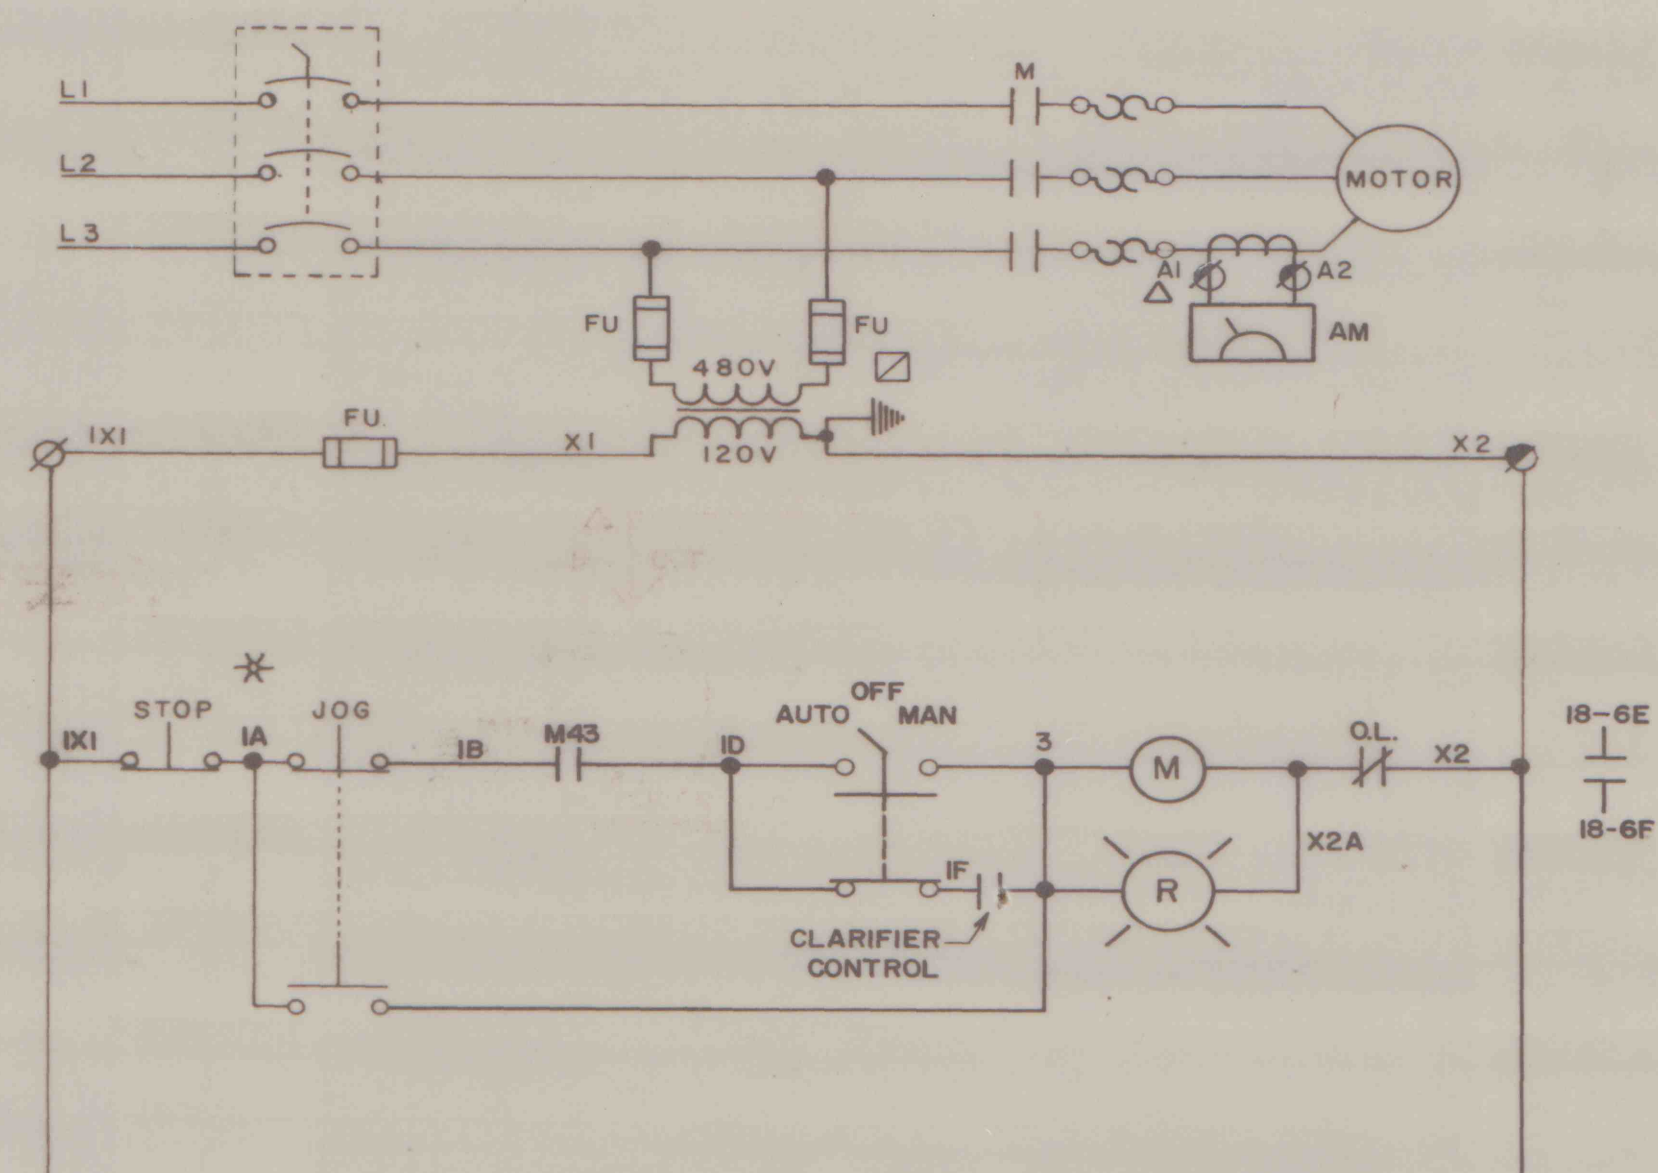


UNIT	DESCRIPTION	HP	MCC
29A	CLARIFIER UNDERFLOW PUMP NO. 1	10	P3

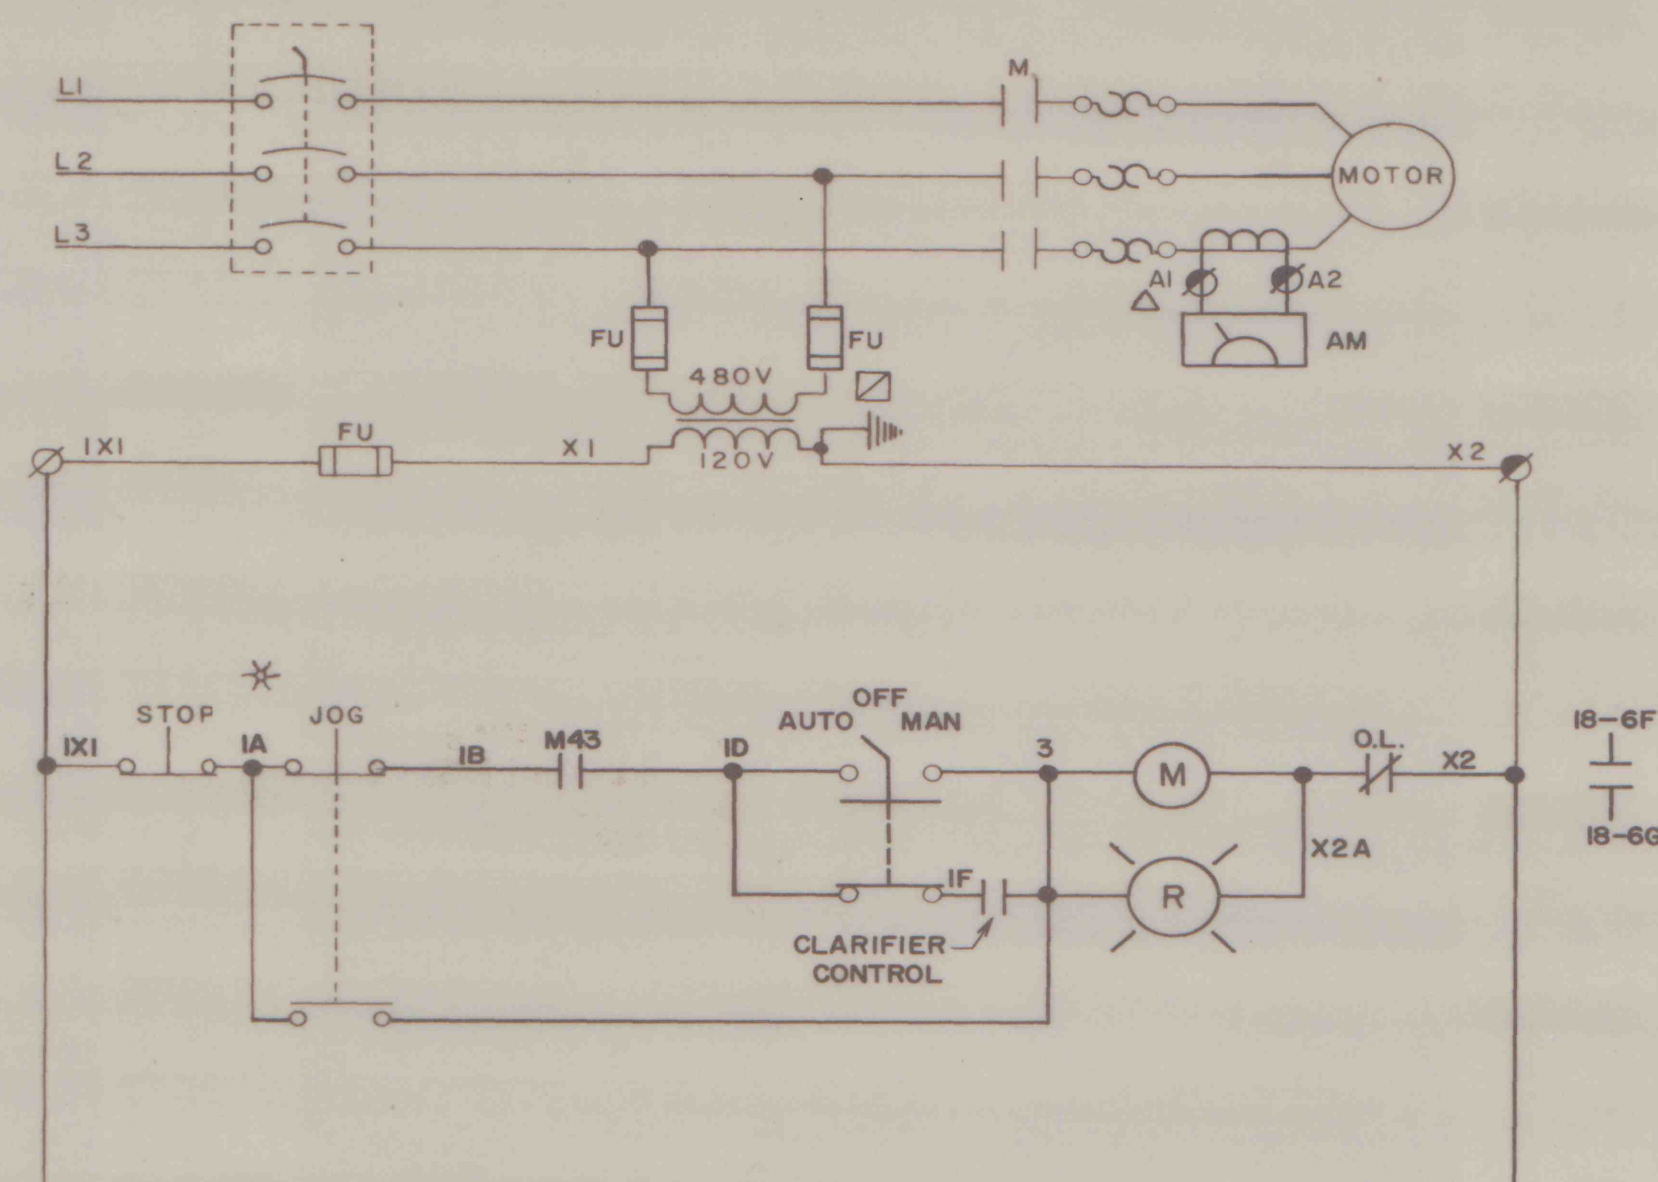


UNIT	DESCRIPTION	HP	MCC
29B	CLARIFIER UNDERFLOW PUMP NO. 2	10	P3

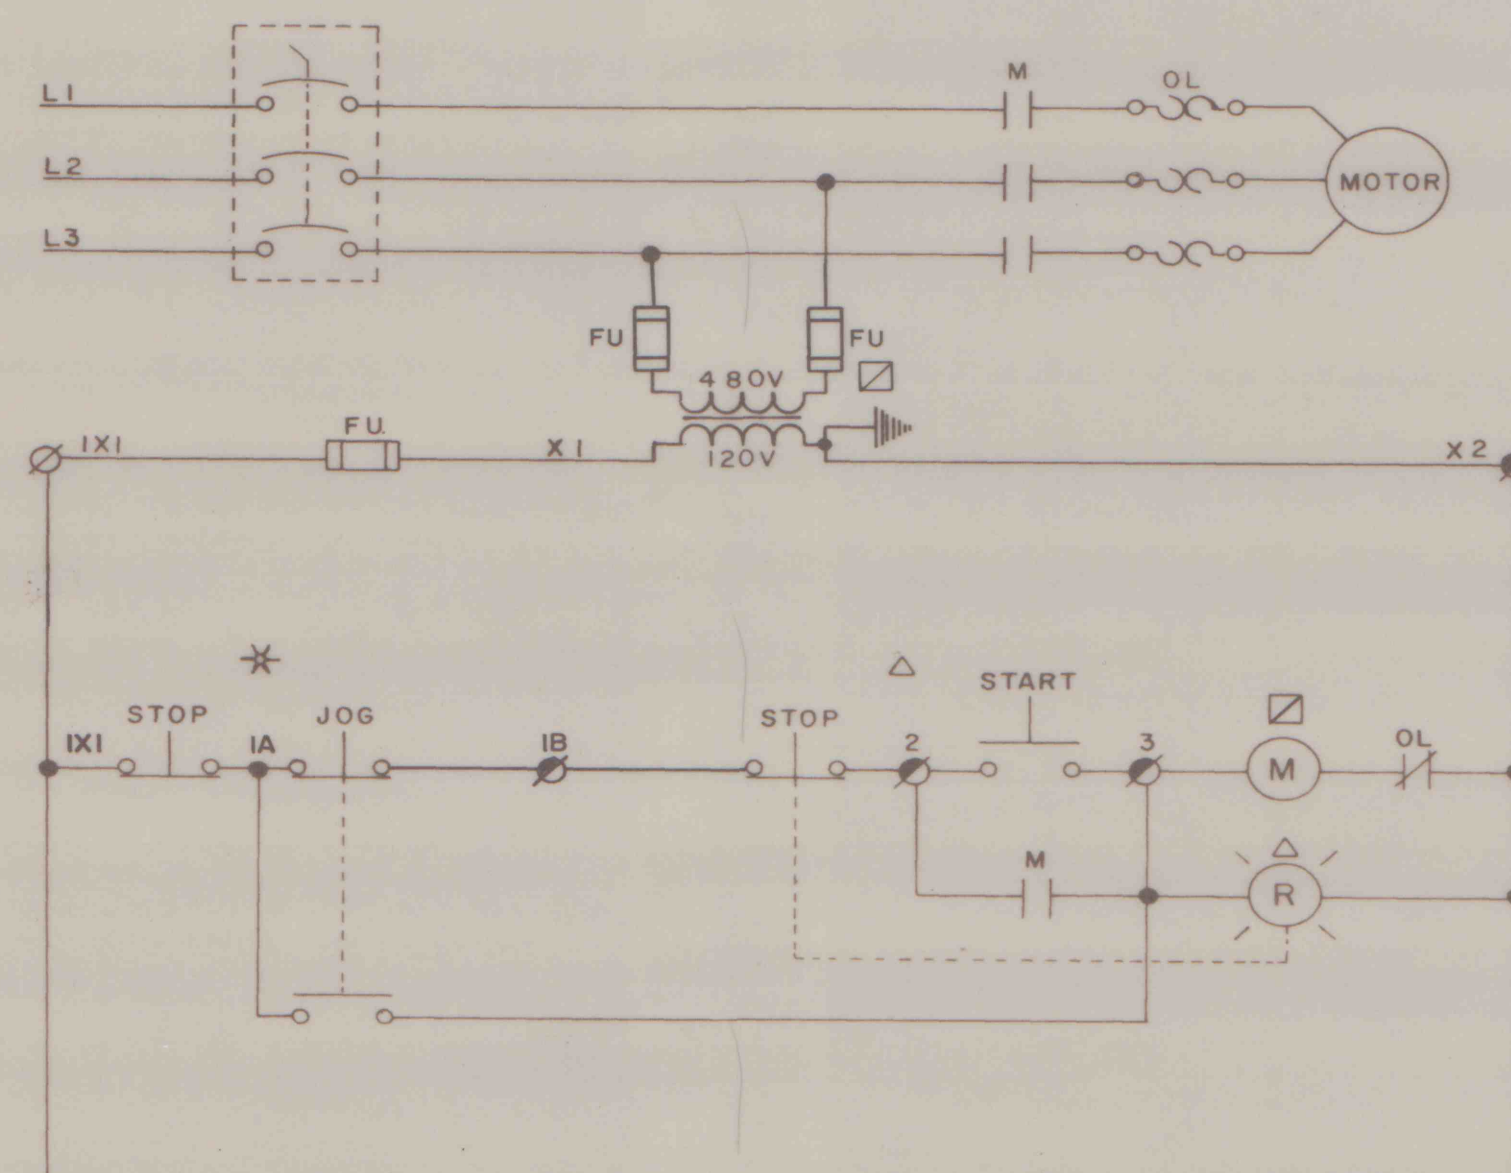

UNIT	DESCRIPTION	HP	MCC
30A	FILTER AGITATOR NO. 1	2	P2

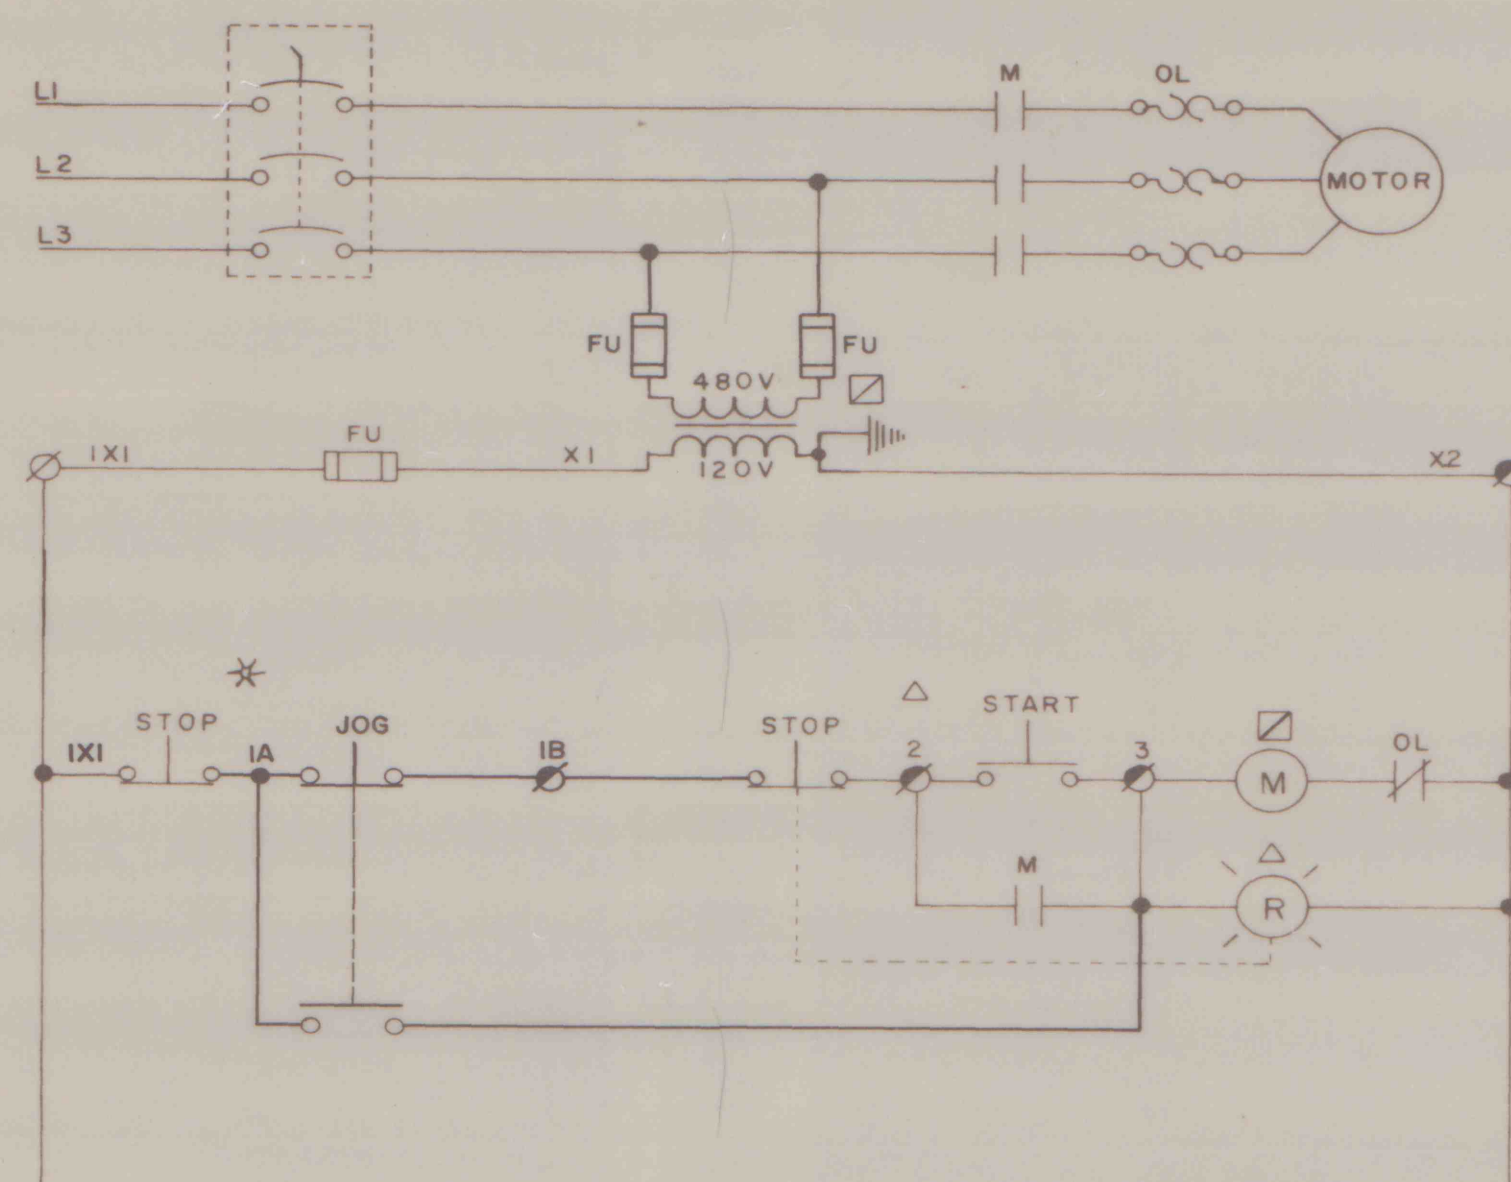

UNIT	DESCRIPTION	HP	MCC
30B	FILTER AGITATOR NO. 2	2	P2

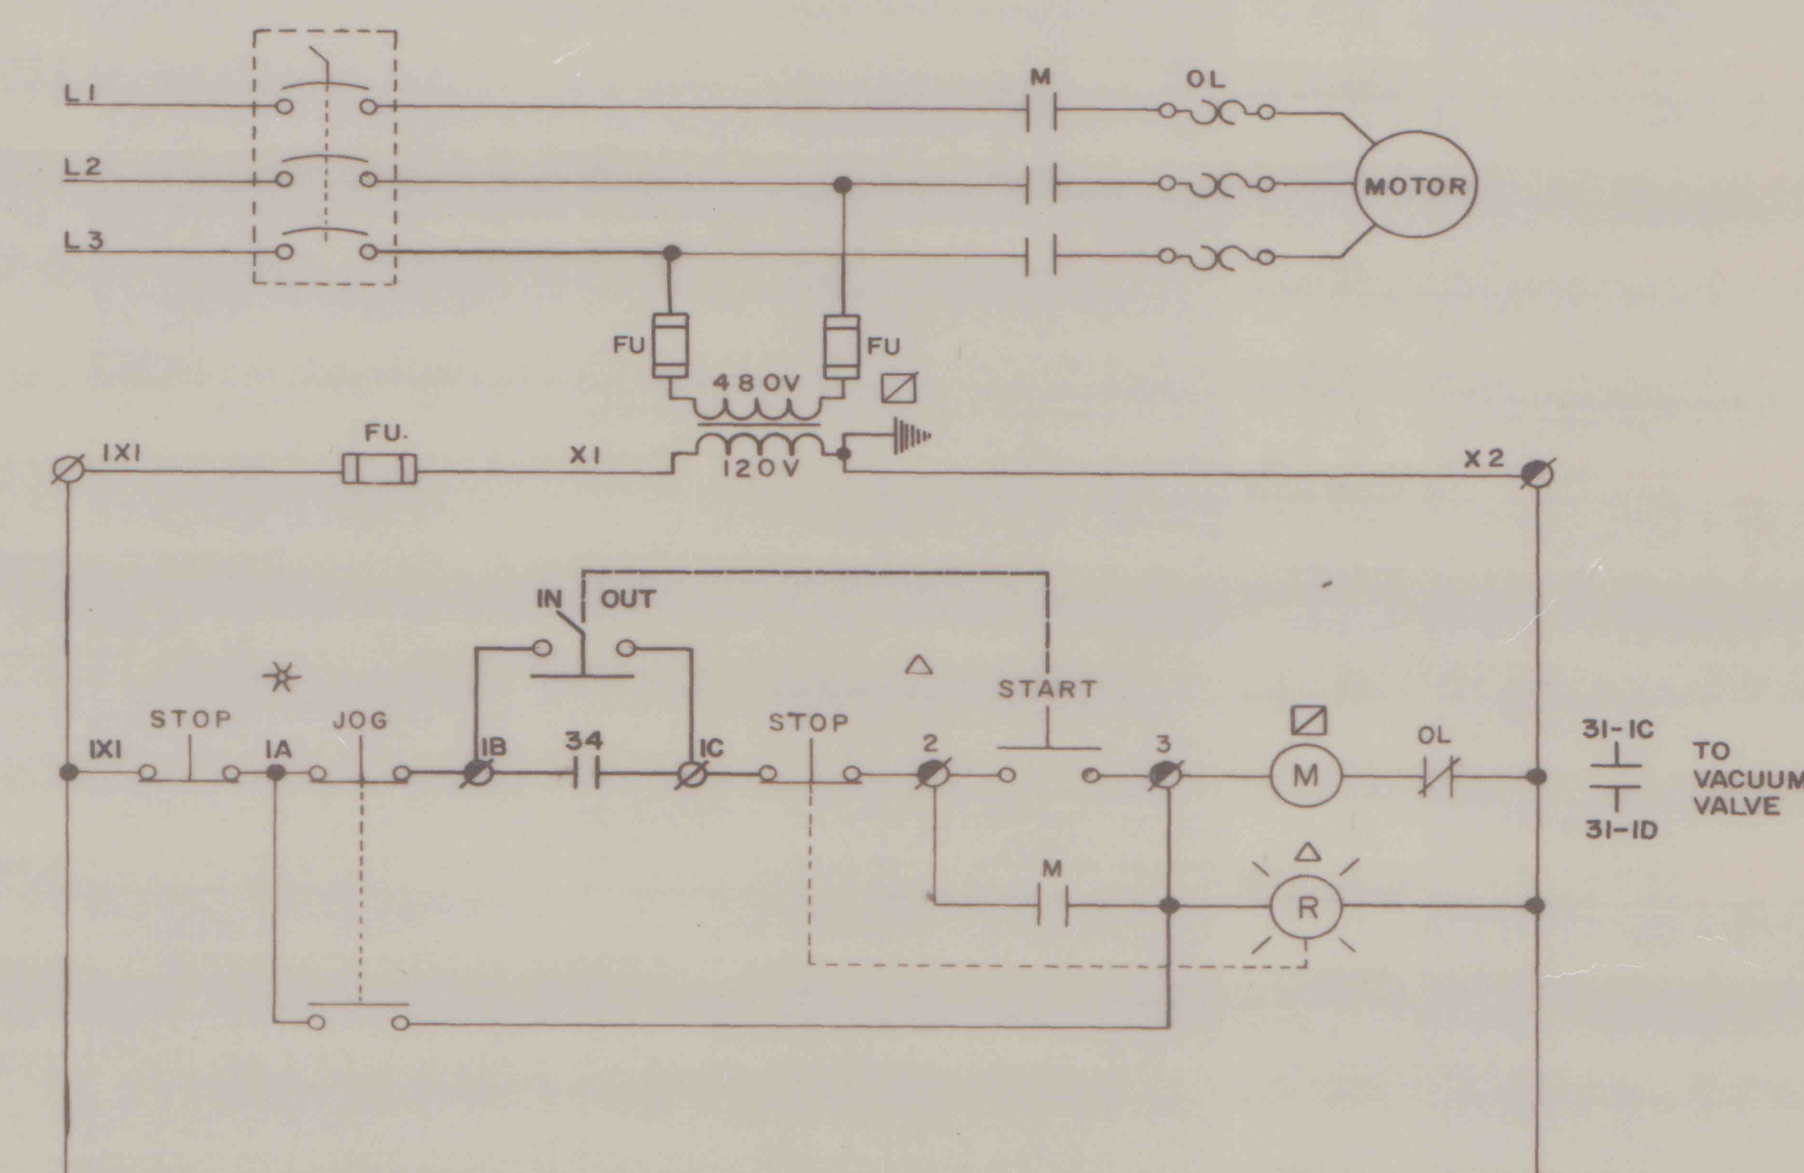

UNIT	DESCRIPTION	HP	MCC
30C	FILTER DRIVE	3	P2

E-29	DELETE INTERLOCK IN DISC. SW.	1	7-15-82	LDM
	REVISION	2	5/18/83	LDM
E-29	FOR APPROVAL	0	5-19-82	LDM
DWG. NO.	REFERENCE	NO.	DATE	BY
BLAIR ELECTRIC SERVICE CO. BELLWOOD, PENNSYLVANIA R&P COAL CO.—KEYSTONE PLANT ELECTRICAL SCHEMATICS DRAWN: J/K DATE: 5/19/82 CHECKED: W7478 APPROVED: DATE: SCALE: DWG. NO. E-29				