



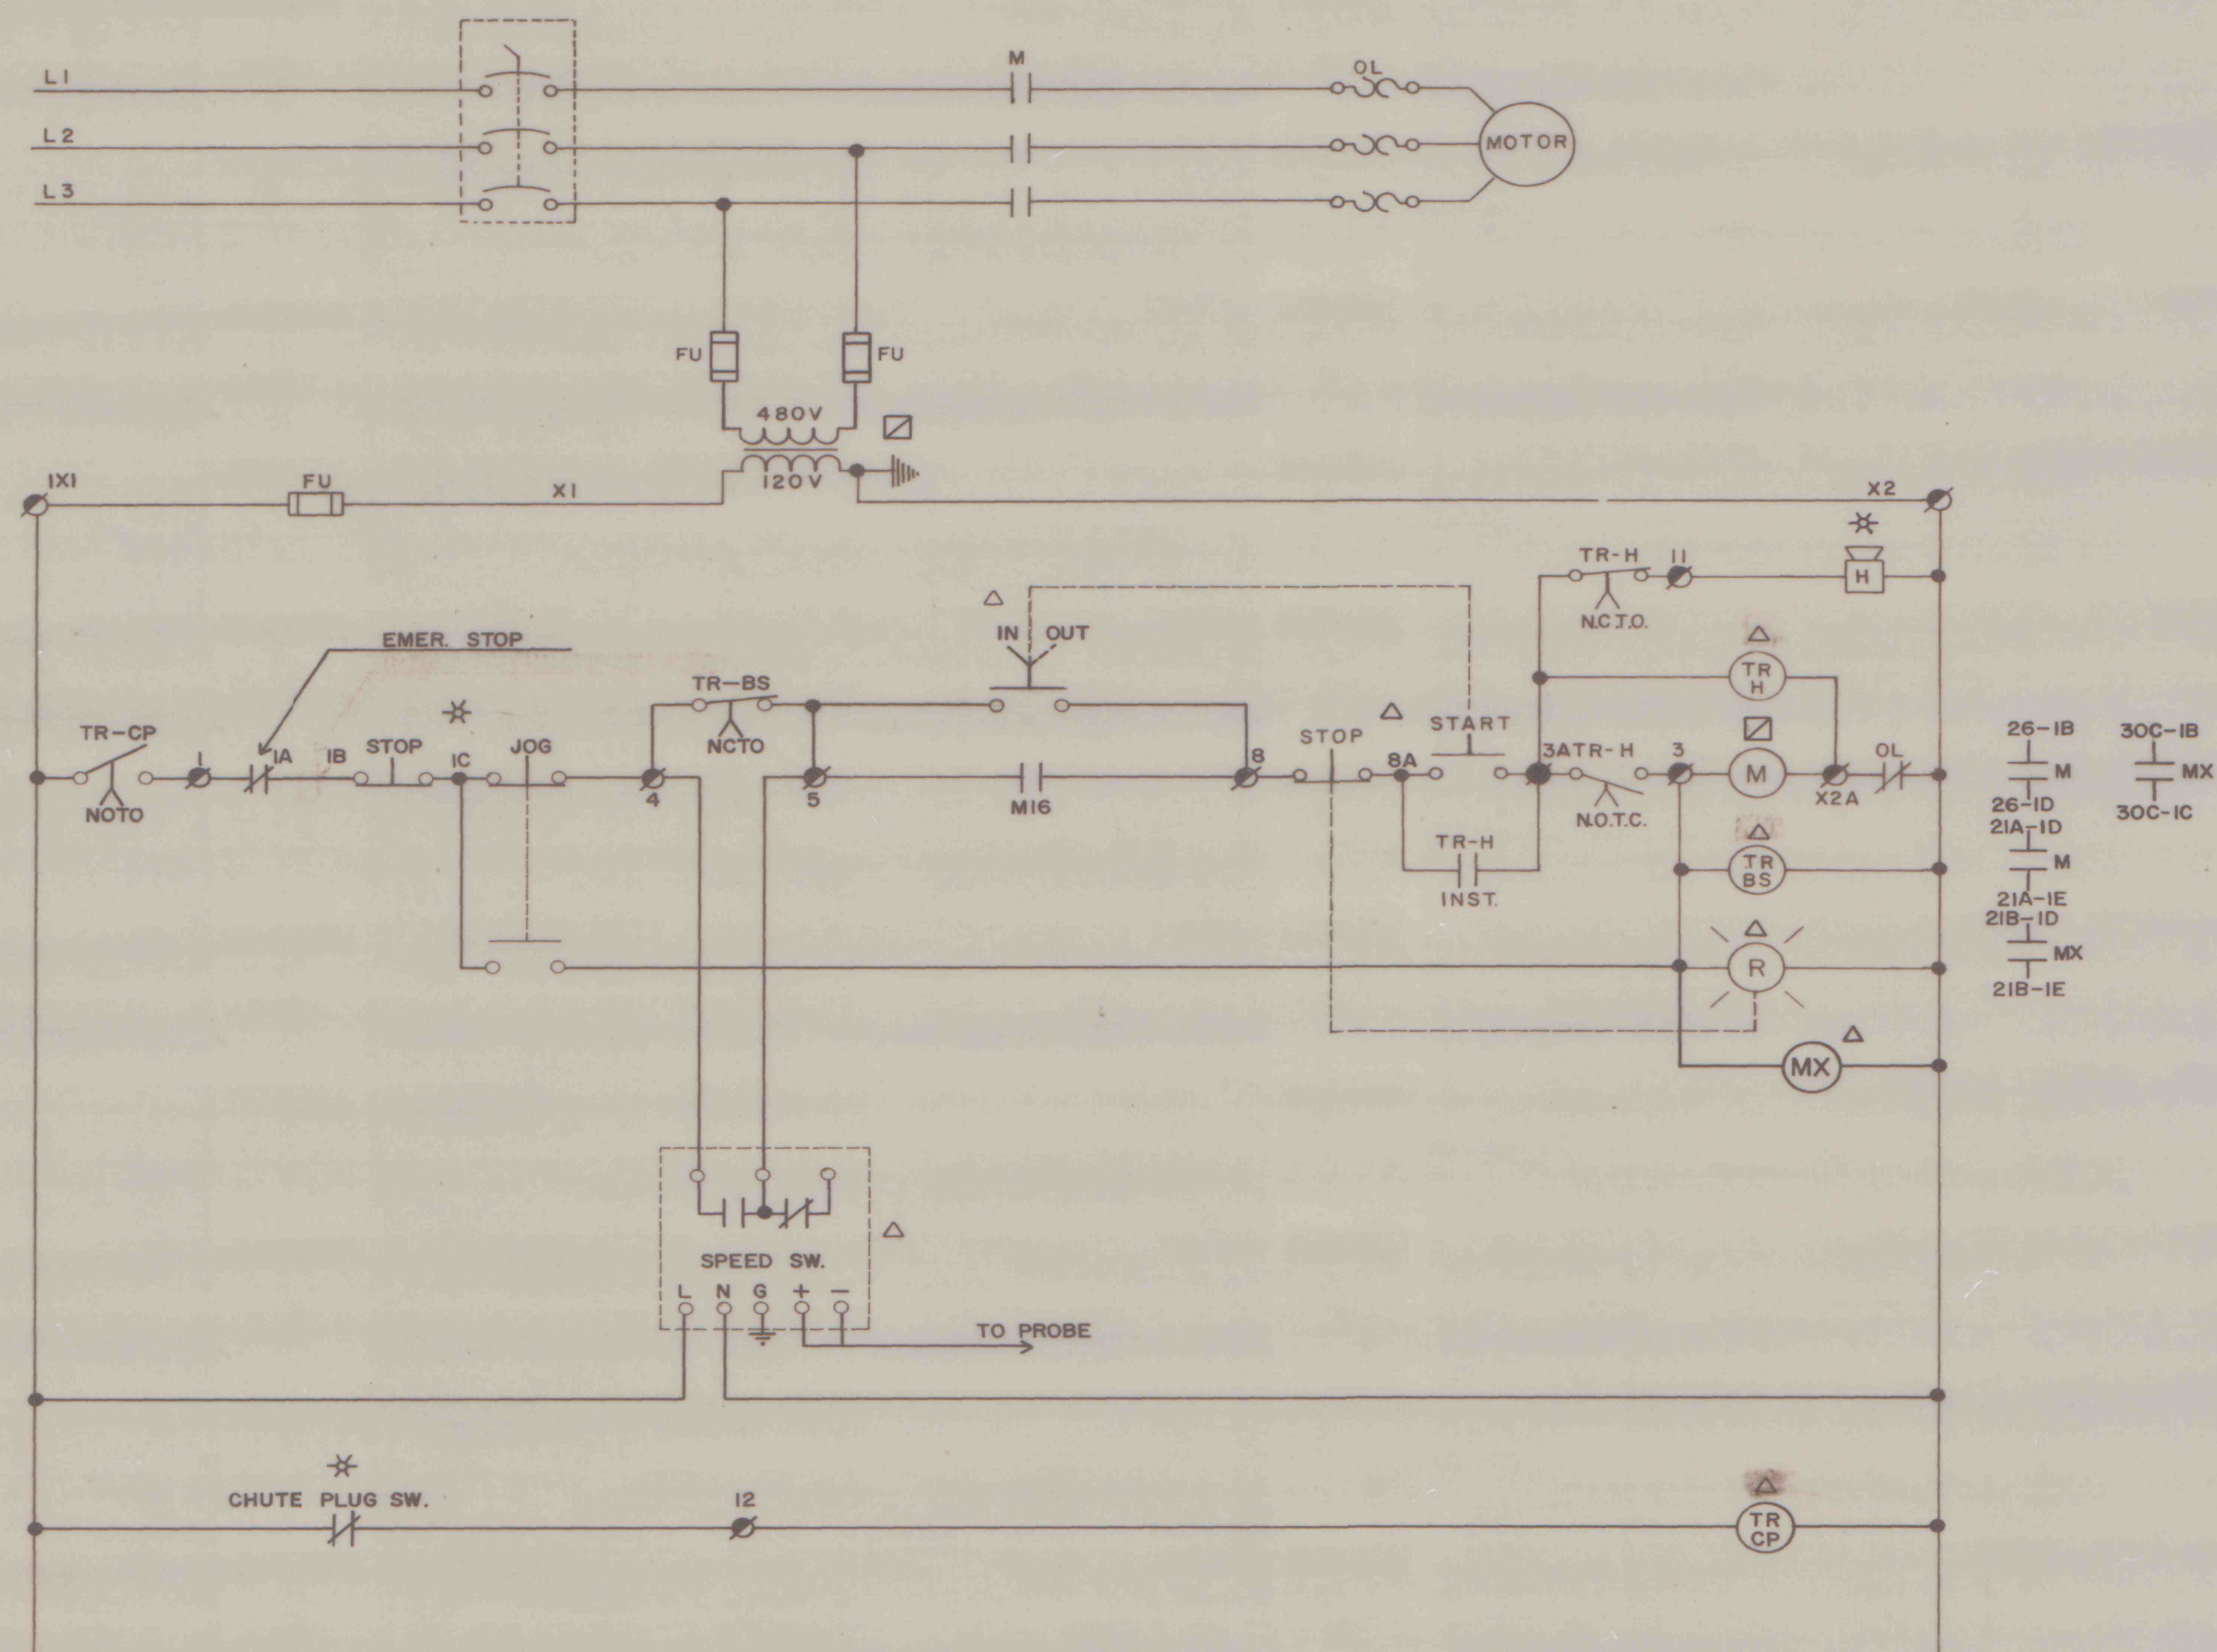

UNIT	DESCRIPTION	HP	MCC
34	CLEAN COAL CONVEYOR NO. 12	20	P2

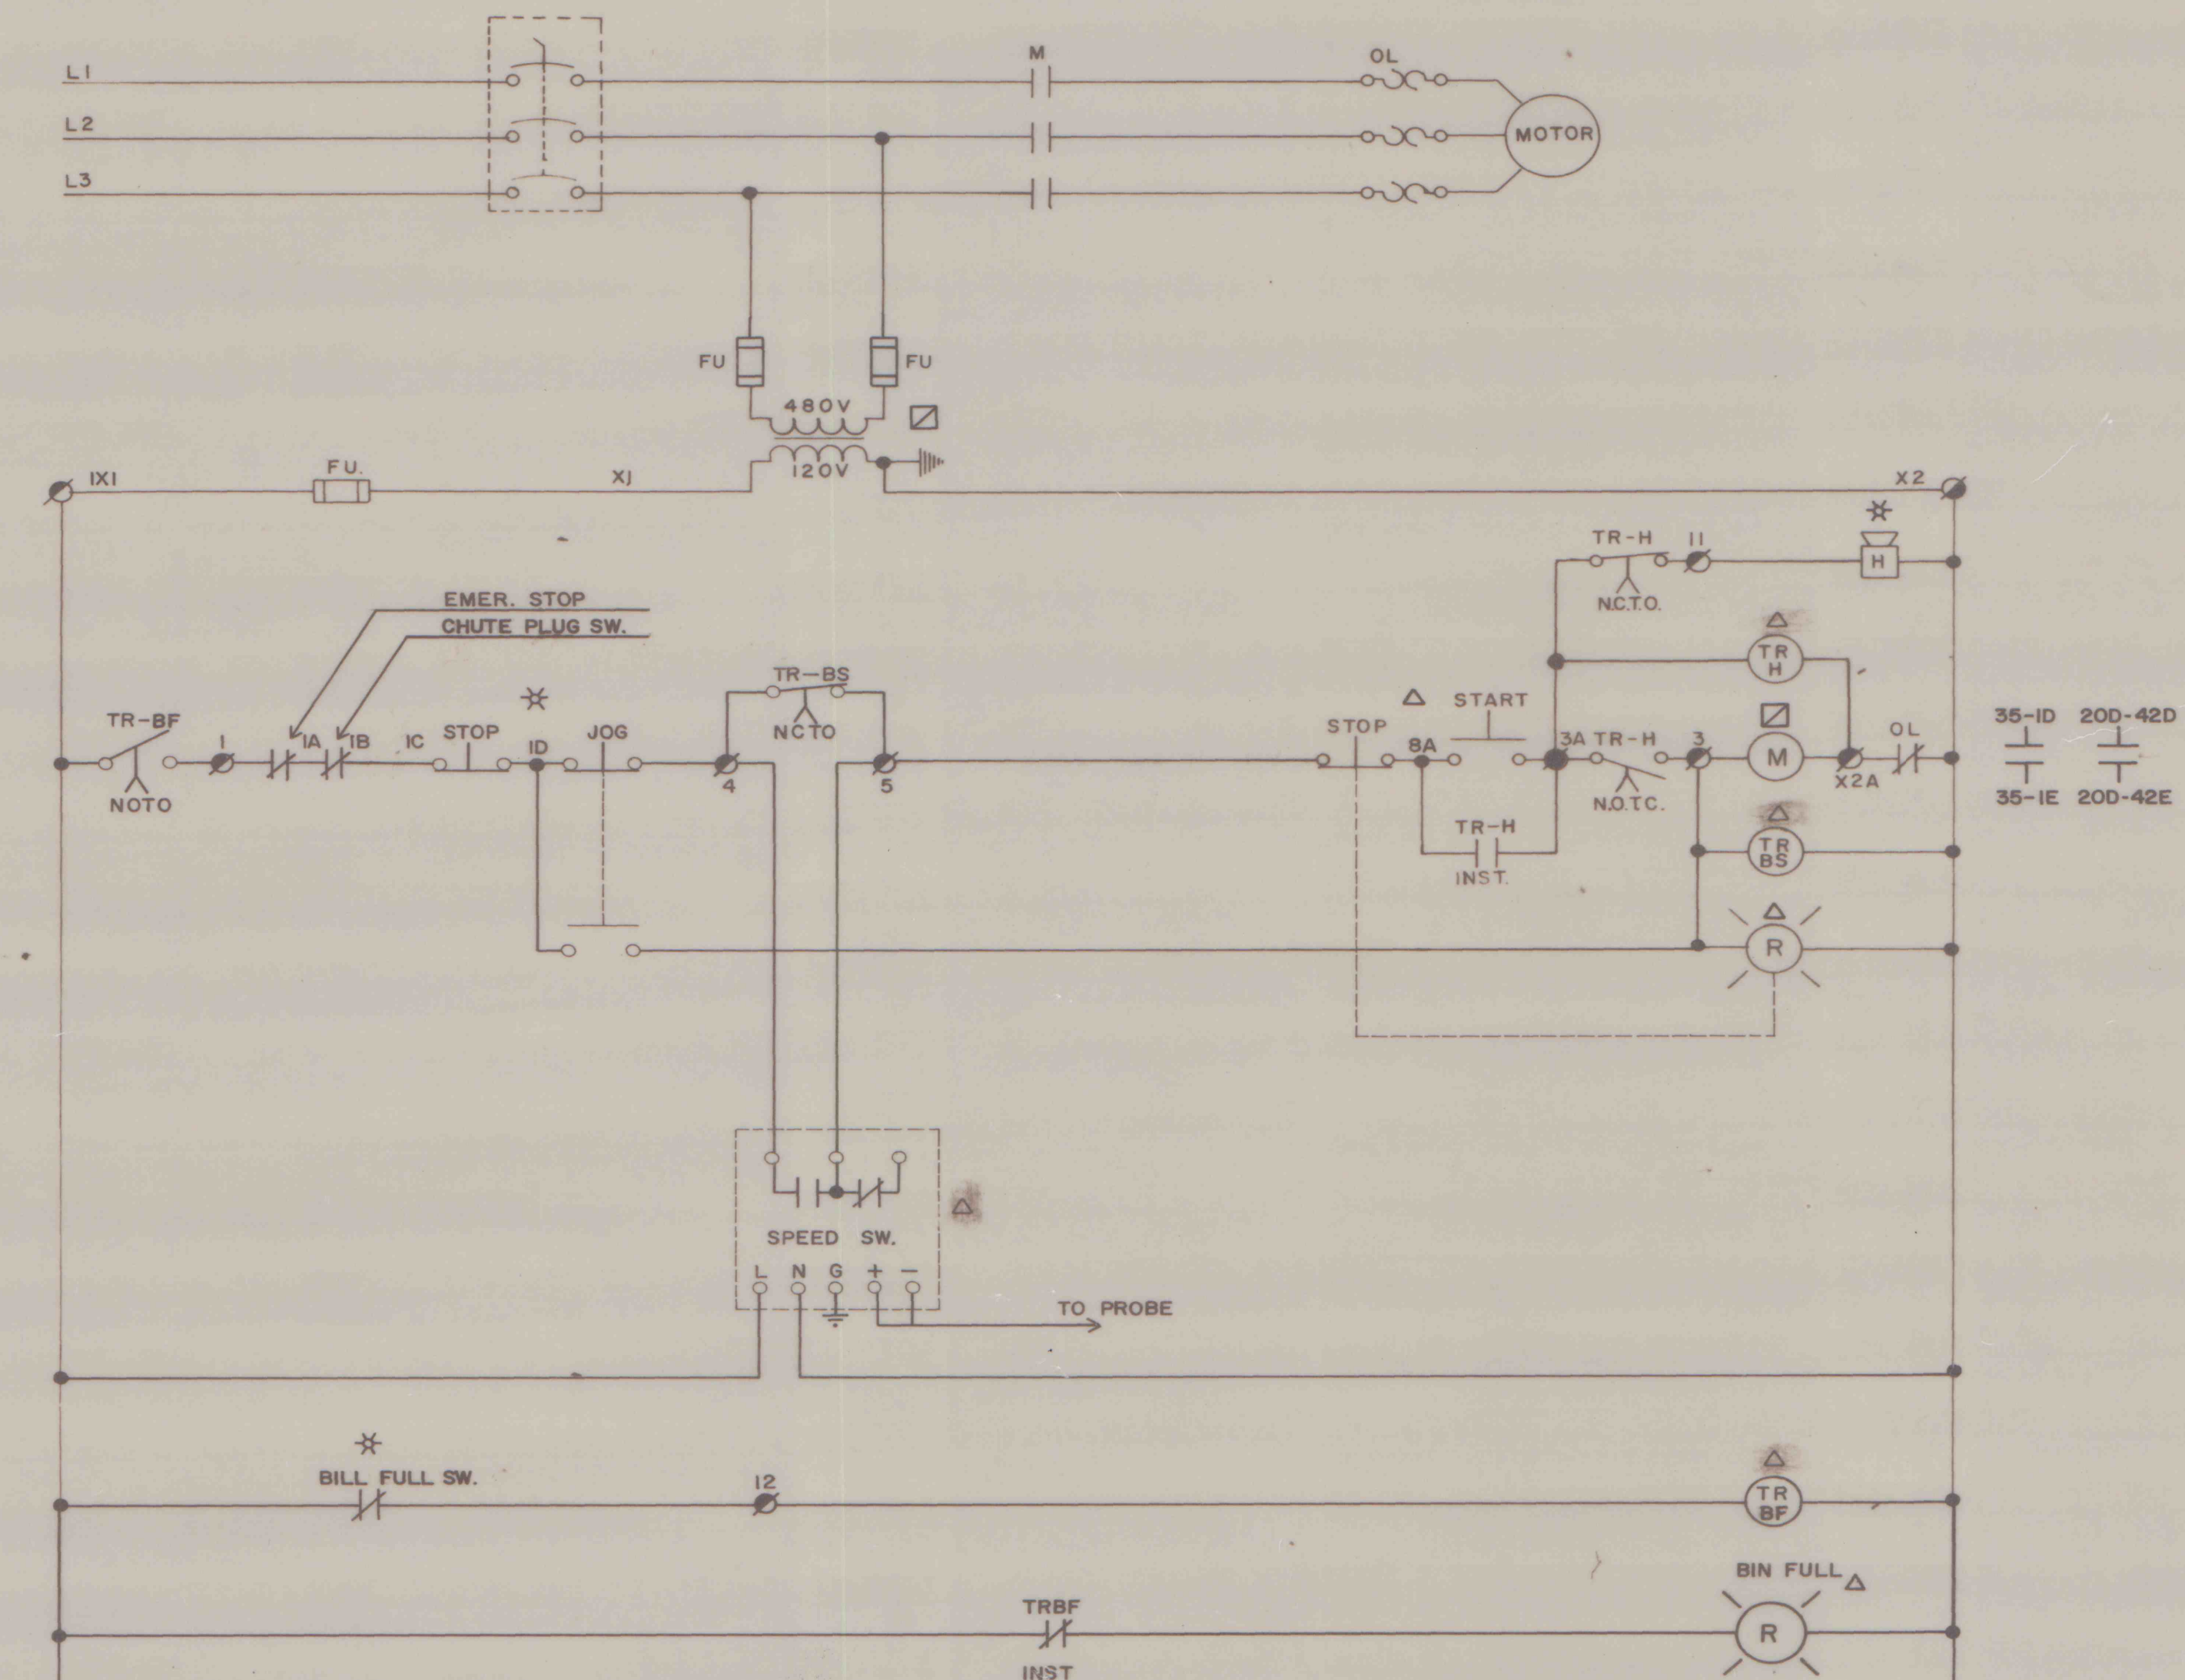

UNIT	DESCRIPTION	HP	MCC
39	REFUSE CONVEYOR NO. 14	20	P2

E-31	DELETE INTERLOCK IN DISC. SW.	1	7-15-82	ldm
	REVISION	2	5-17-83	ldm
E-31	FOR APPROVAL	0	5-17-82	ldm
DWG. NO.	REFERENCE	NO.	DATE	BY
		REVISIONS		

BLAIR ELECTRIC SERVICE CO.				
BELLWOOD, PENNSYLVANIA				
R & P COAL CO.—KEYSTONE PLANT				

SCHEMATIC DIAGRAMS				
DRAWN	DATE	ORDER NO.		
JK	5/20/82	W7478		
CHECKED	DATE	SCALE		
APPROVED	DATE			
		DWG. NO. E-31		