



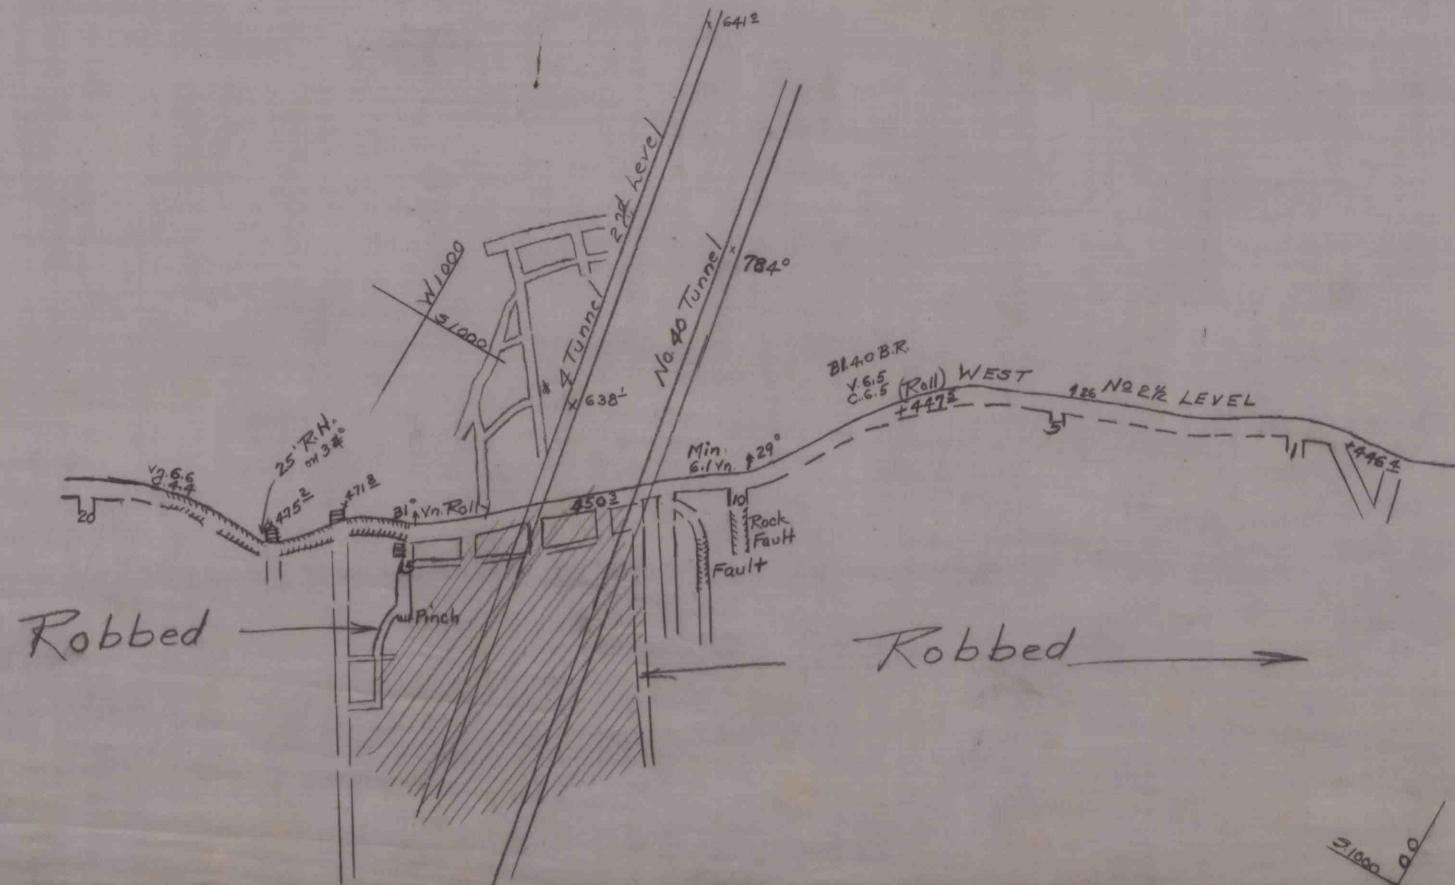

WESTERN MIDDLE FIELD.
PACKER NO. 4 Colliery.
MAHANOTWP. SCHUYLKILL CO. PA.

Holmes Vein
W. MAHANOT DISTRICT.
LEHIGH VALLEY COAL CO.

100=1" Copied from Packer #5-map 1/24/47

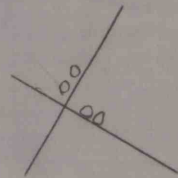

2/1000 00