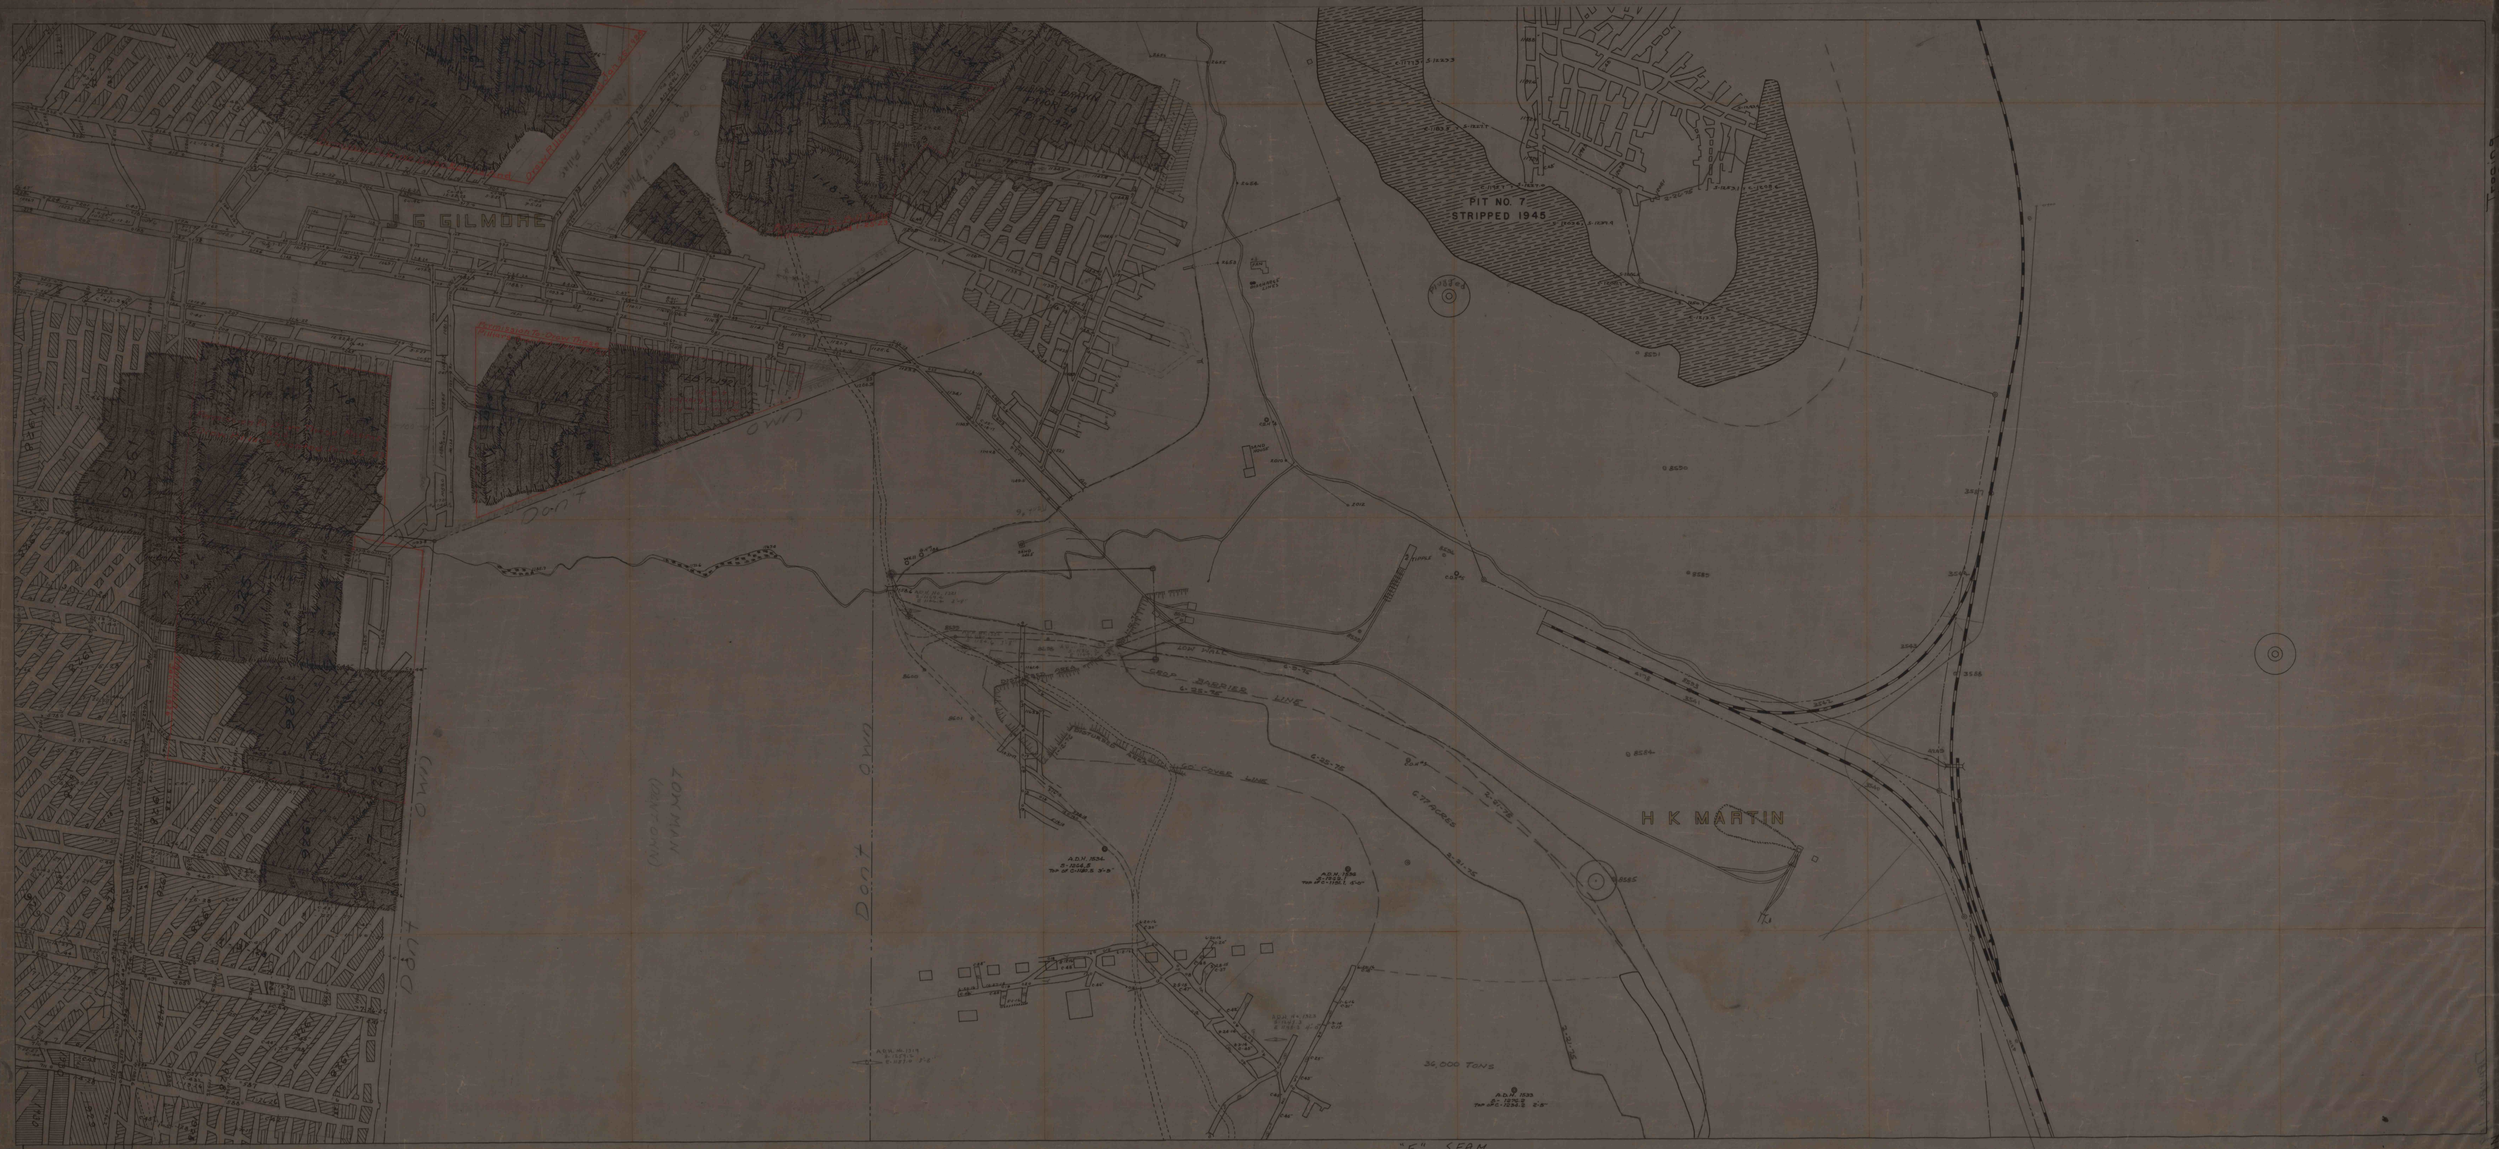
J G GILMORE
PIT NO. 7
STRIPPED 1945
H K MARTIN
LOW PITS
DEEP BRANCH LINE
LOW POWER LINE
34,000 TONS
"E" SEAM
DRAWER 107 BASEMENT FILE