


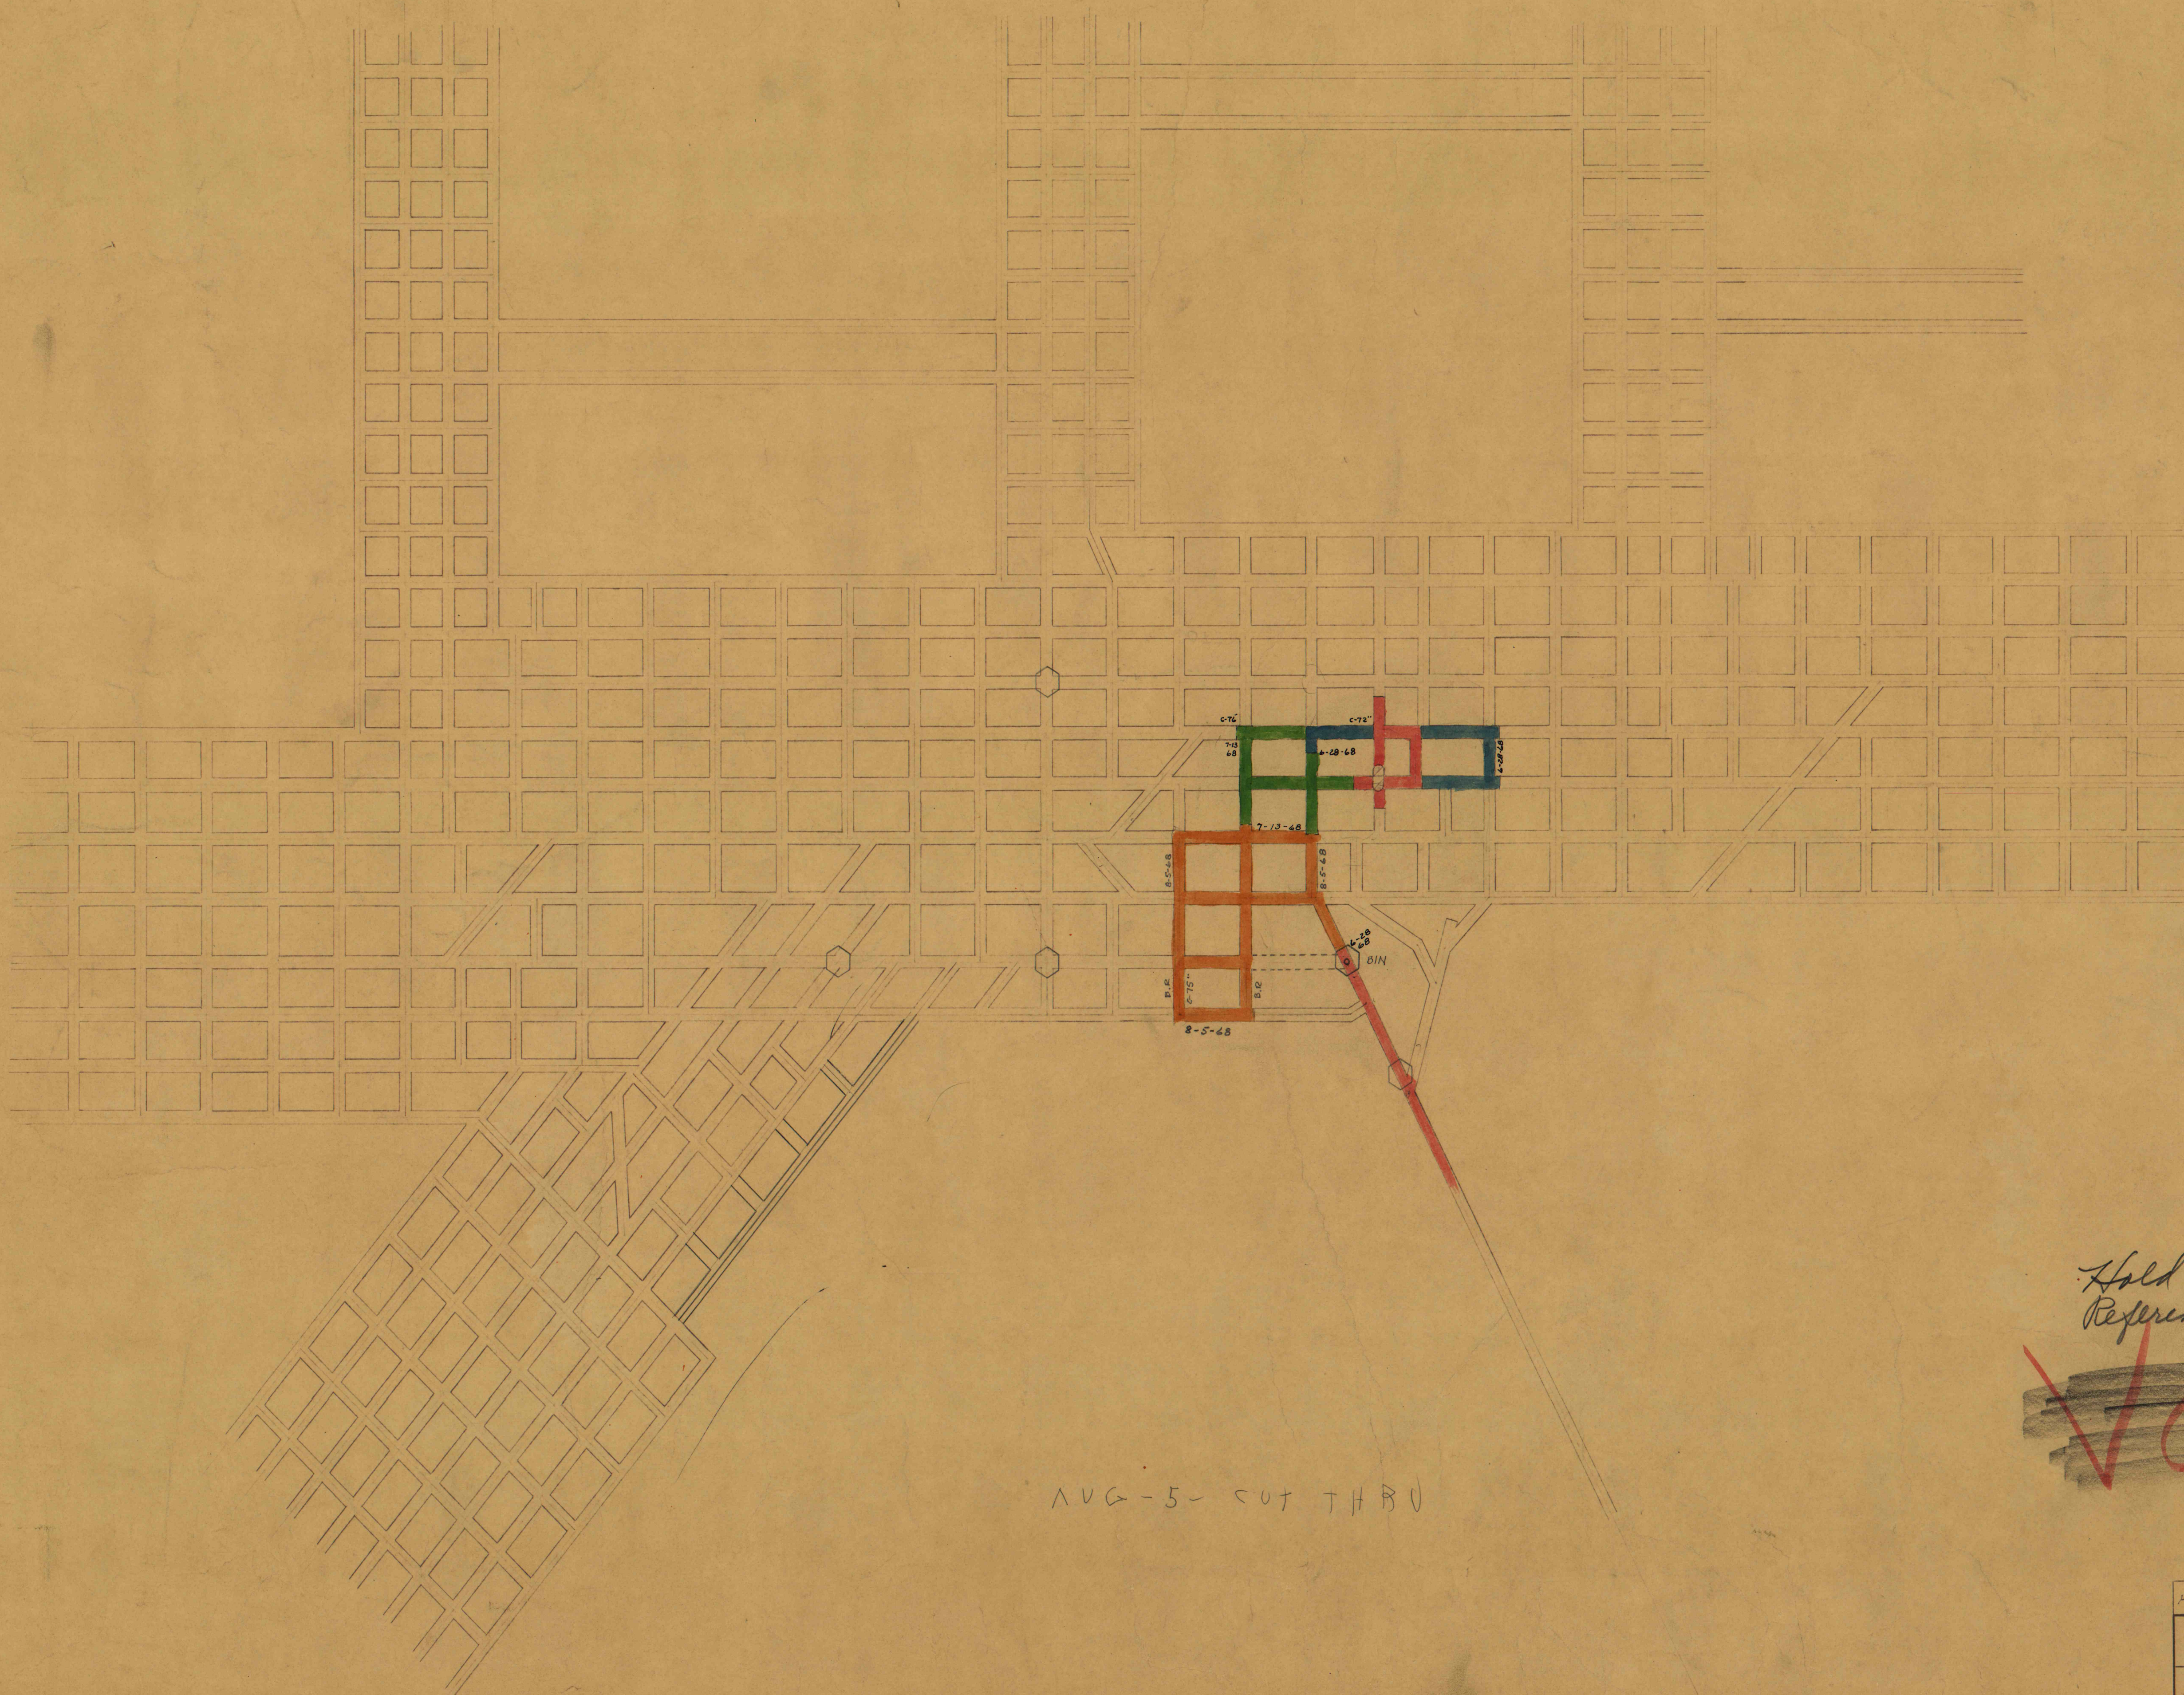

*Hold for future
Reference*

VOID

AUG-5-CUT THRU

9979-108

HELVETIA COAL CO.	
ROCHESTER & PITTSBURGH COAL CO.	
ENGINEERING DEPT., INDIANA, PA.	
LUCERNE No. 6	
YARDAGE PRINT	
MADE BY	SCALE 1"=100'
TRACED BY	DATE 8-2-68
CHECKED BY	NO.

Drawer 19 BASEMENT FILE 9979-4819