


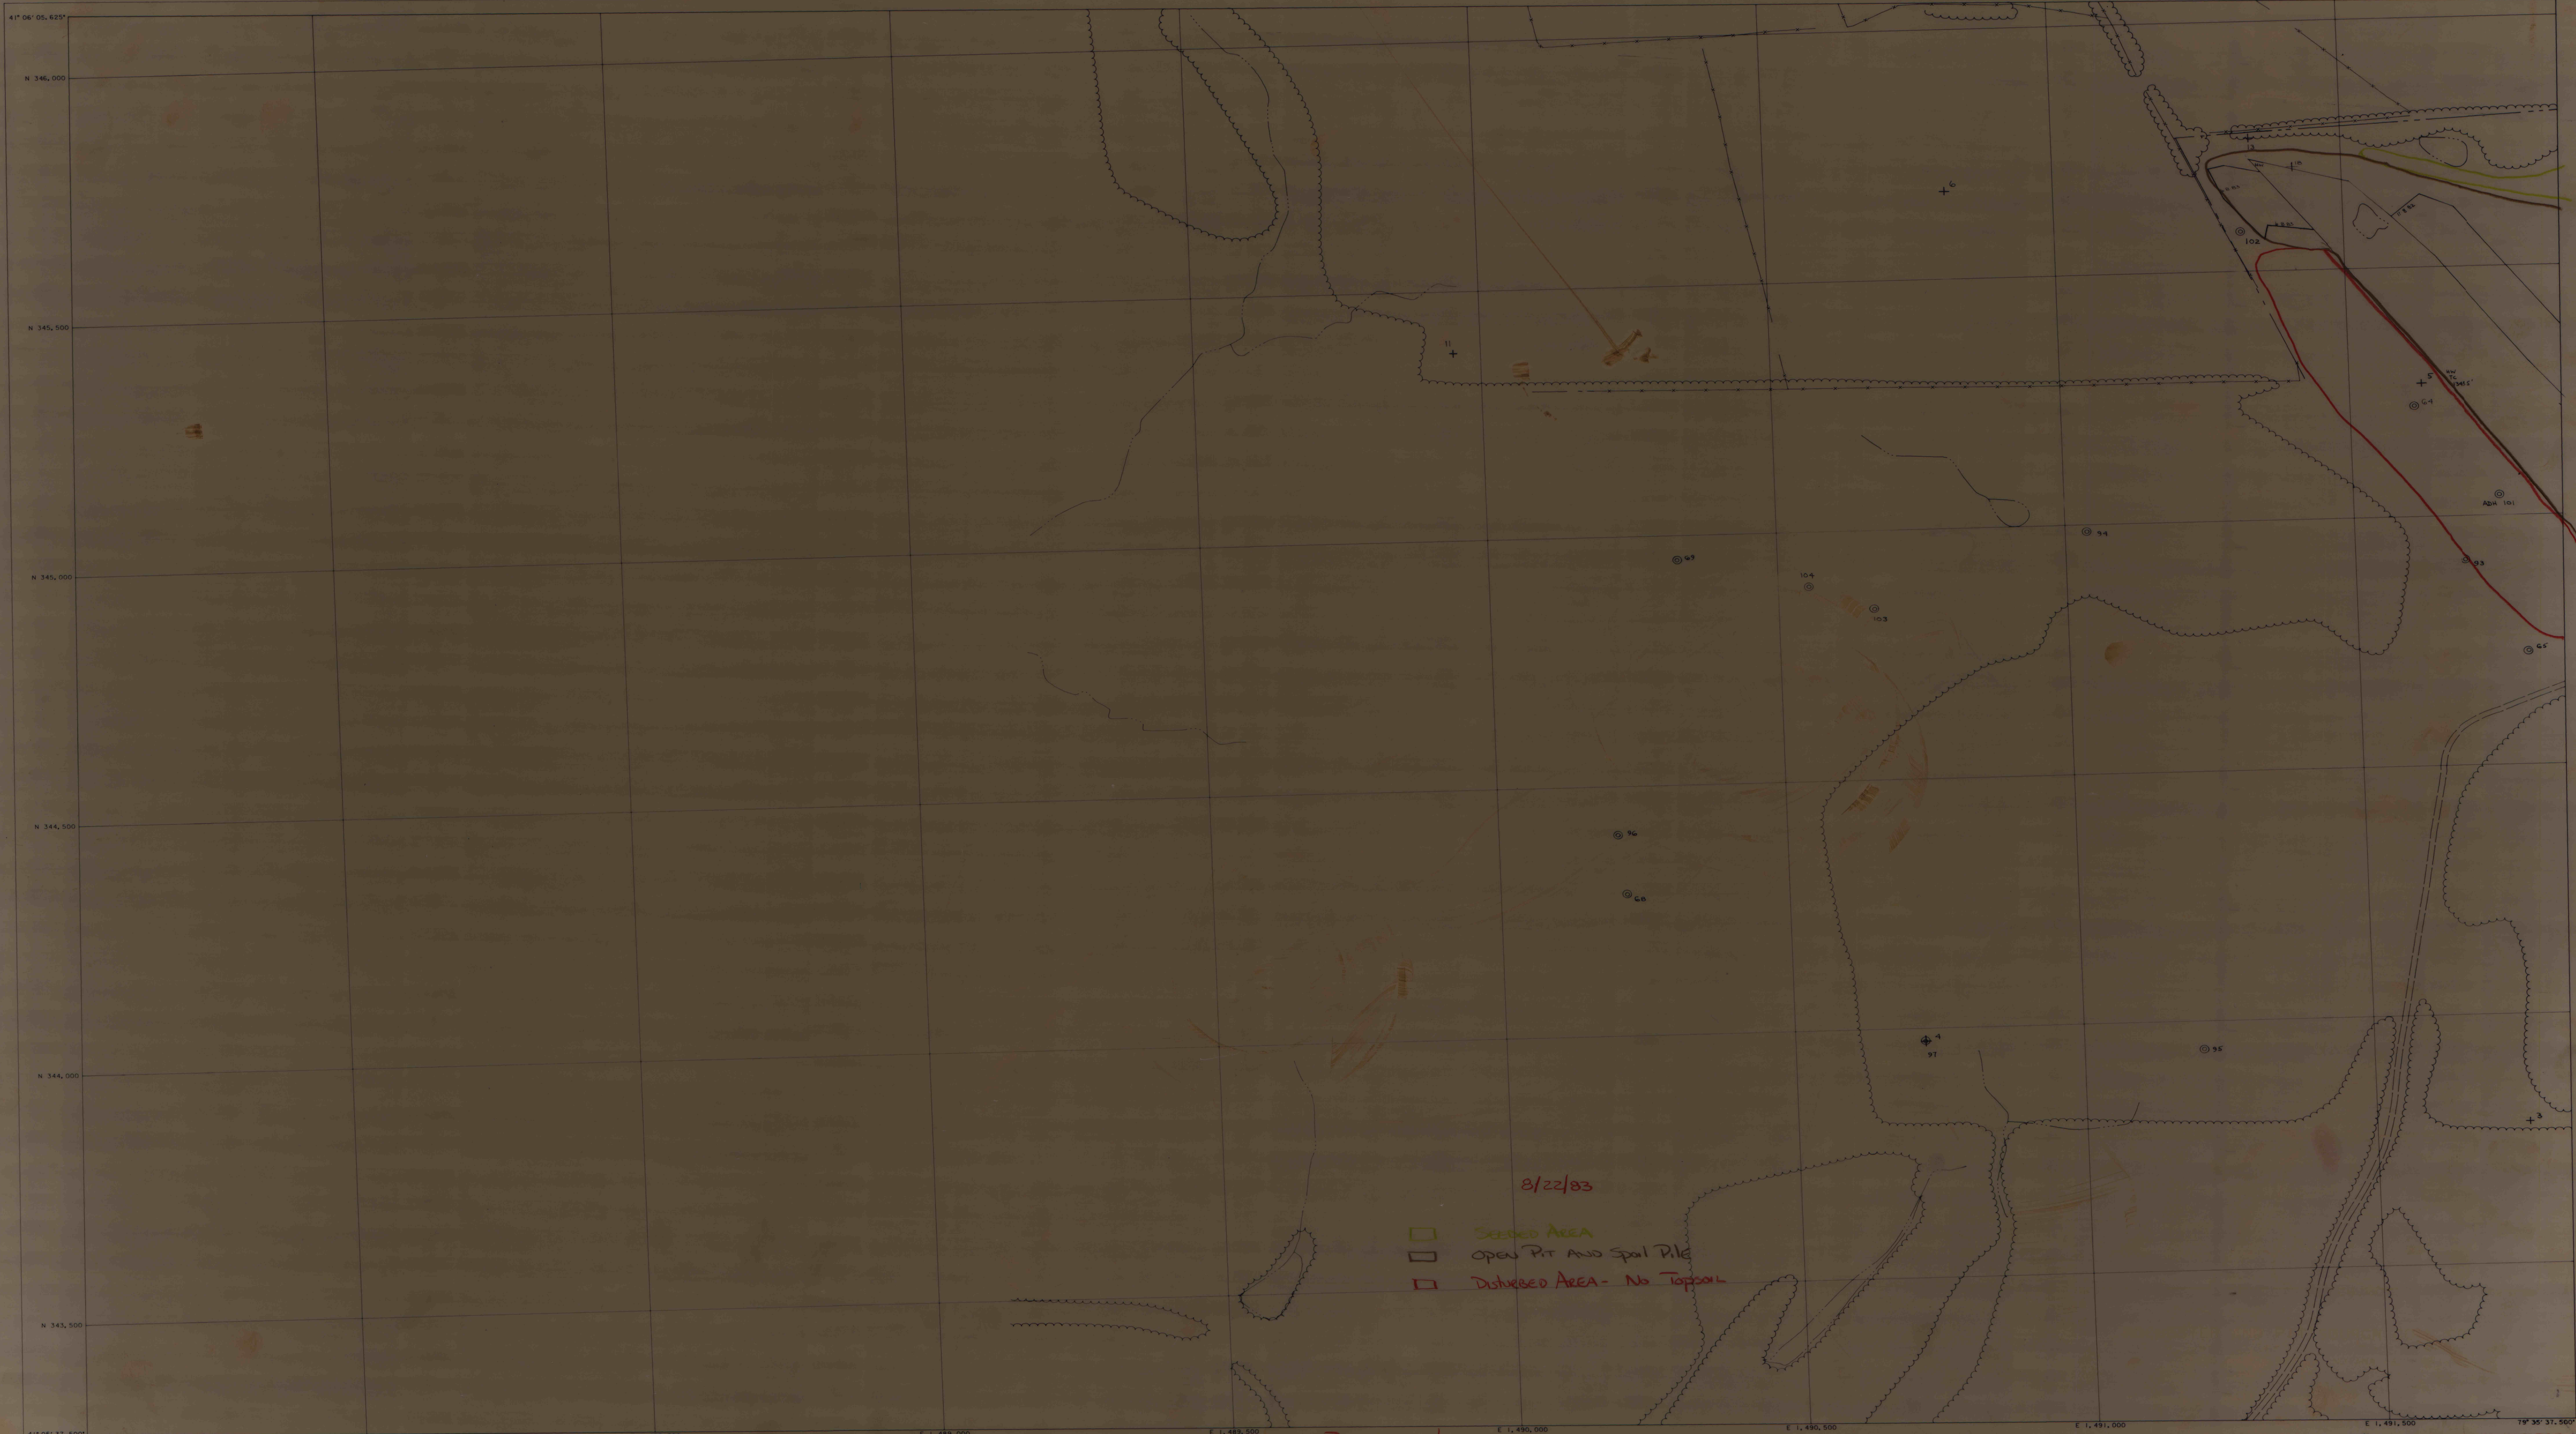

- 8/22/83
- SEEDING AREA
 - OPEN PIT AND SPILL PILE
 - DISTURBED AREA - NO TOPSOIL

LOGUE PIT - BACKFILL & SEEDING MAP