


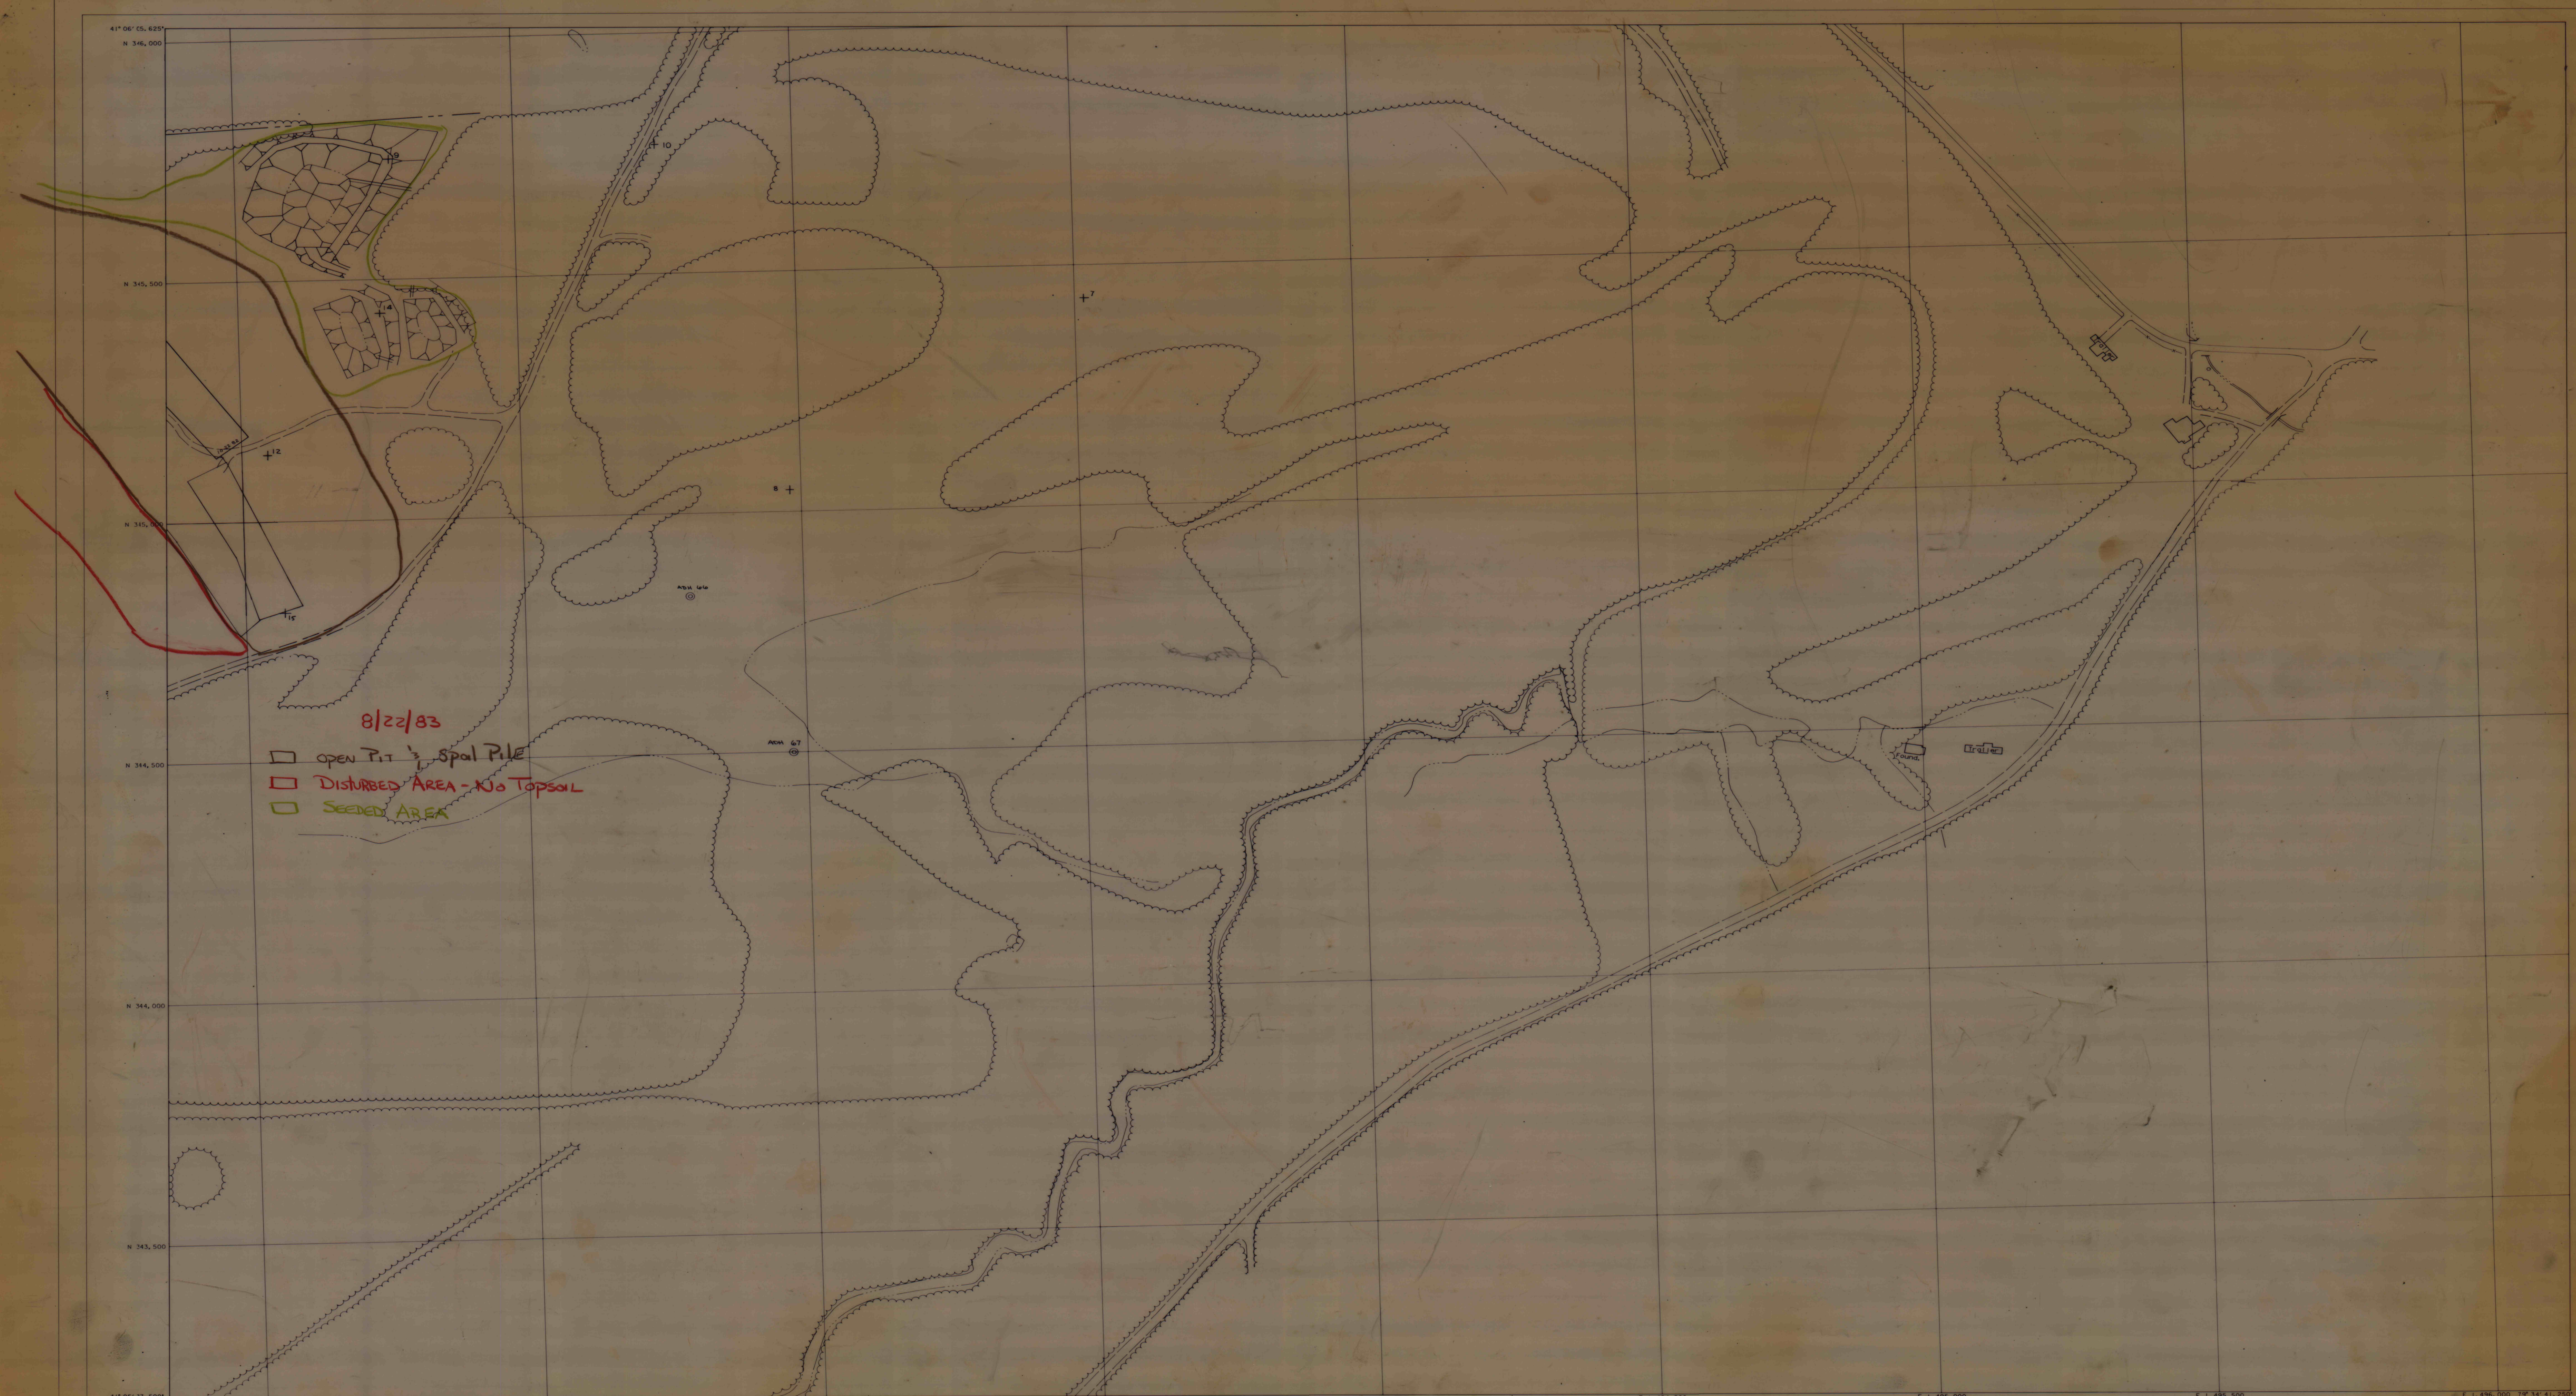

8/22/83
□ OPEN PIT & Spill Pile
□ DISTURBED AREA - NO TOPSOIL
□ SEEDER AREA

LOGUE PIT - BACKFILL & SEEDER MAP

1" = 100' 10928-19 115