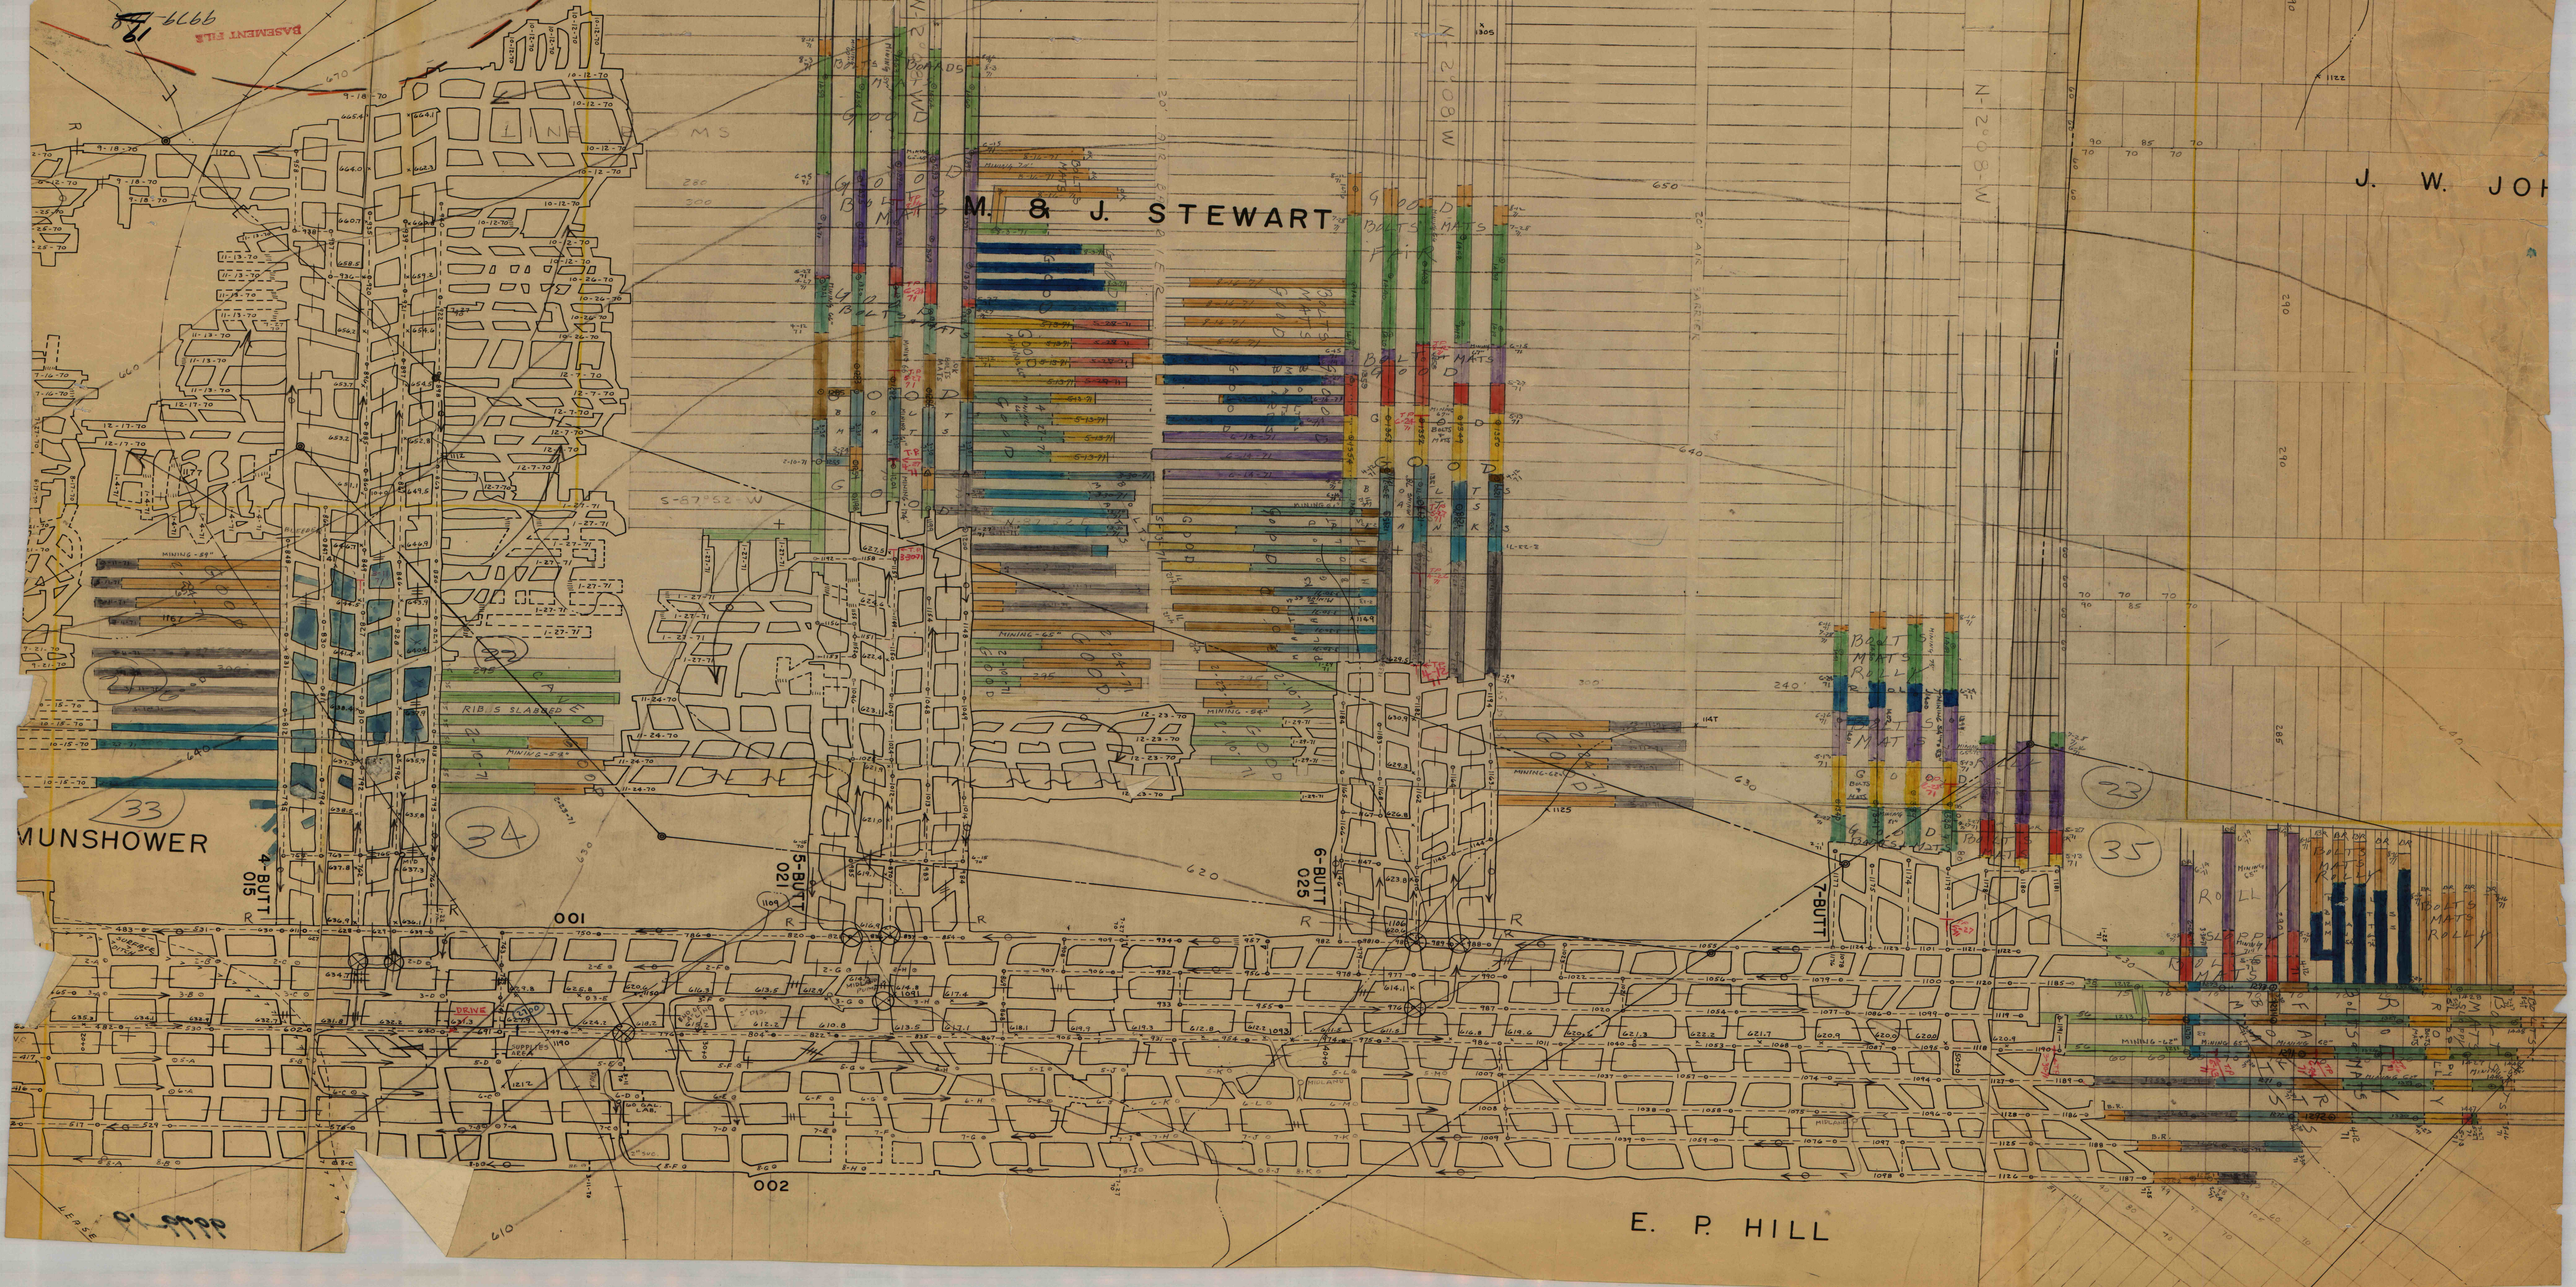
M. & J. STEWART
J. W. JOH
MUNSHOWER
E. P. HILL
4-BUTT
015
5-BUTT
021
6-BUTT
025
7-BUTT
001
002
33
34
35
23
RIBS SLABBED
GOOD BOLTS
GOOD MATS
BOLTS
MATS
ROLLY
N-20°08'-W
S-87°52'-W
BASEMENT FILE