


R. WHITESELL

PHILIP WHITESELL

GEO. PALMER

THEOPHILUS PANTALL

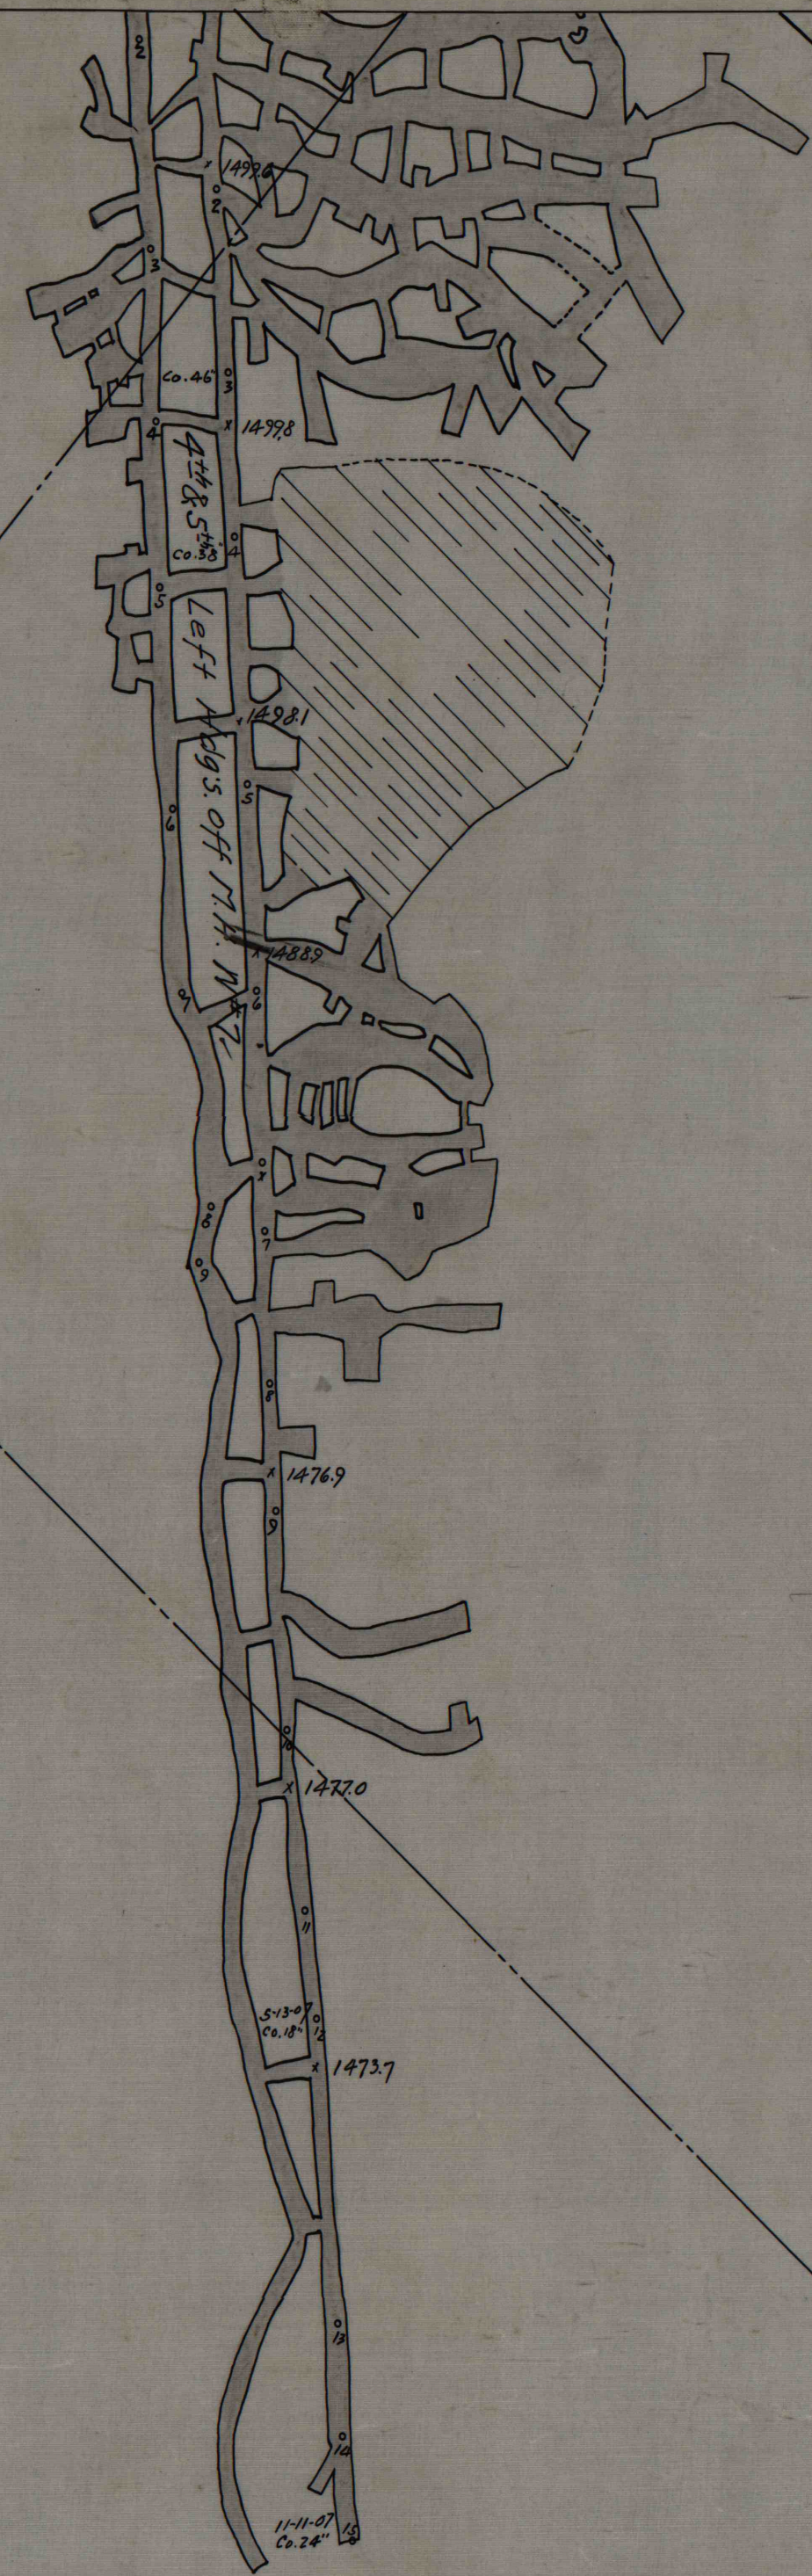

out crop