


Map
 OF
LONDON MINE
 OWNED and OPERATED
 BY
THE FALLS CREEK MINING Co.
 F.M. Brown Eng
 1892

From 1891
 During 1891
 During 1892
 During 1893
 During 1894
 During 1895

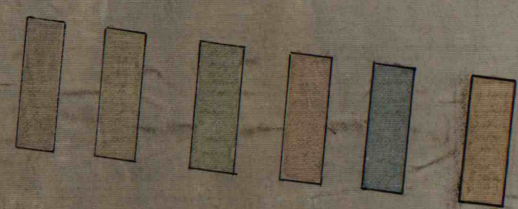

WORKED OUT

THE CENTRAL LAND and MINING Co.

THE CENTRAL LAND and MINING Co.

B-199A-3

B-199A-3