


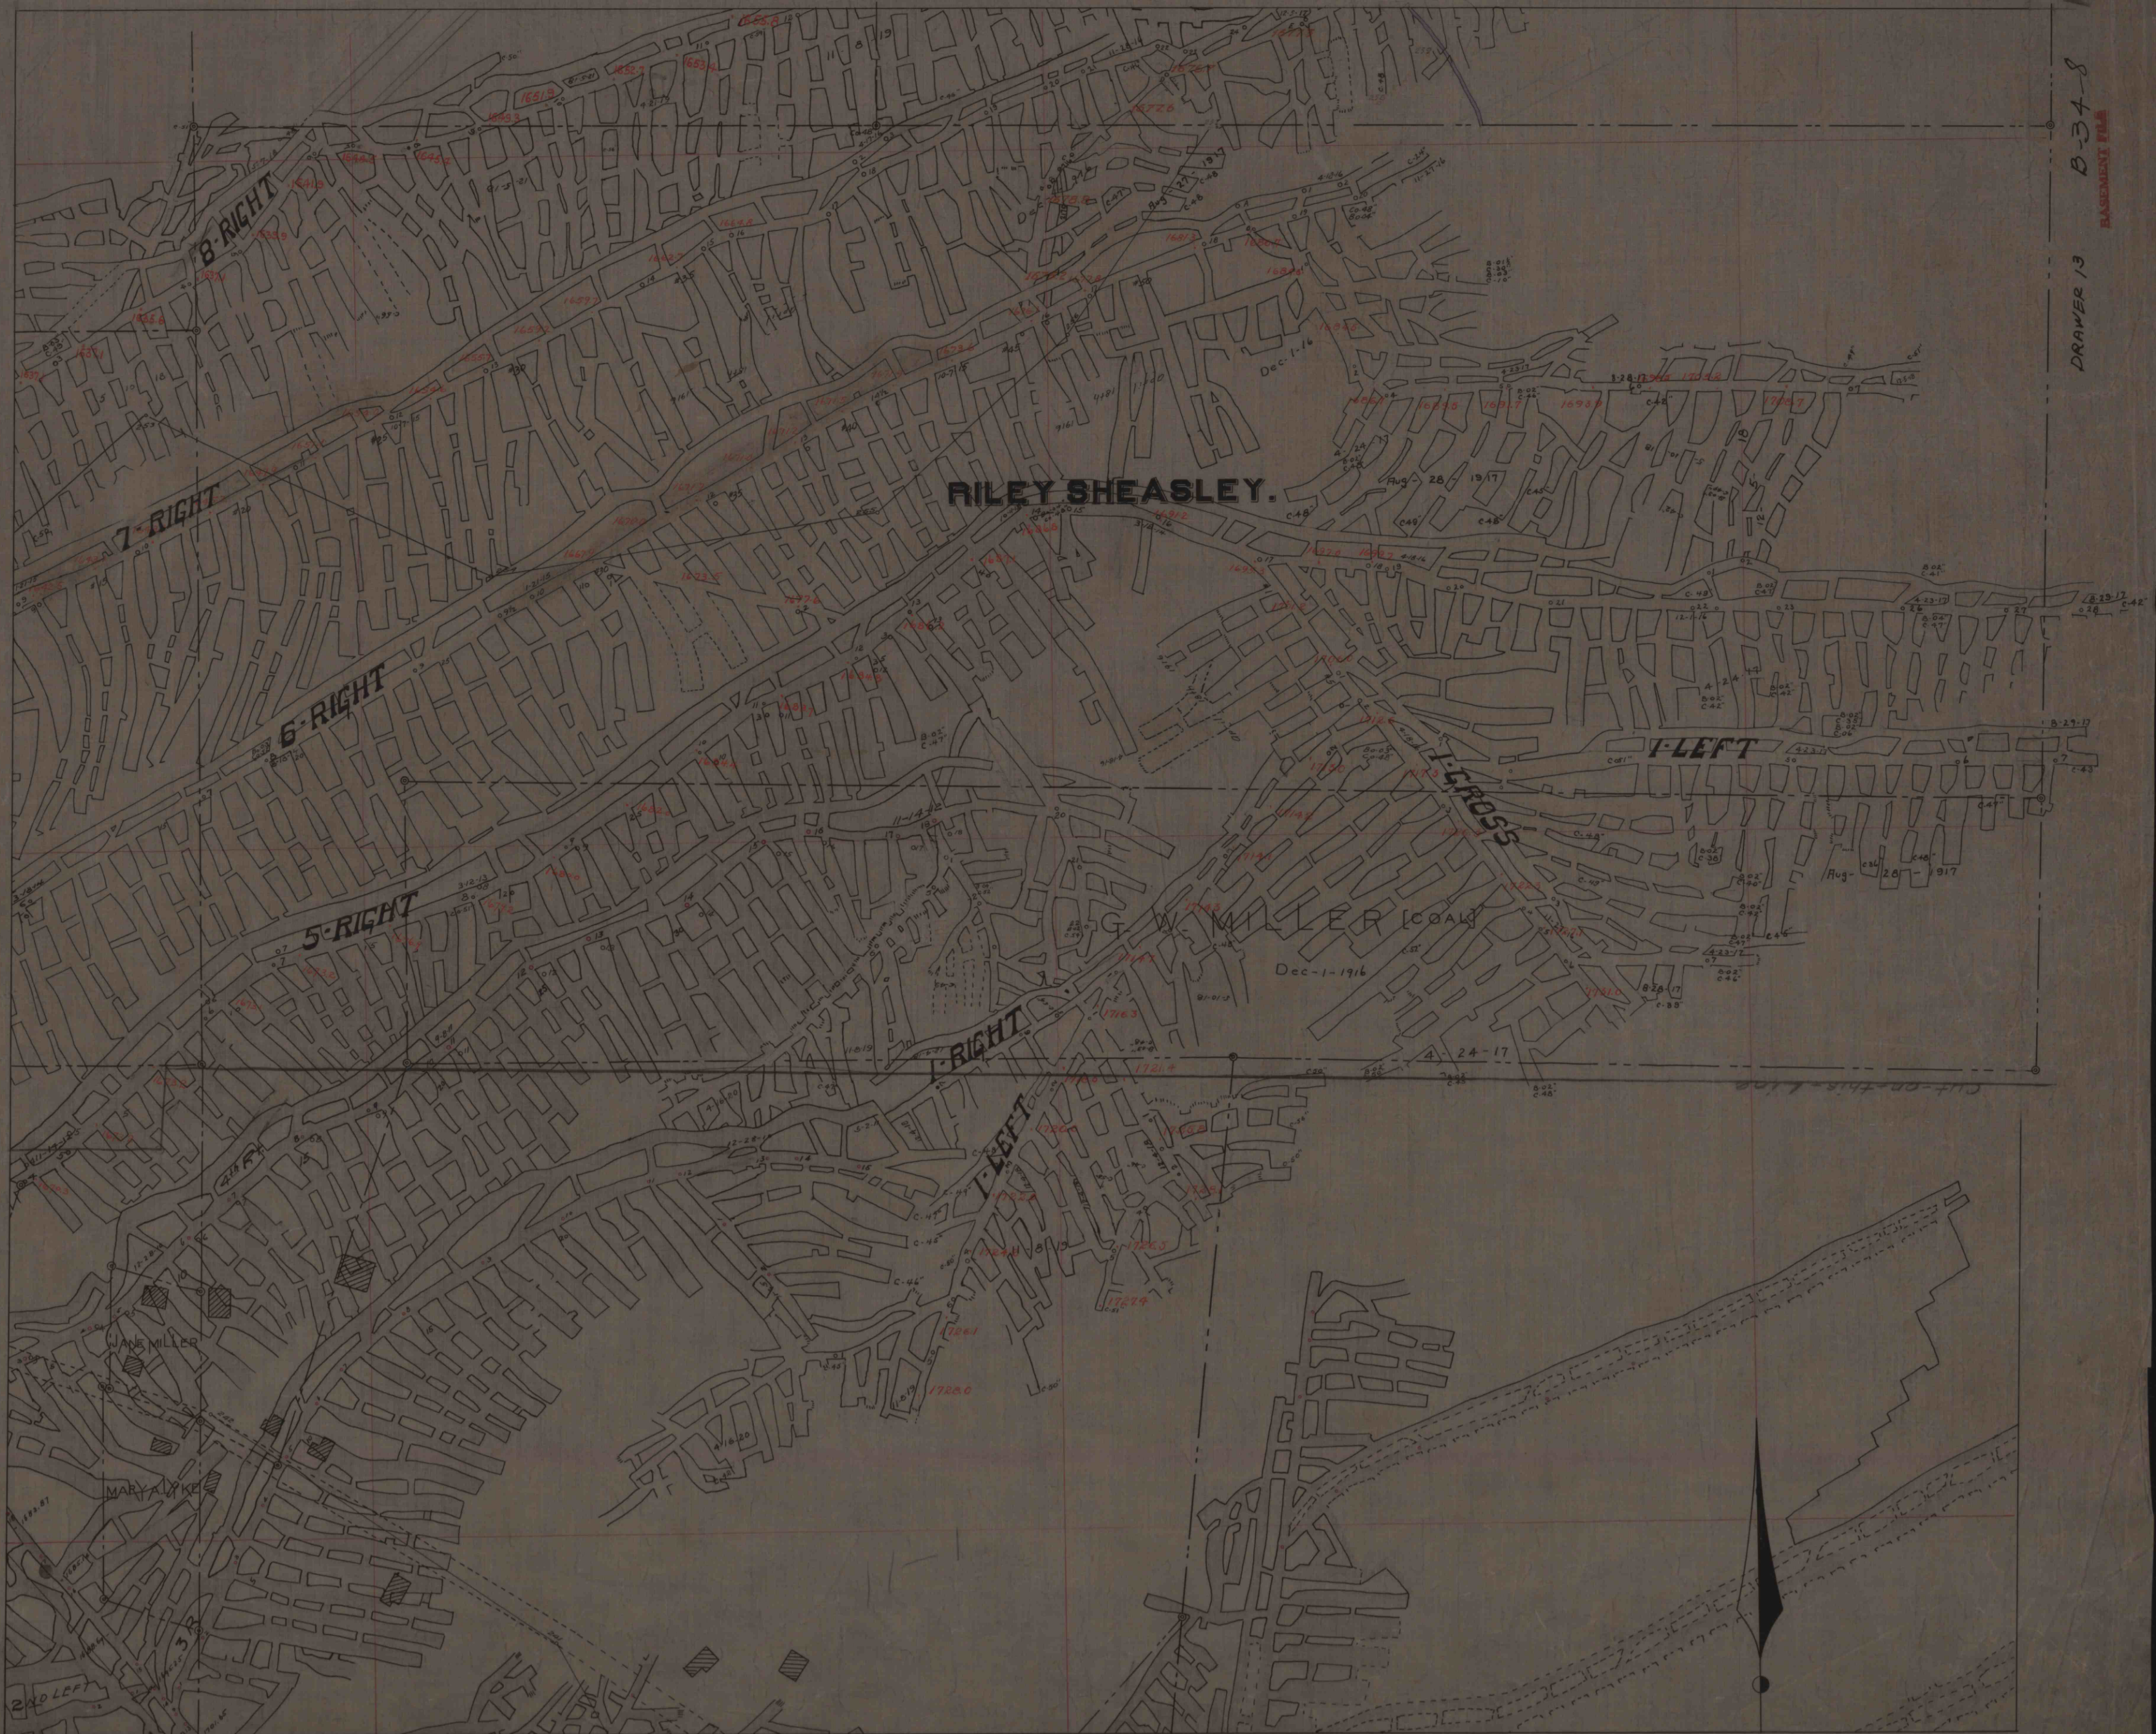

B-34-8
DRAWER 13
BASEMENT FILE

B-34-8
DRAWER 13
BASEMENT FILE