


B-34-9
DRAWER 13

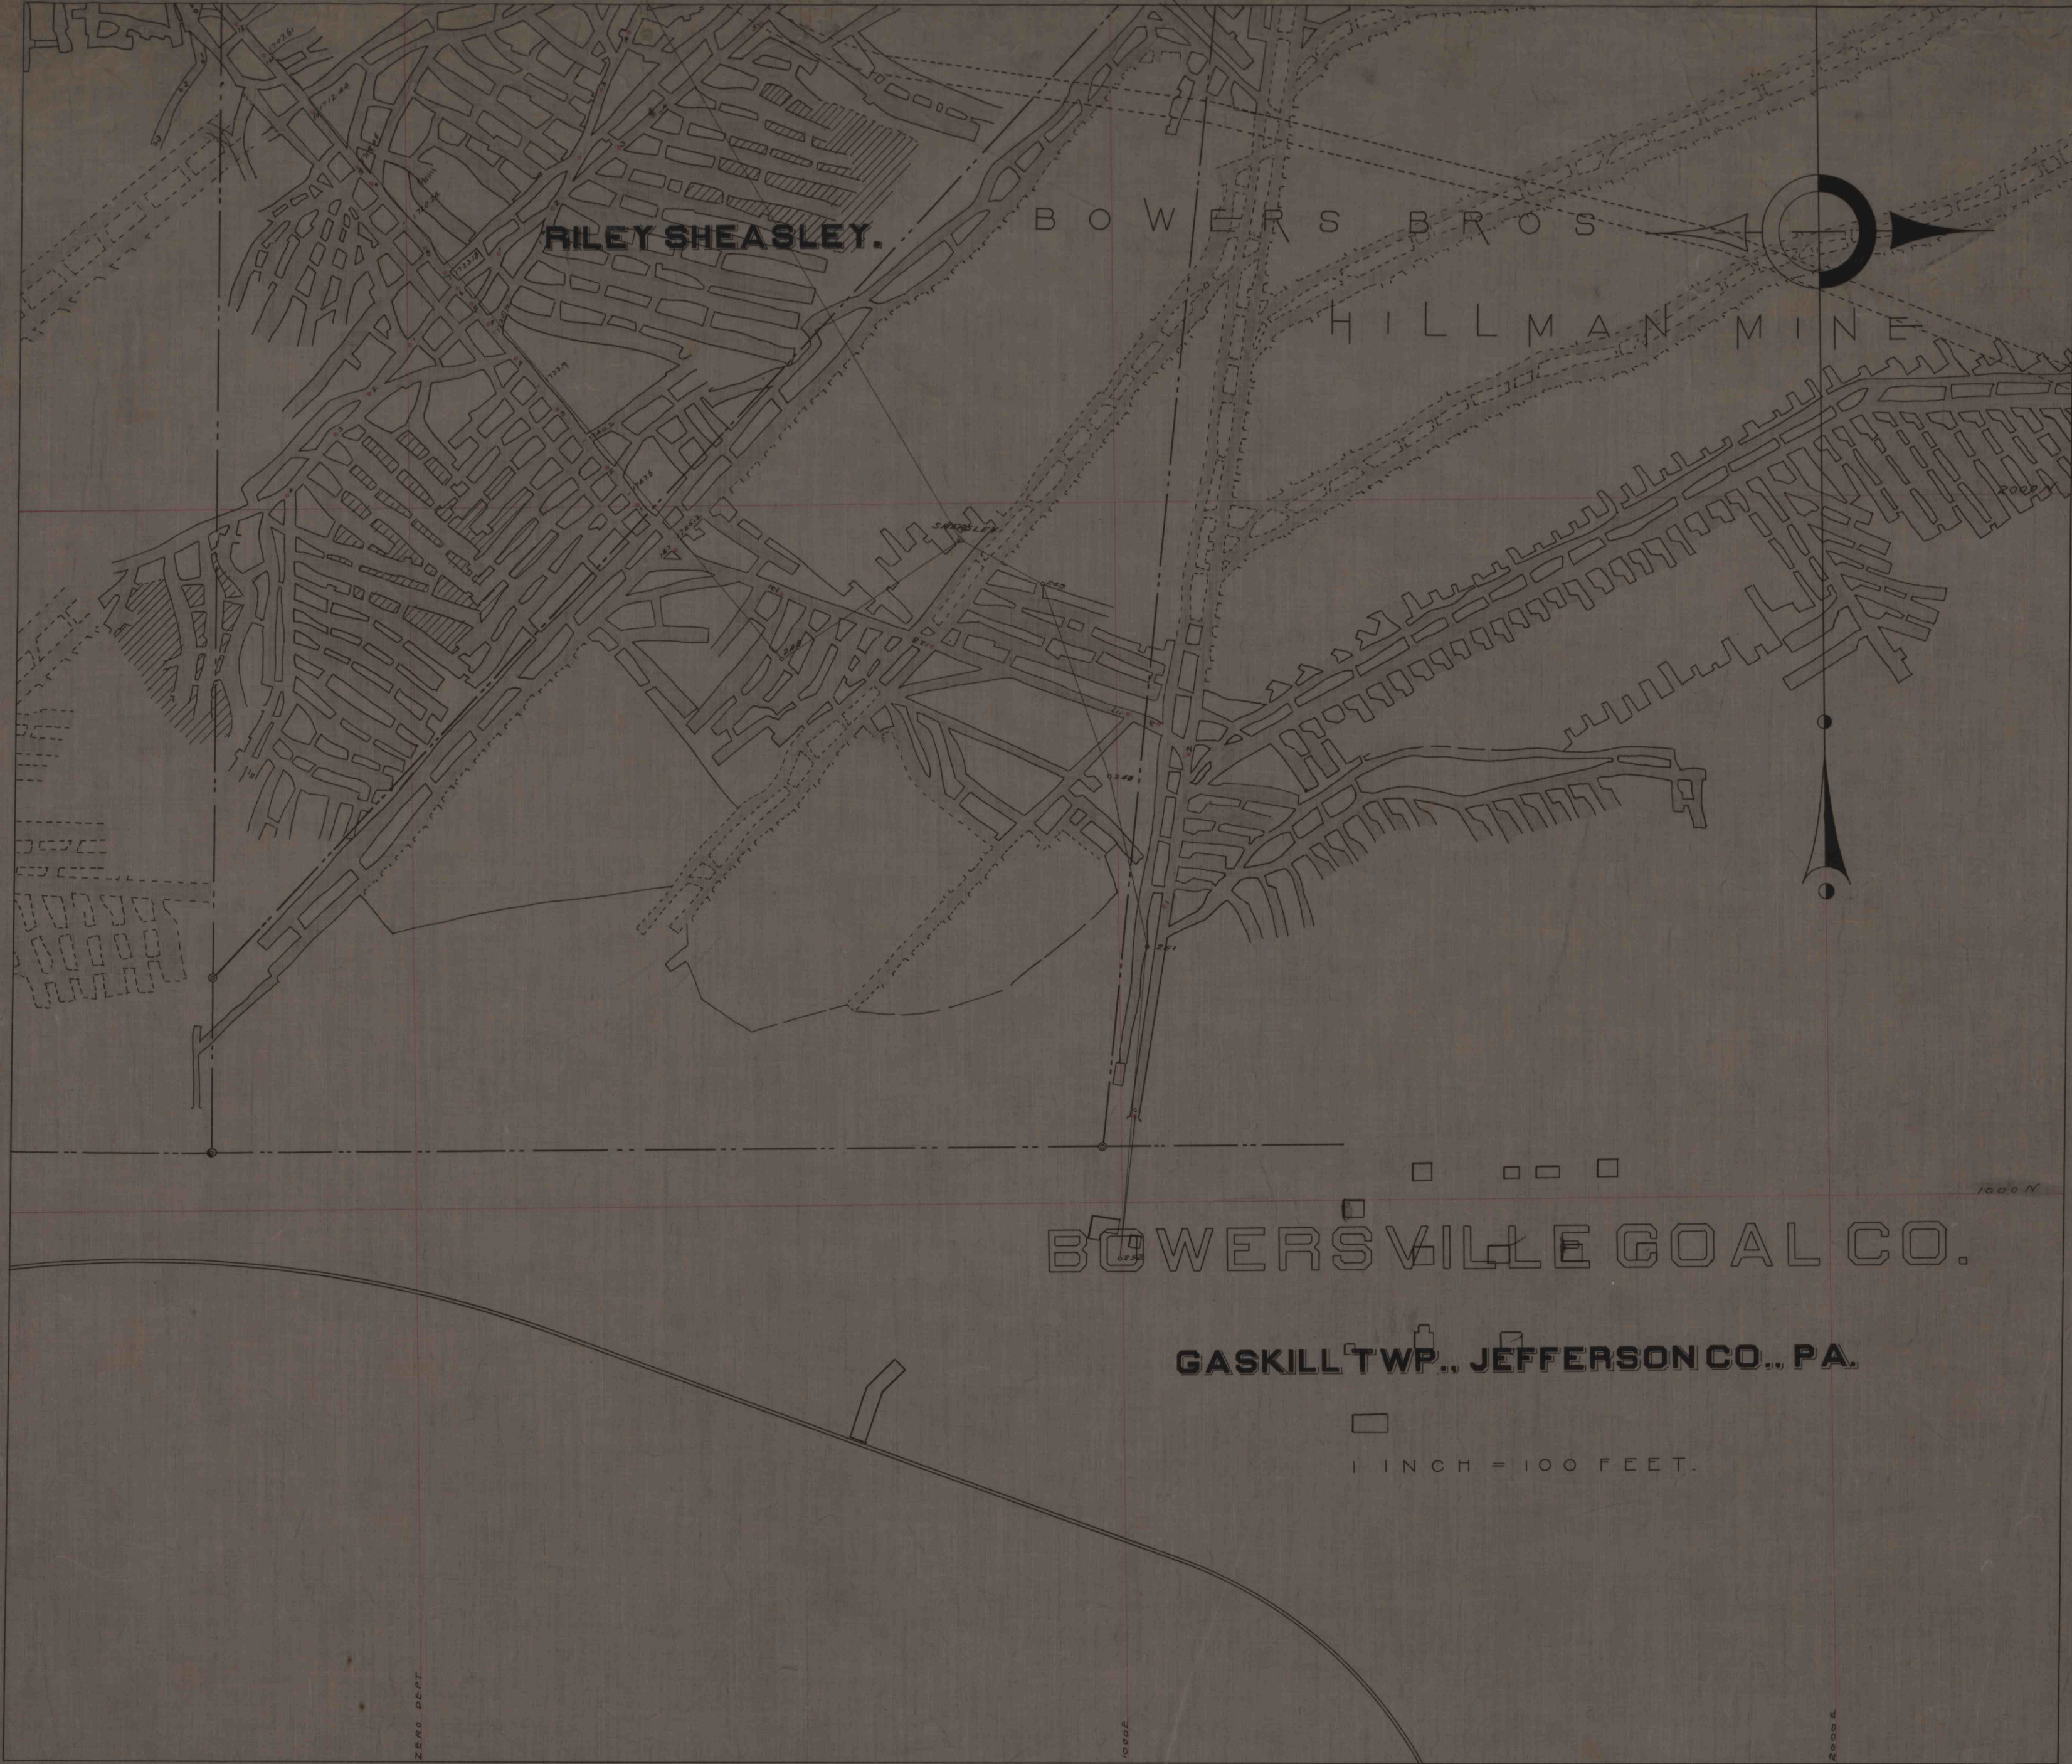

DRAWER 13
B-34-9

2