

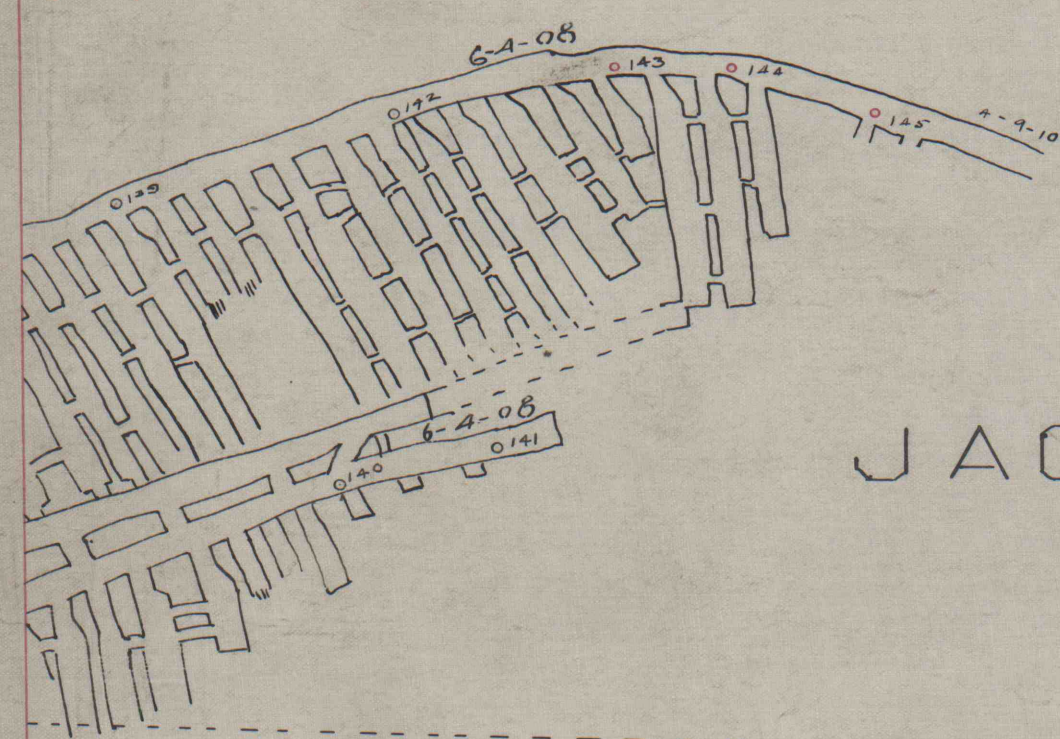


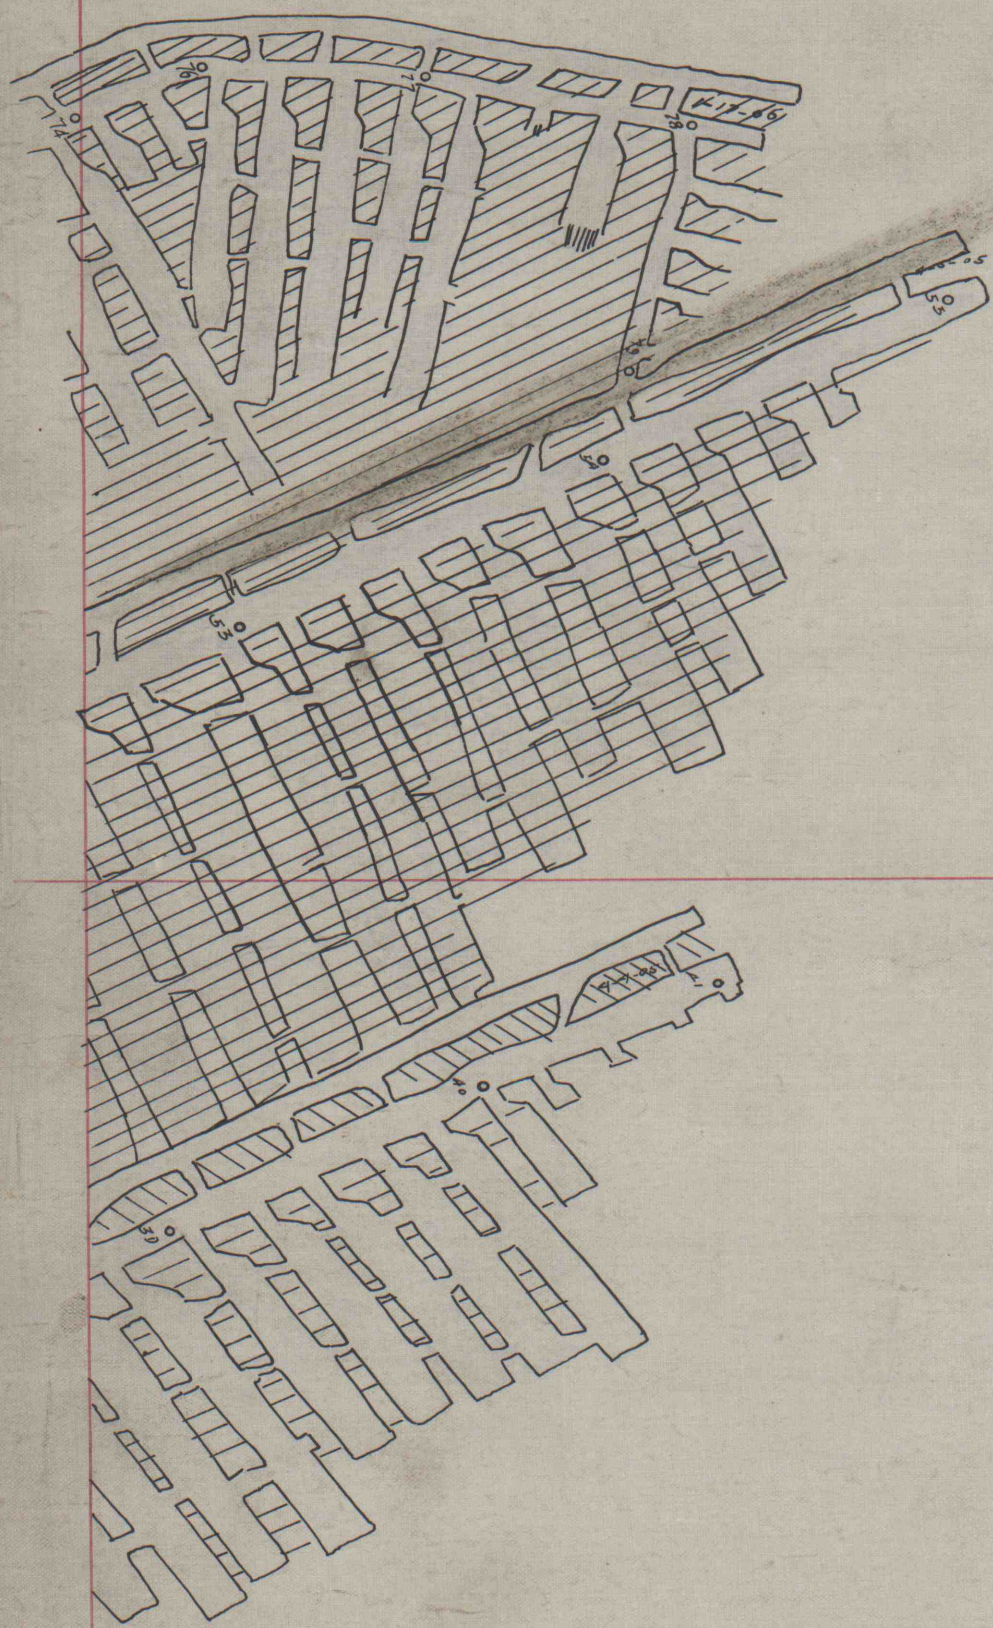

JACOB BOWSER

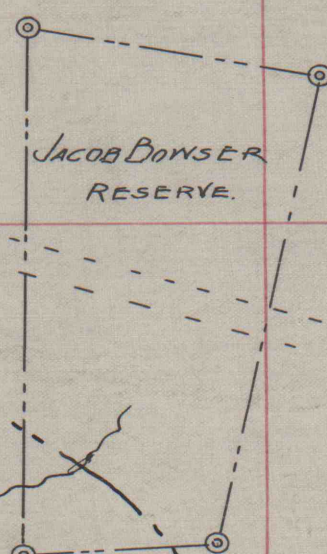

OUTCROP

spring run

Drill Hole

Drill Hole

IS BROS

N MINE

= ONE INCH

DAVID F. BOWSER