


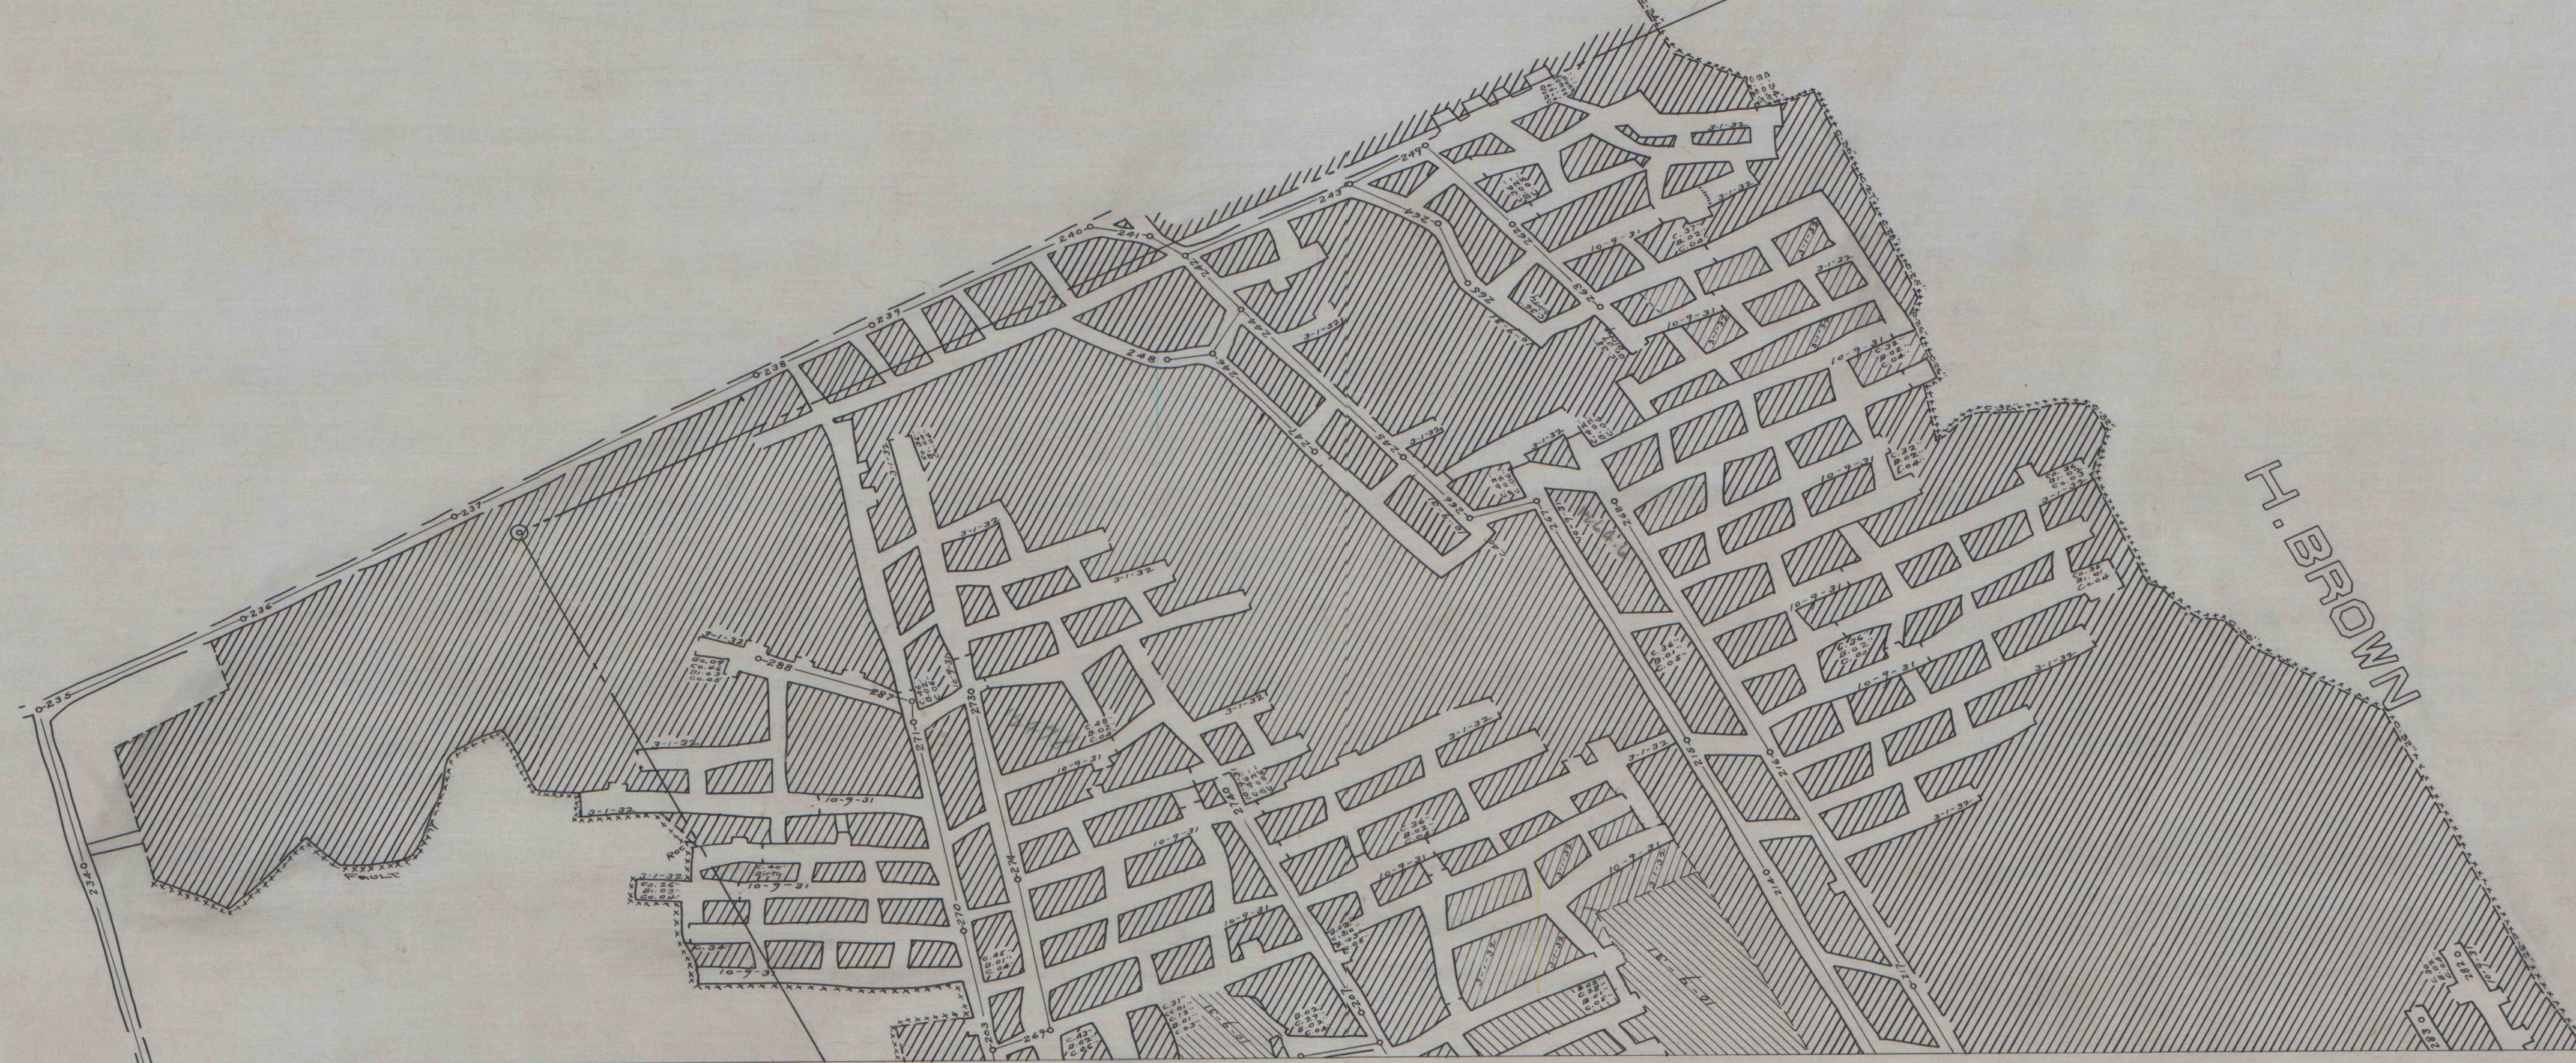

A. Read

A. M.

McClure Est

Drawer-# 11

B & S. Cascade

36