


B-31-35C
DRAWN BY

2400000000

(COUNTY LINE)

LEGEND			
A PREVIOUS TO JAN. 1912			
B Jan. 1912	B ₁ January 1914	B ₂ January - 1916	B ₃ January 1918
C FEB. "	C ₁ February 1914	C ₂ February - "	C ₃ Feb. "
D MAR. "	D ₁ March 1914	D ₂ March - "	D ₃ Mar. "
E APR. "	E ₁ April "	E ₂ April - "	E ₃ Apr. "
F MAY "	F ₁ May "	F ₂ May - "	F ₃ May "
G JUN. "	G ₁ June "	G ₂ June - "	G ₃ June "
H JULY "	H ₁ July "	H ₂ July - "	H ₃ July "
I AUG. "	I ₁ August "	I ₂ August - "	I ₃ Aug. "
J SEP. "	J ₁ September "	J ₂ September "	
K OCT. "	K ₁ October "	K ₂ October "	
L NOV. "	L ₁ November "	L ₂ November "	
M DEC. "	M ₁ December "	M ₂ December "	
N Jan. 1913	N ₁ January 1915	N ₂ January "	
O Feb. "	O ₁ February "	O ₂ February 1917	
P March "	P ₁ March "	P ₂ March "	
Q April "	Q ₁ April "	Q ₂ April "	
R May "	R ₁ May "	R ₂ May "	
S June "	S ₁ June "	S ₂ June "	
T July "	T ₁ July "	T ₂ July "	
U August "	U ₁ August "	U ₂ August "	
V September "	V ₁ September "	V ₂ September "	
W October "	W ₁ October "	W ₂ October "	
X November "	X ₁ November "	X ₂ November "	
Y December "	Y ₁ December "	Y ₂ December "	

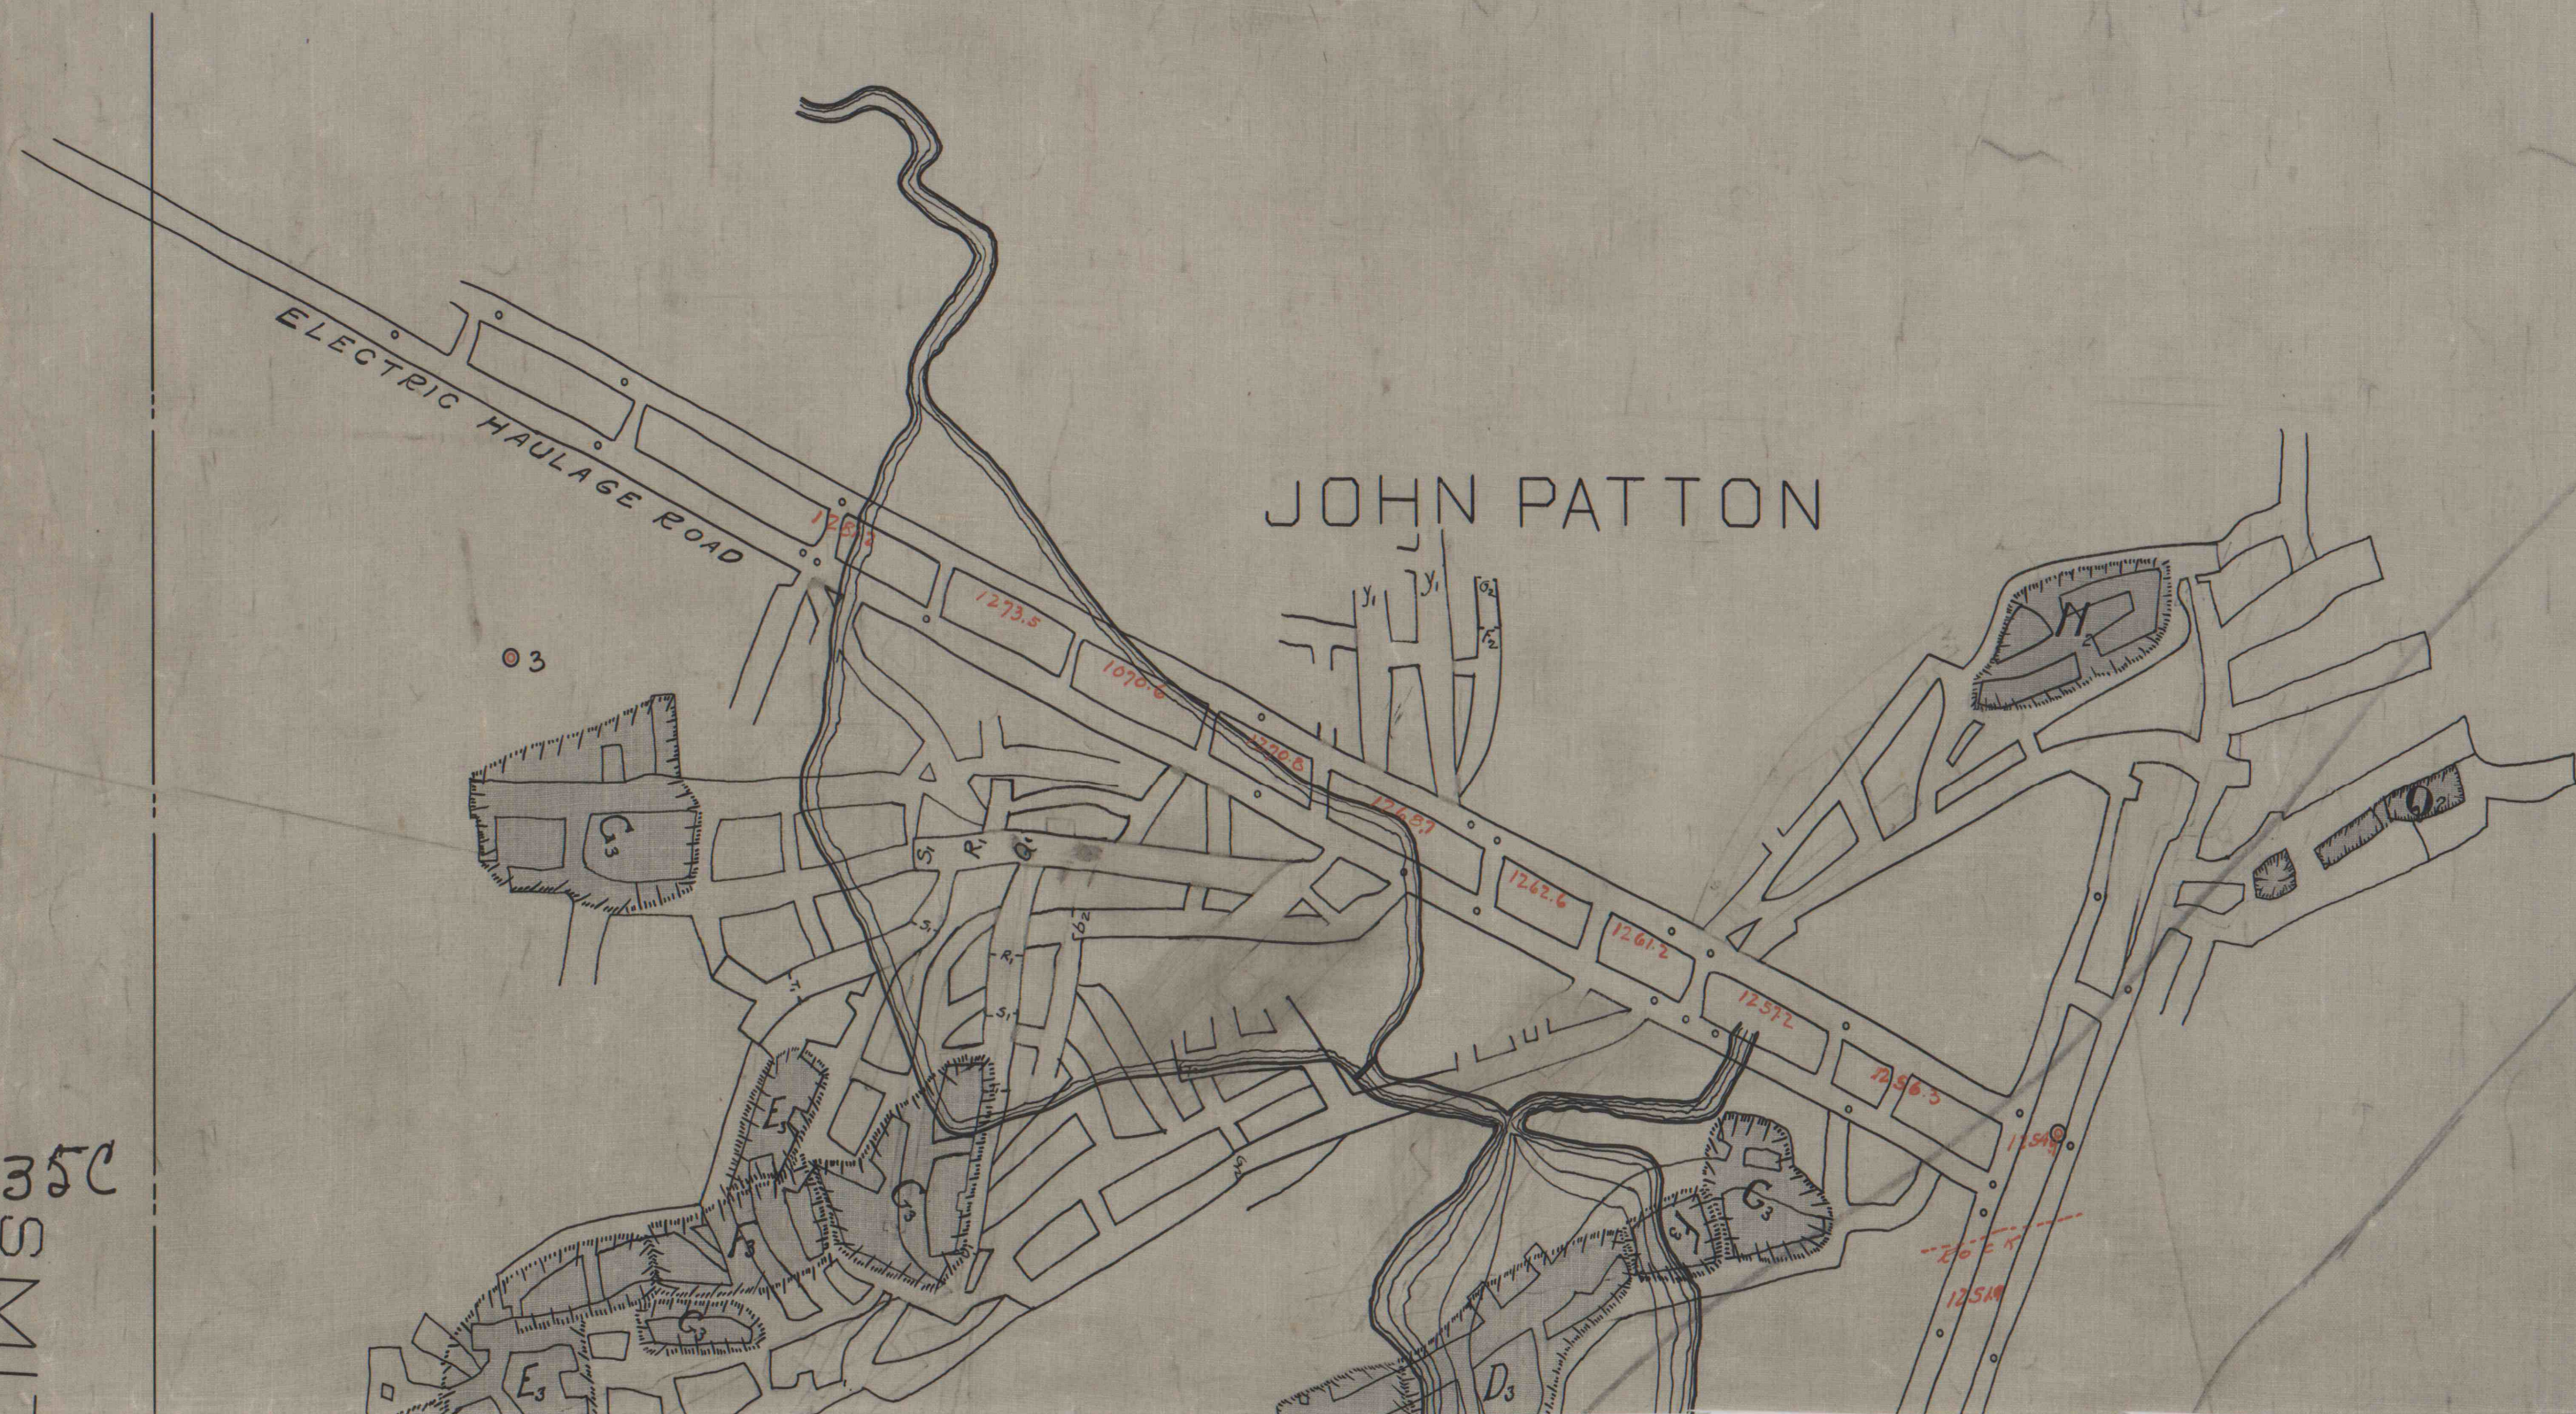

B-31-35C
SMITH