


DRAWER 11 B-28-16

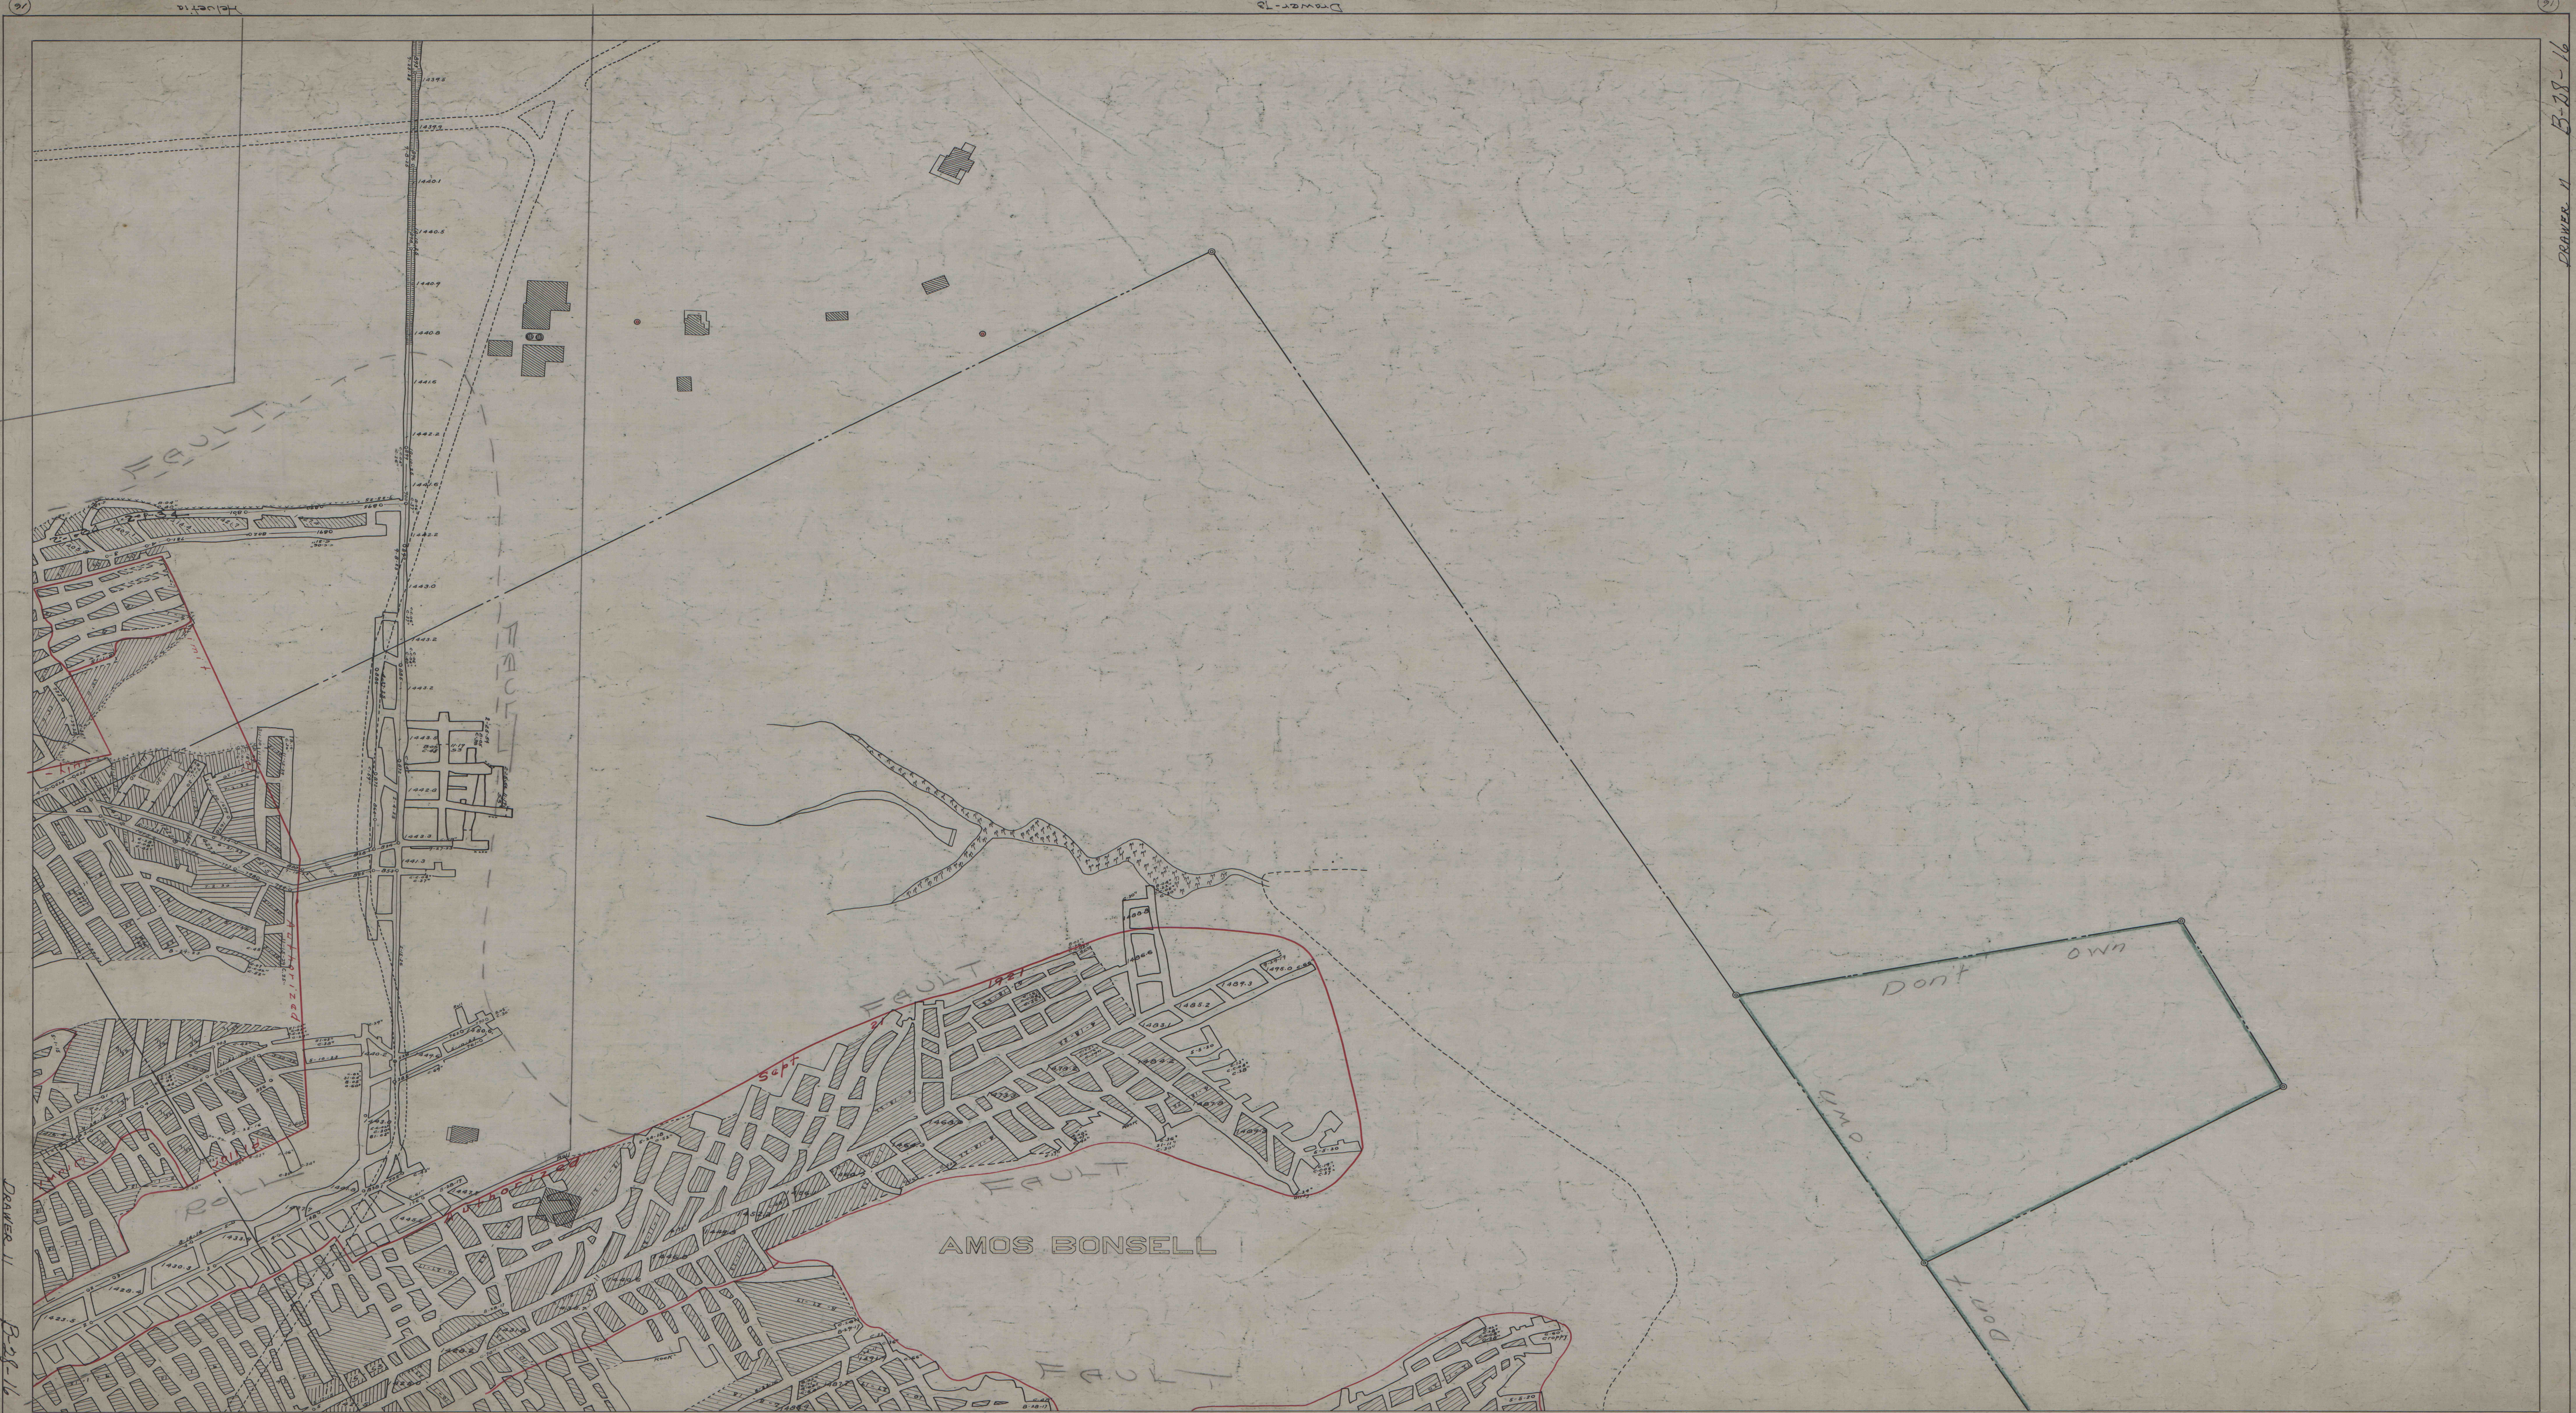

DRAWER 11 B-28-16