


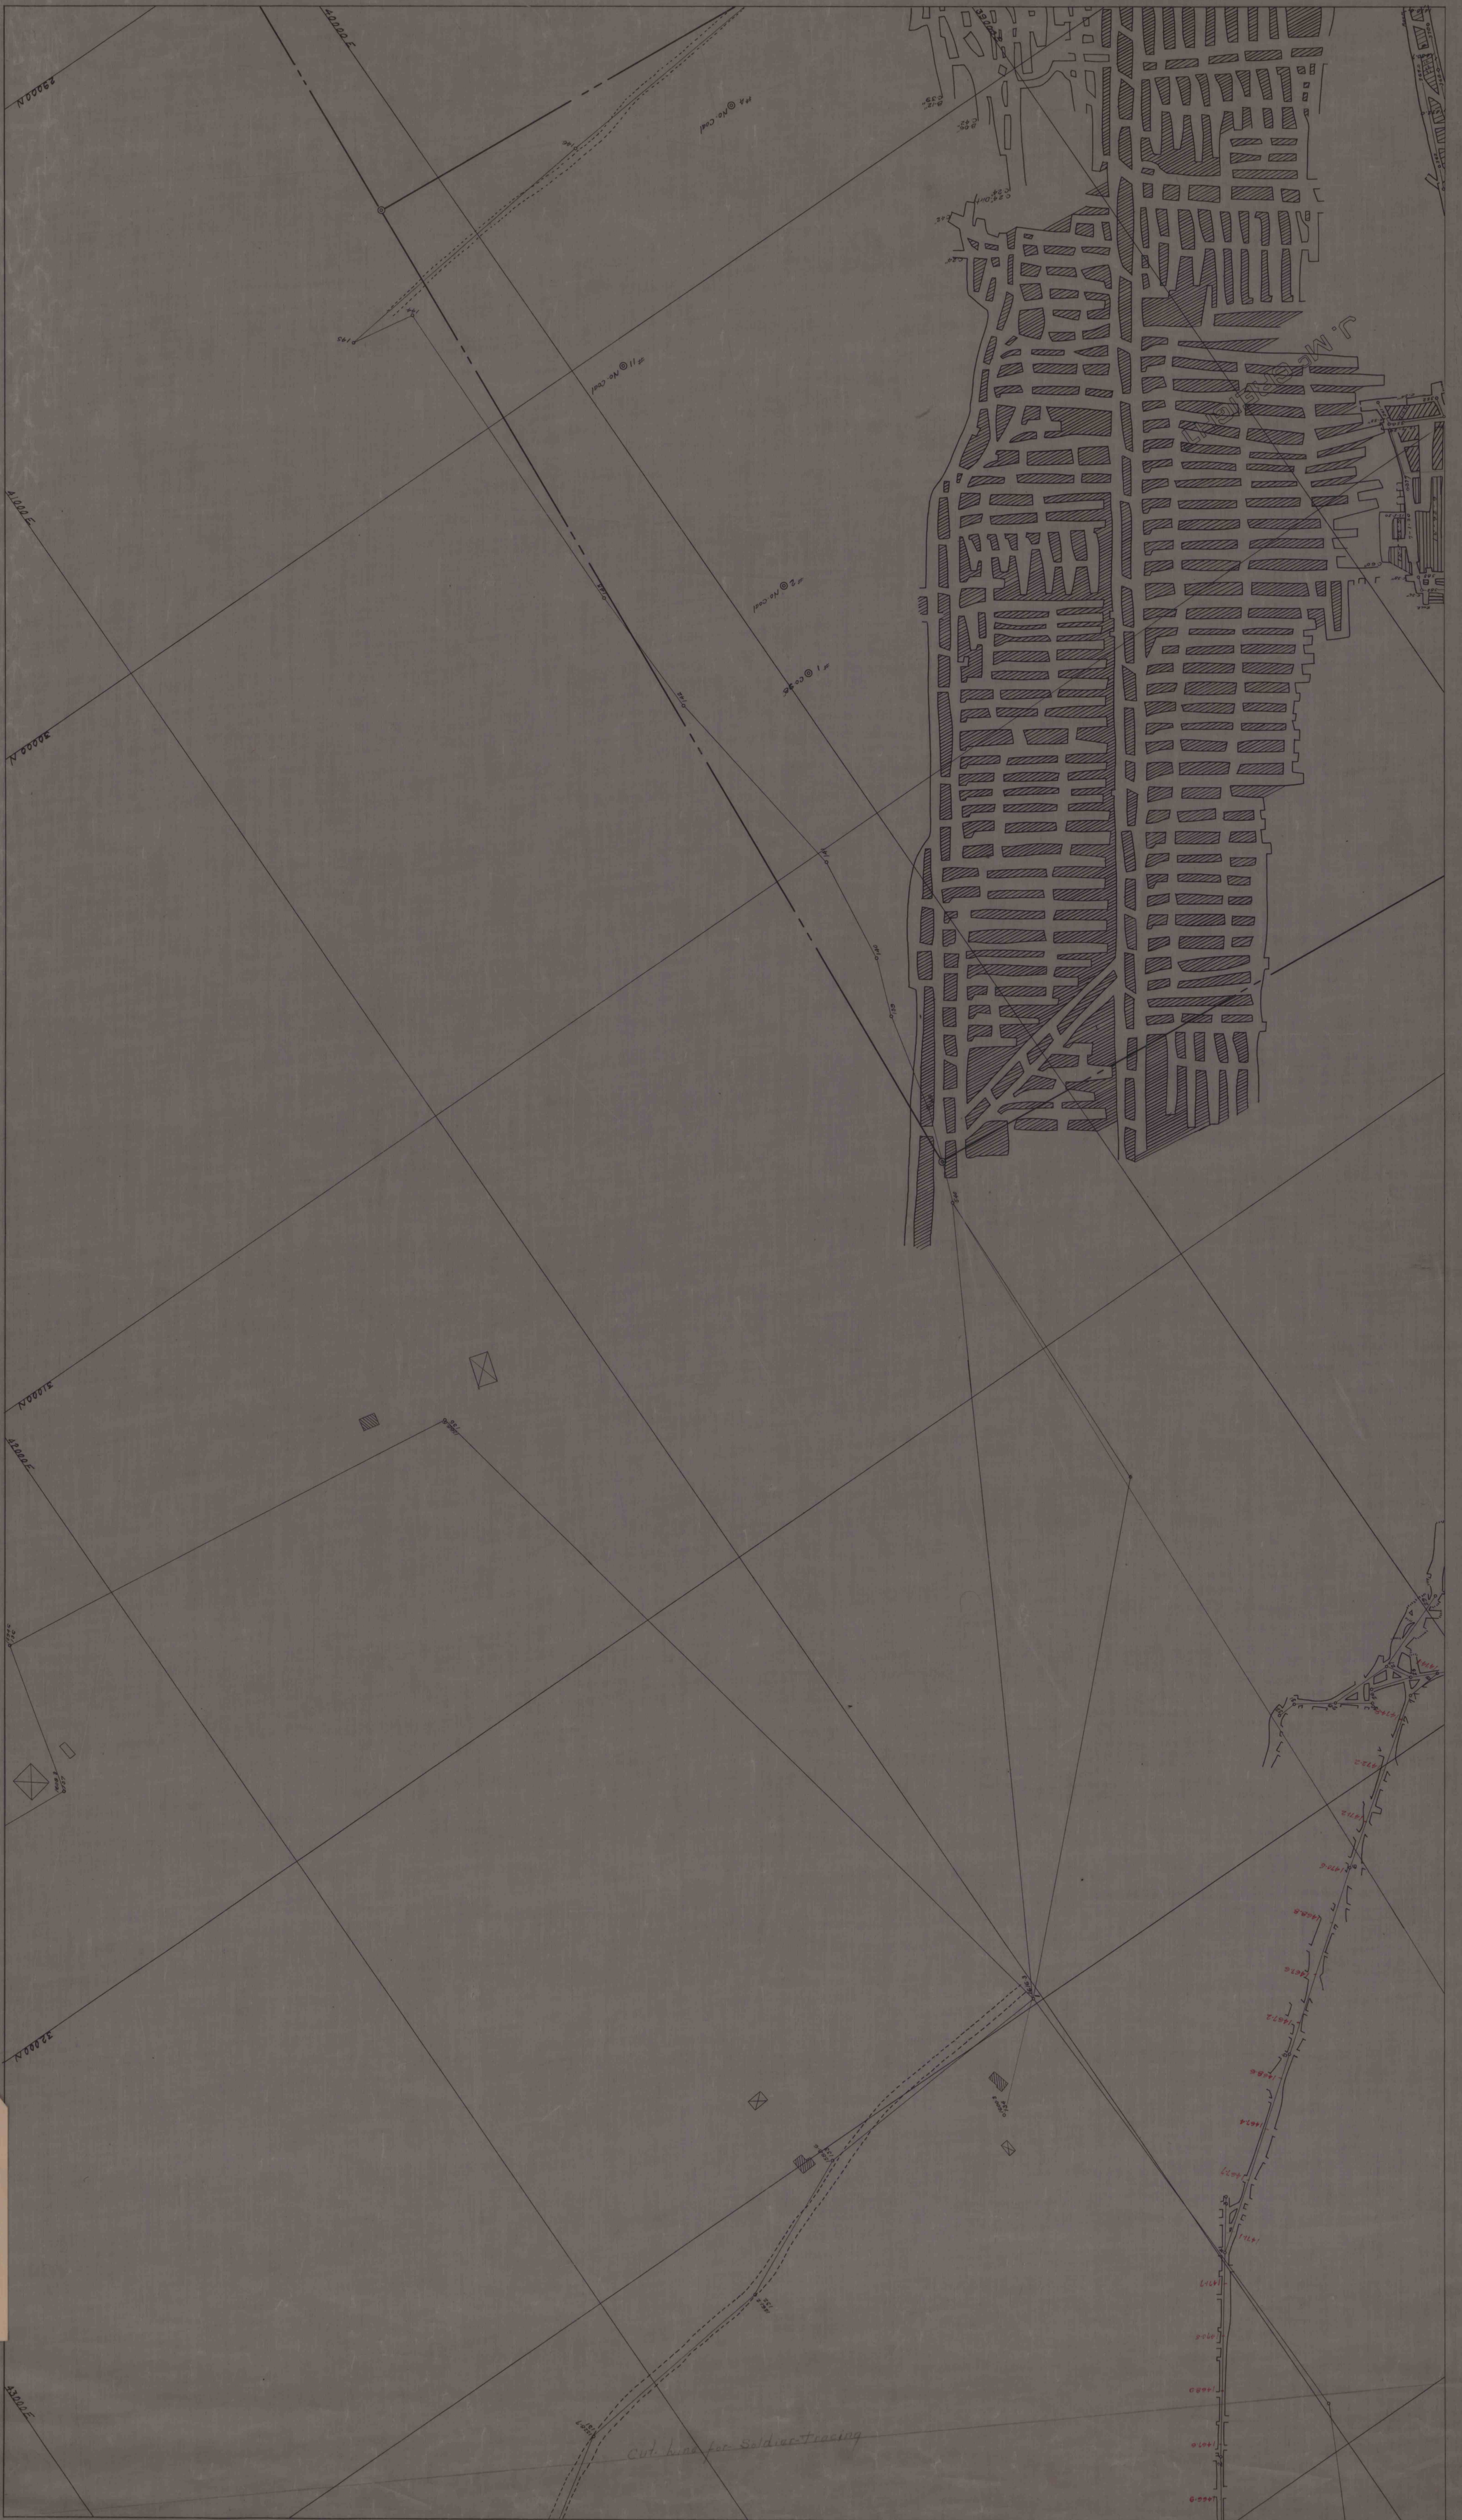

B-36-6
B-DRAWER 14