


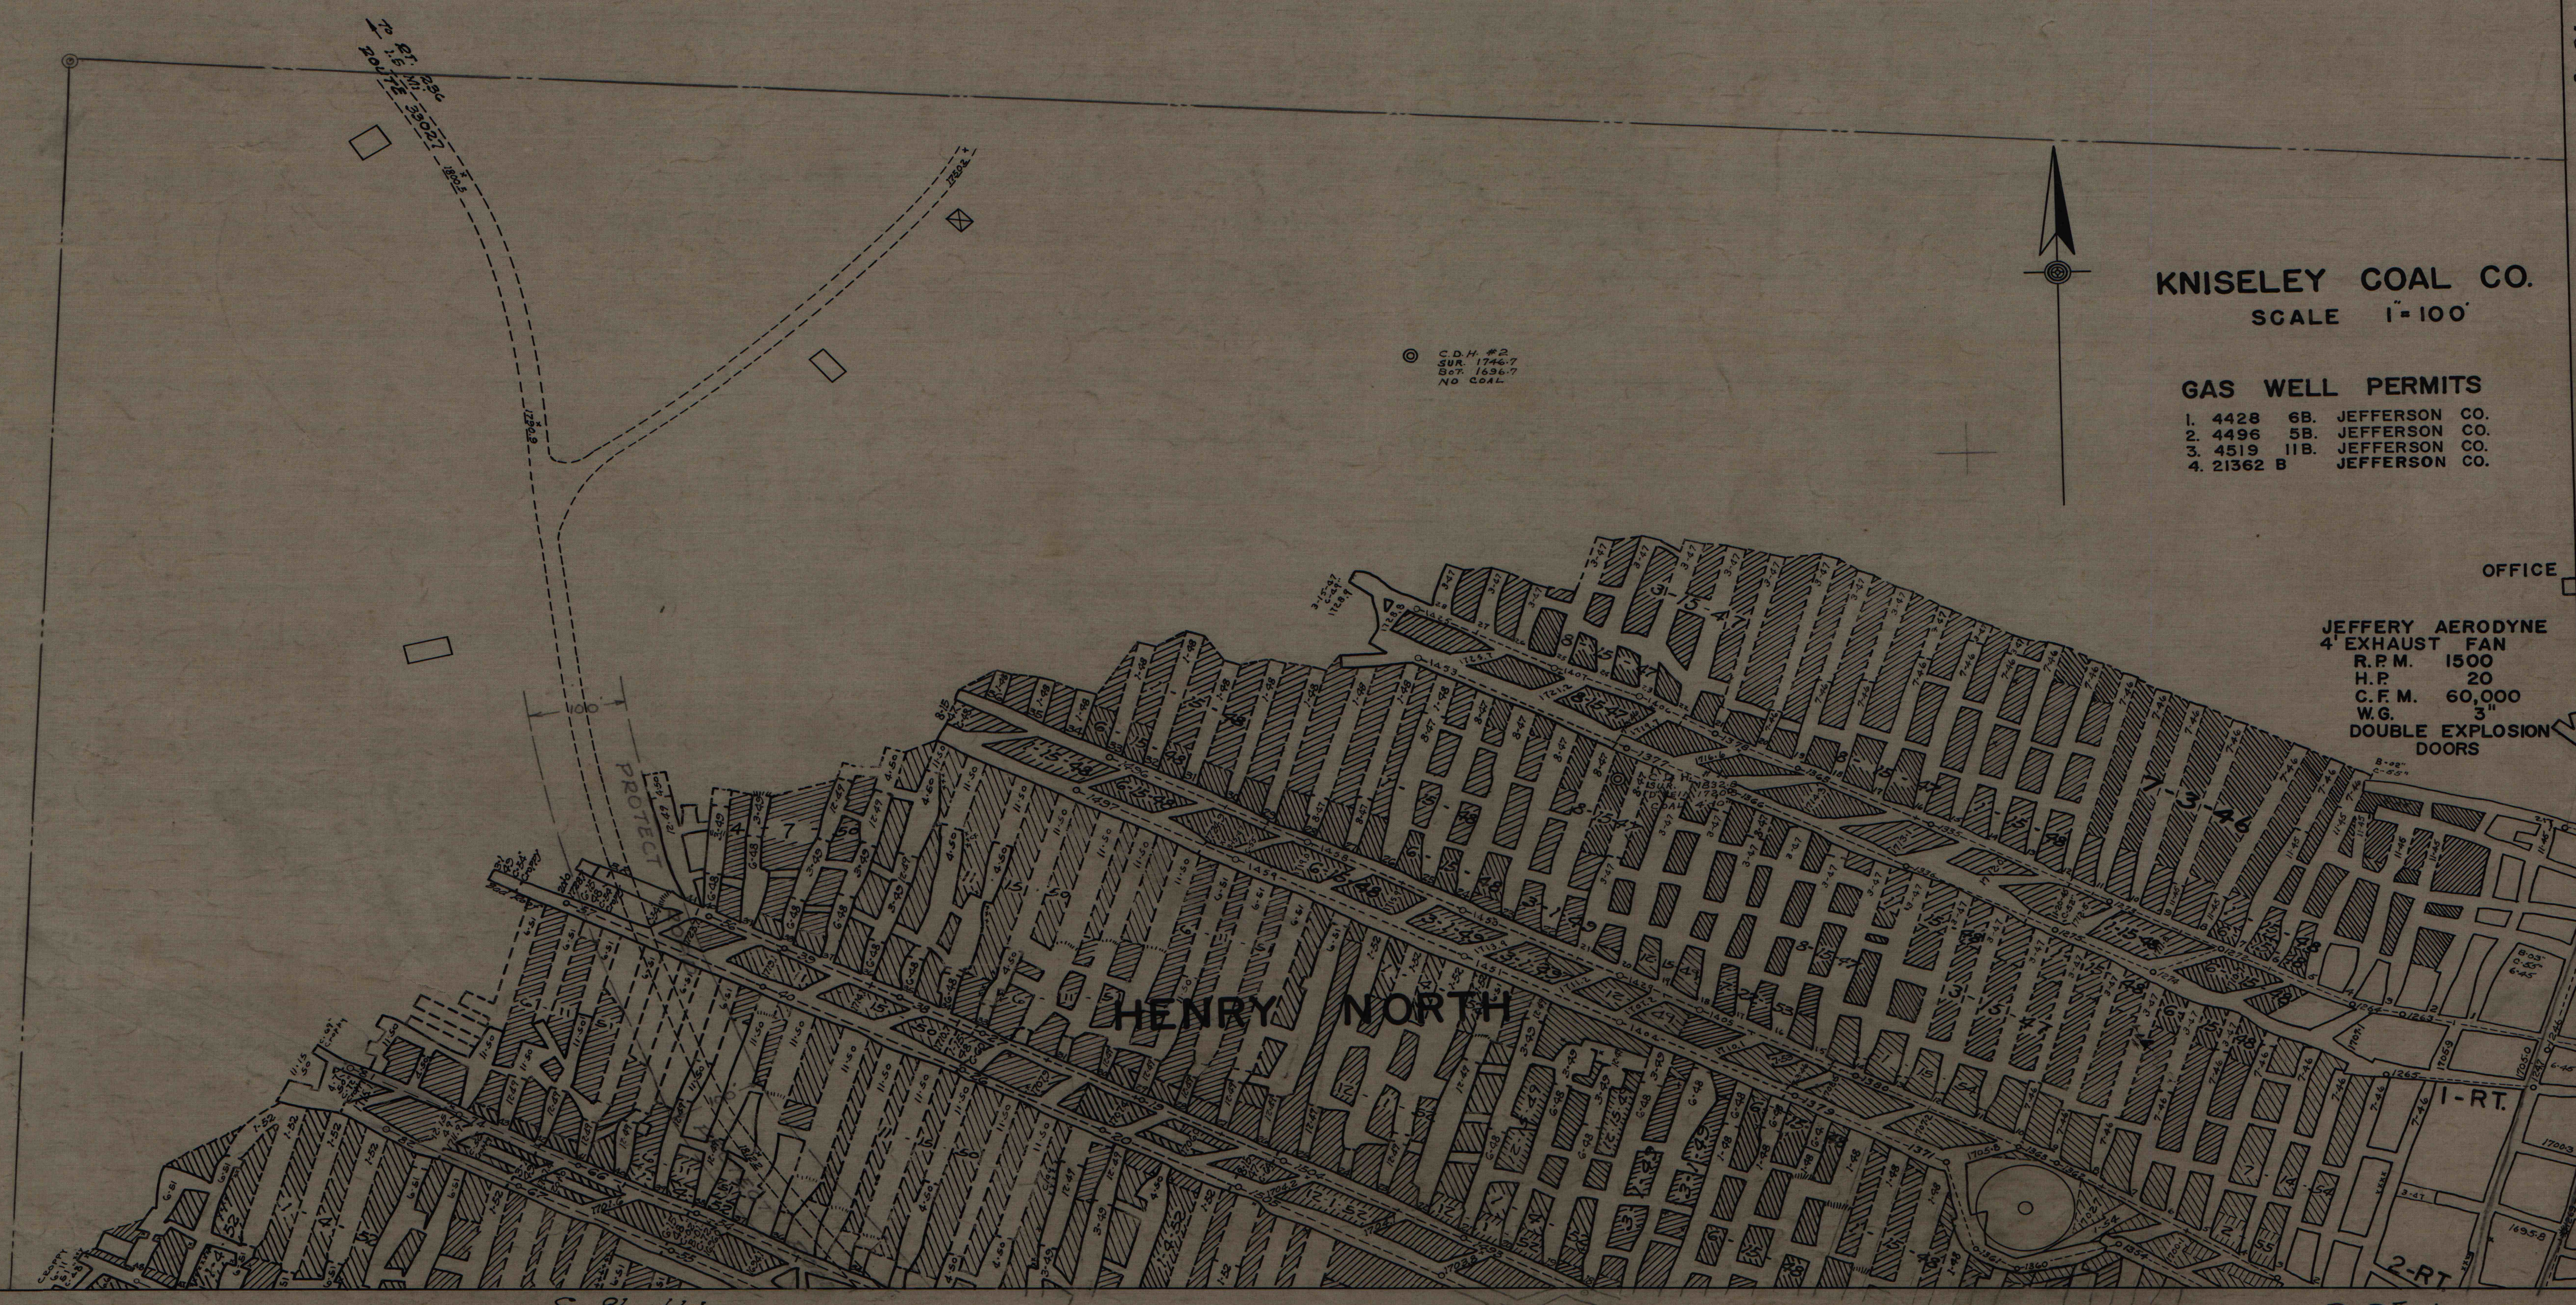

KNISELEY COAL CO.
SCALE 1"=100'

GAS WELL PERMITS

- | | |
|------------|--------------------|
| 1. 4428 | 6B. JEFFERSON CO. |
| 2. 4495 | 5B. JEFFERSON CO. |
| 3. 4519 | 11B. JEFFERSON CO. |
| 4. 21362 B | JEFFERSON CO. |

OFFICE

JEFFERY AERODYNE
4' EXHAUST FAN
R.P.M. 1500
H.P. 20
C.F.M. 60,000
DOUBLE EXPLOSION
DOORS

HENRY NORTH

1-RT.

2-RT.