


82YNOLODSVILLE
4.7 MI. →

Fit to ?

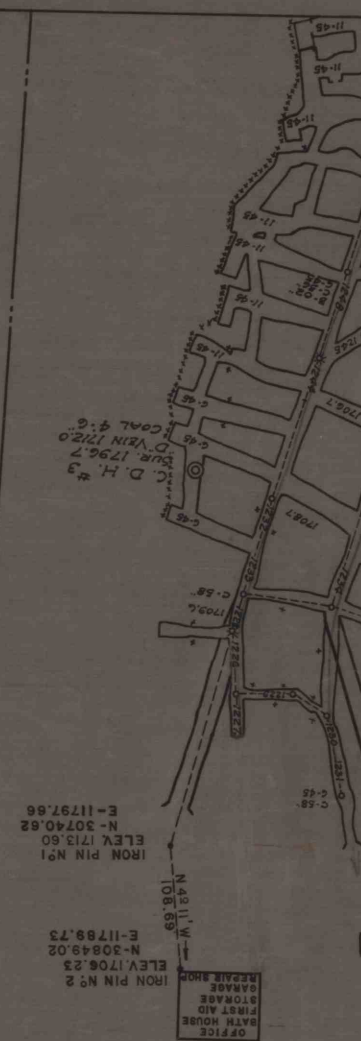

B-35-2
KNISELEY TRACING No. 2
DRAWER 73