


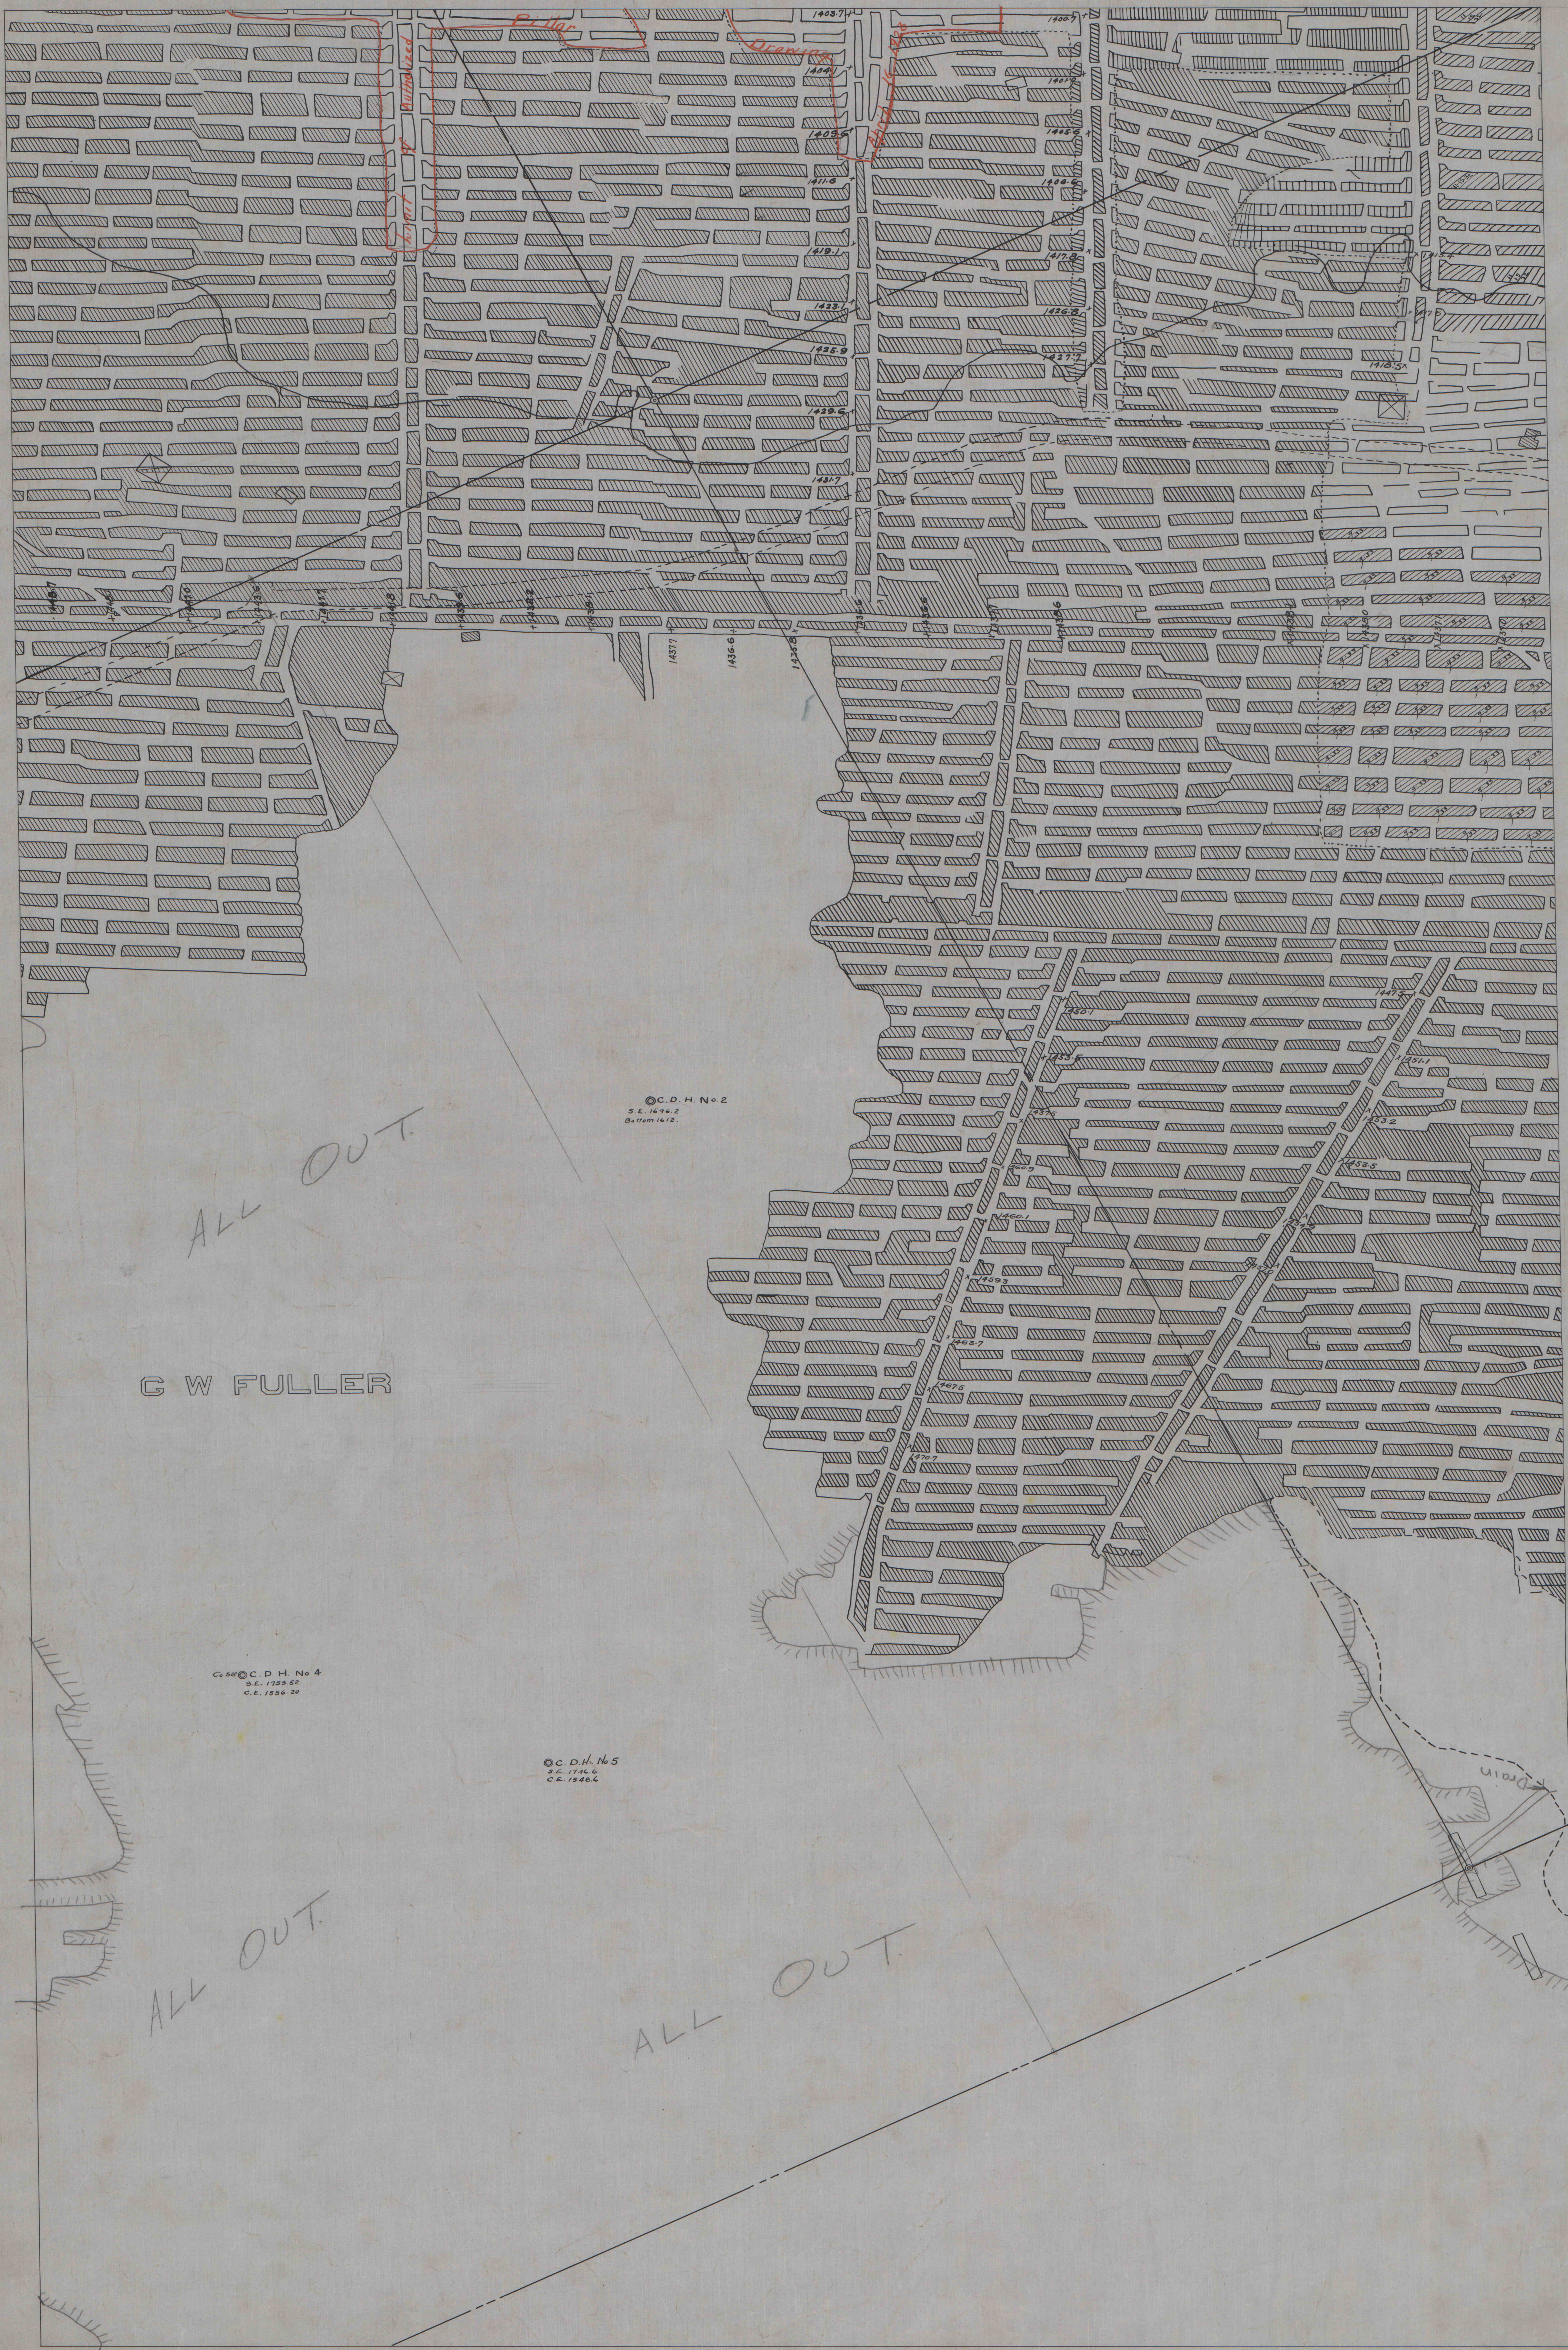

ALL OUT

C W FULLER

C.D.H. No 4
S.E. 1759.52
C.E. 1556.20

C.D.H. No 5
S.E. 1746.6
C.E. 1540.4

ALL OUT

ALL OUT