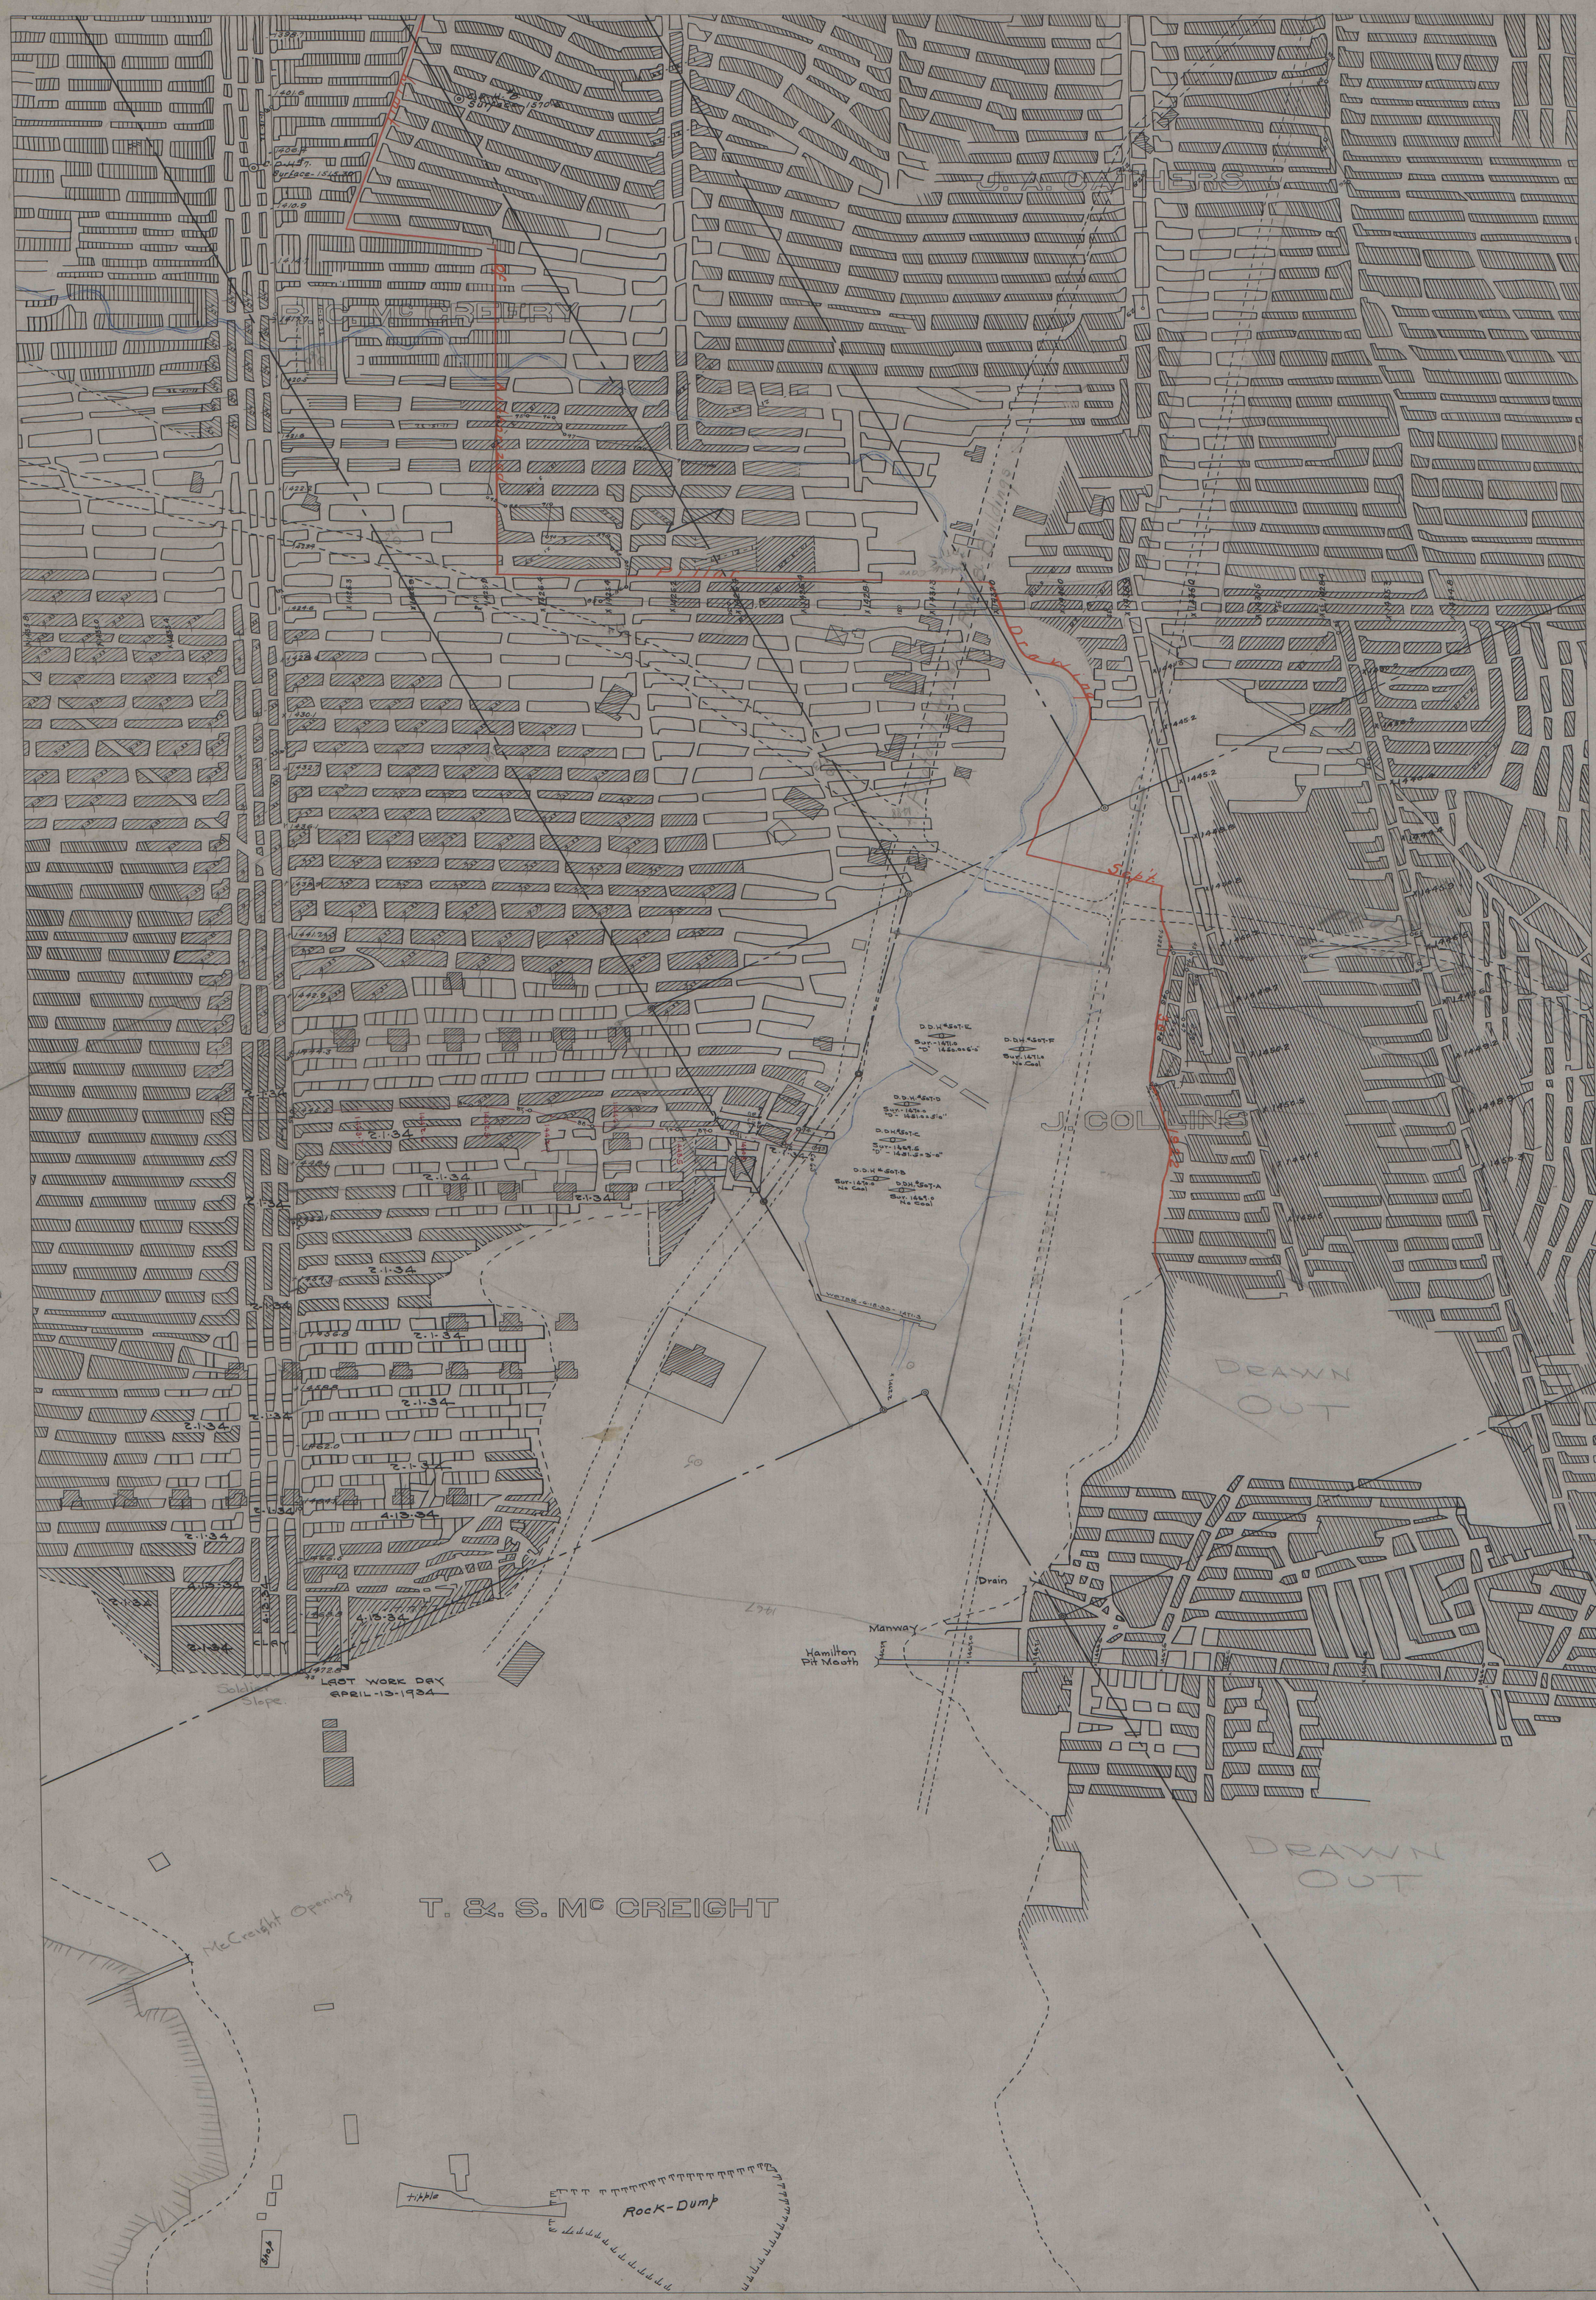
J. A. OWENS
R. C. McGREGORY
J. COLLINS
DRAWN OUT
DRAWN OUT
T. & S. Mc CREIGHT
McCreight Opening
Hamilton Pit Mouth
Manway
Drain
LAST WORK DAY APRIL-13-1934
Soldier Slope
Rock-Dump
Tipple
Shop
Slope
Drawing
Slope
2.1.34
4.13.34