


UPPER SEAM DRAWER 63 17 B-52 - TRACING 3A

DRIFT
Trailing

DRIFT (Coal Glen)
Lower 100 ft

U. J. STEWART

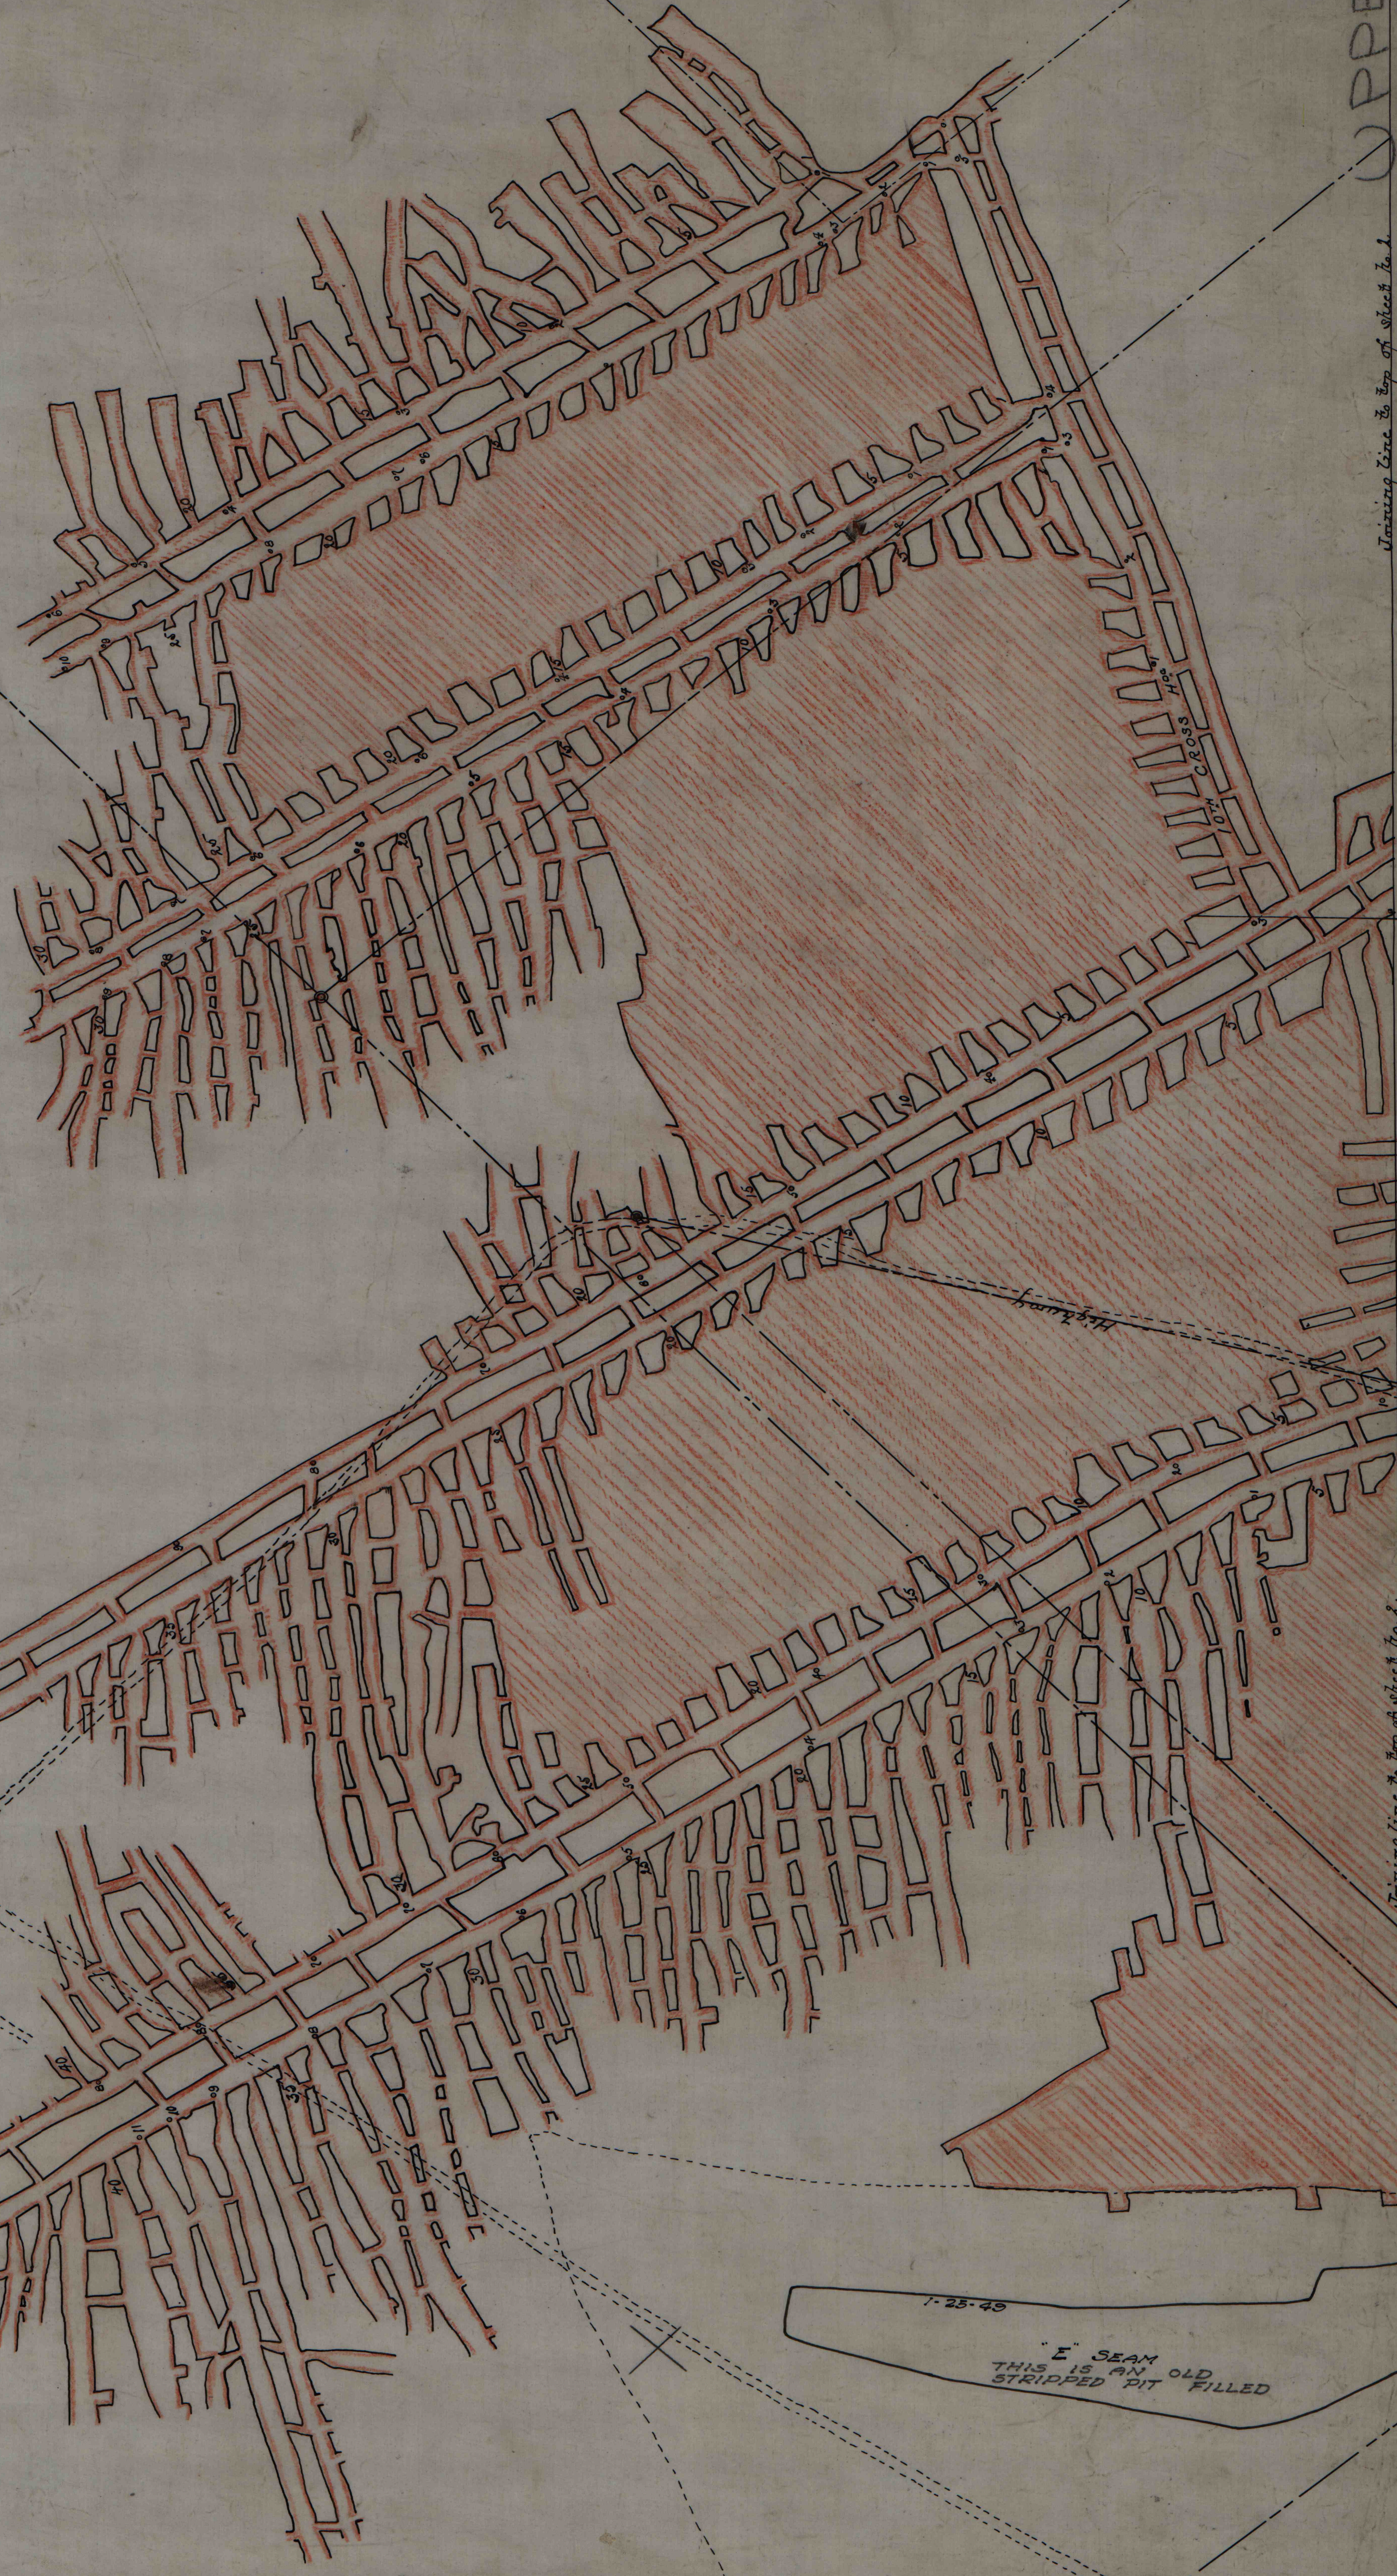

SHEET No 3A

UPPER VEIN
UPPER SEAM DRAWER 63 17 TRACING 3A B-52-3A