


DRAWER 17 8-53B-15A

COOPER HEIRS

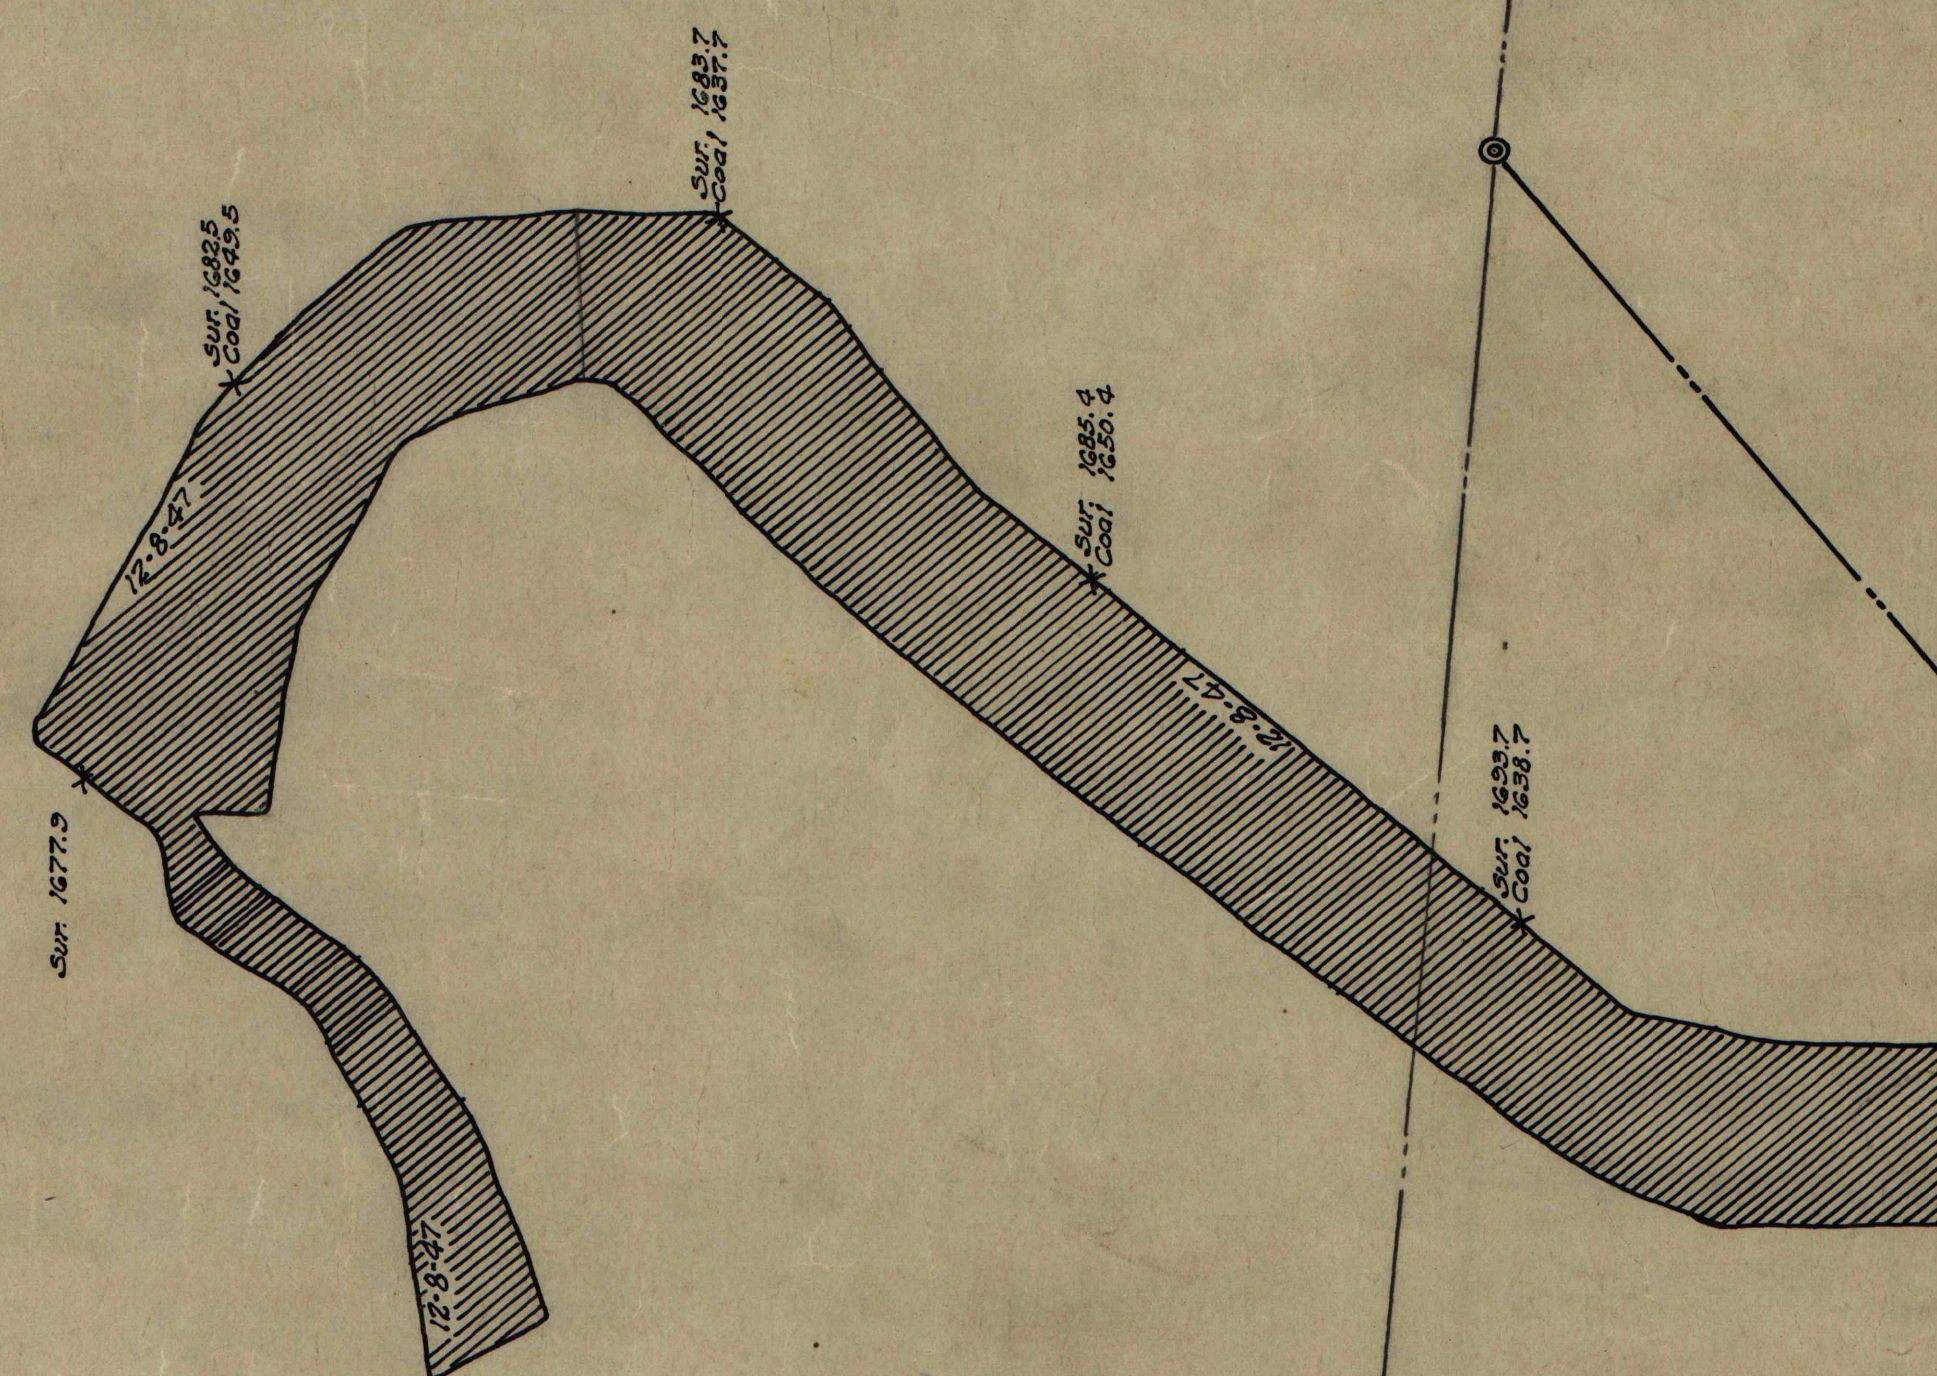

DRAWER 17      B-53B-15A