


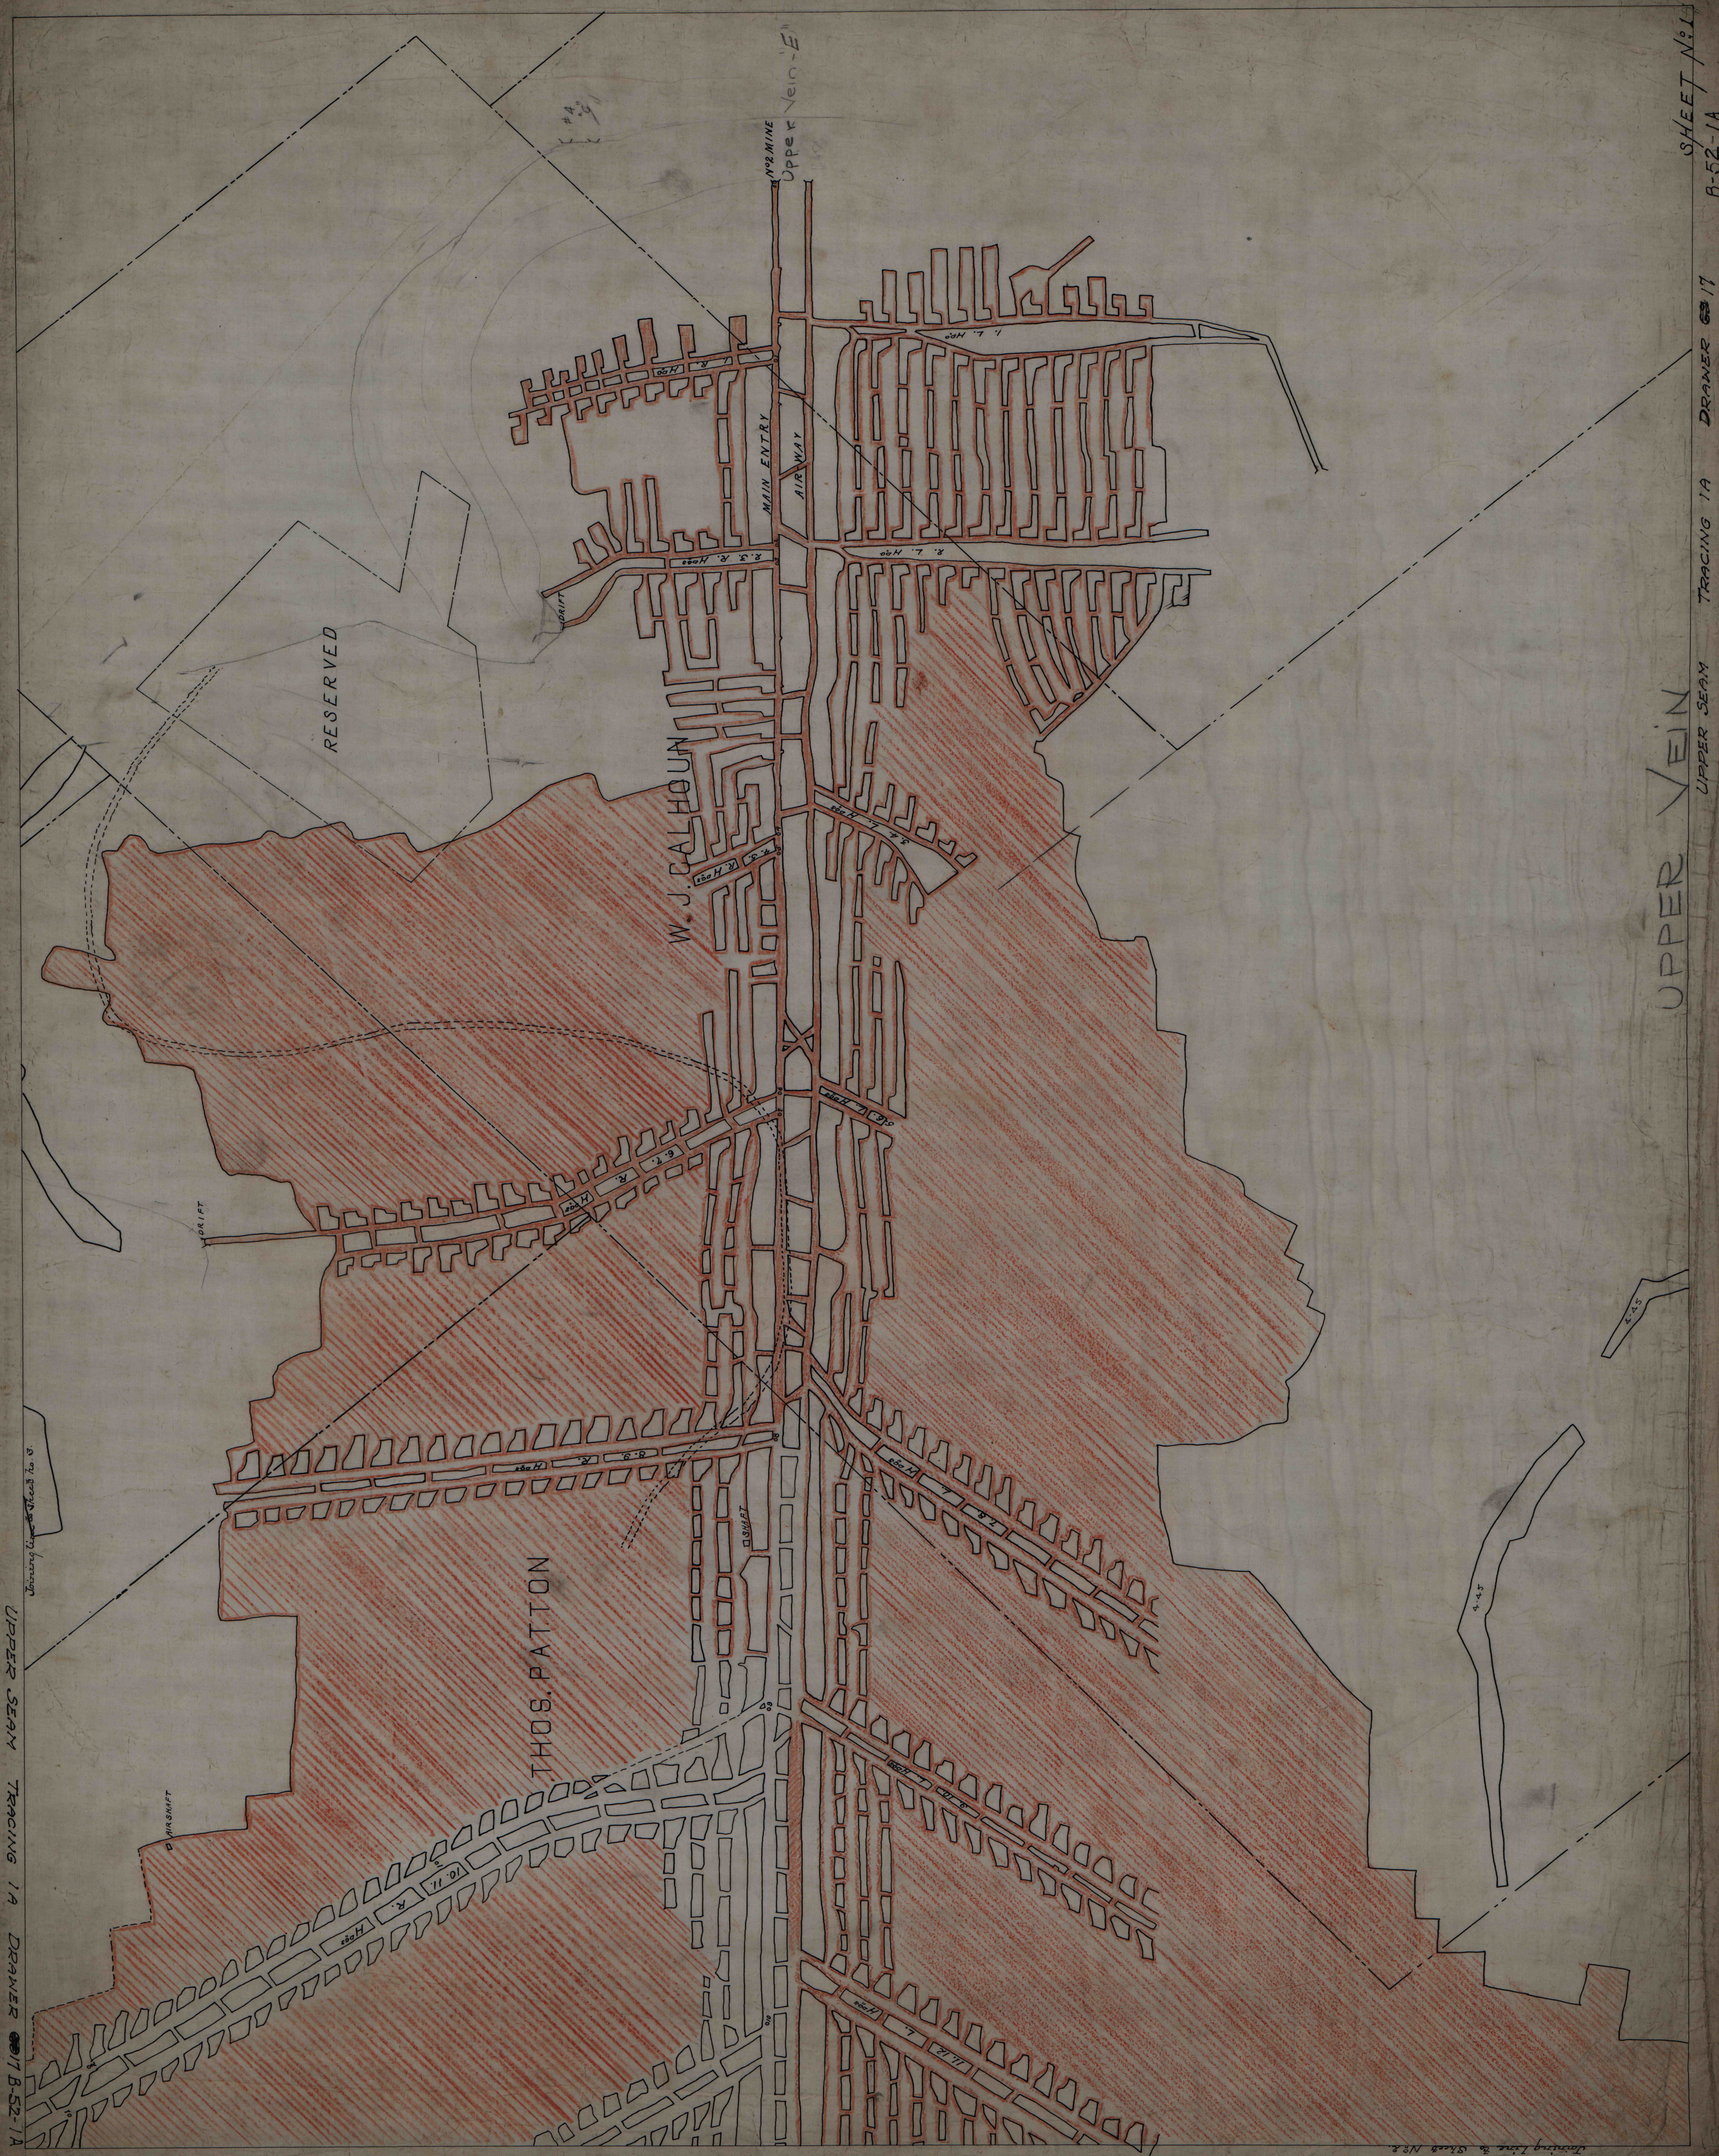

UPPER SEAM TRACING 1A DRAWER 317 B-52-1A

UPPER VEIN
UPPER SEAM TRACING 1A DRAWER 317
SHEET No. 1
B-52-1A