


B-53 -4-D

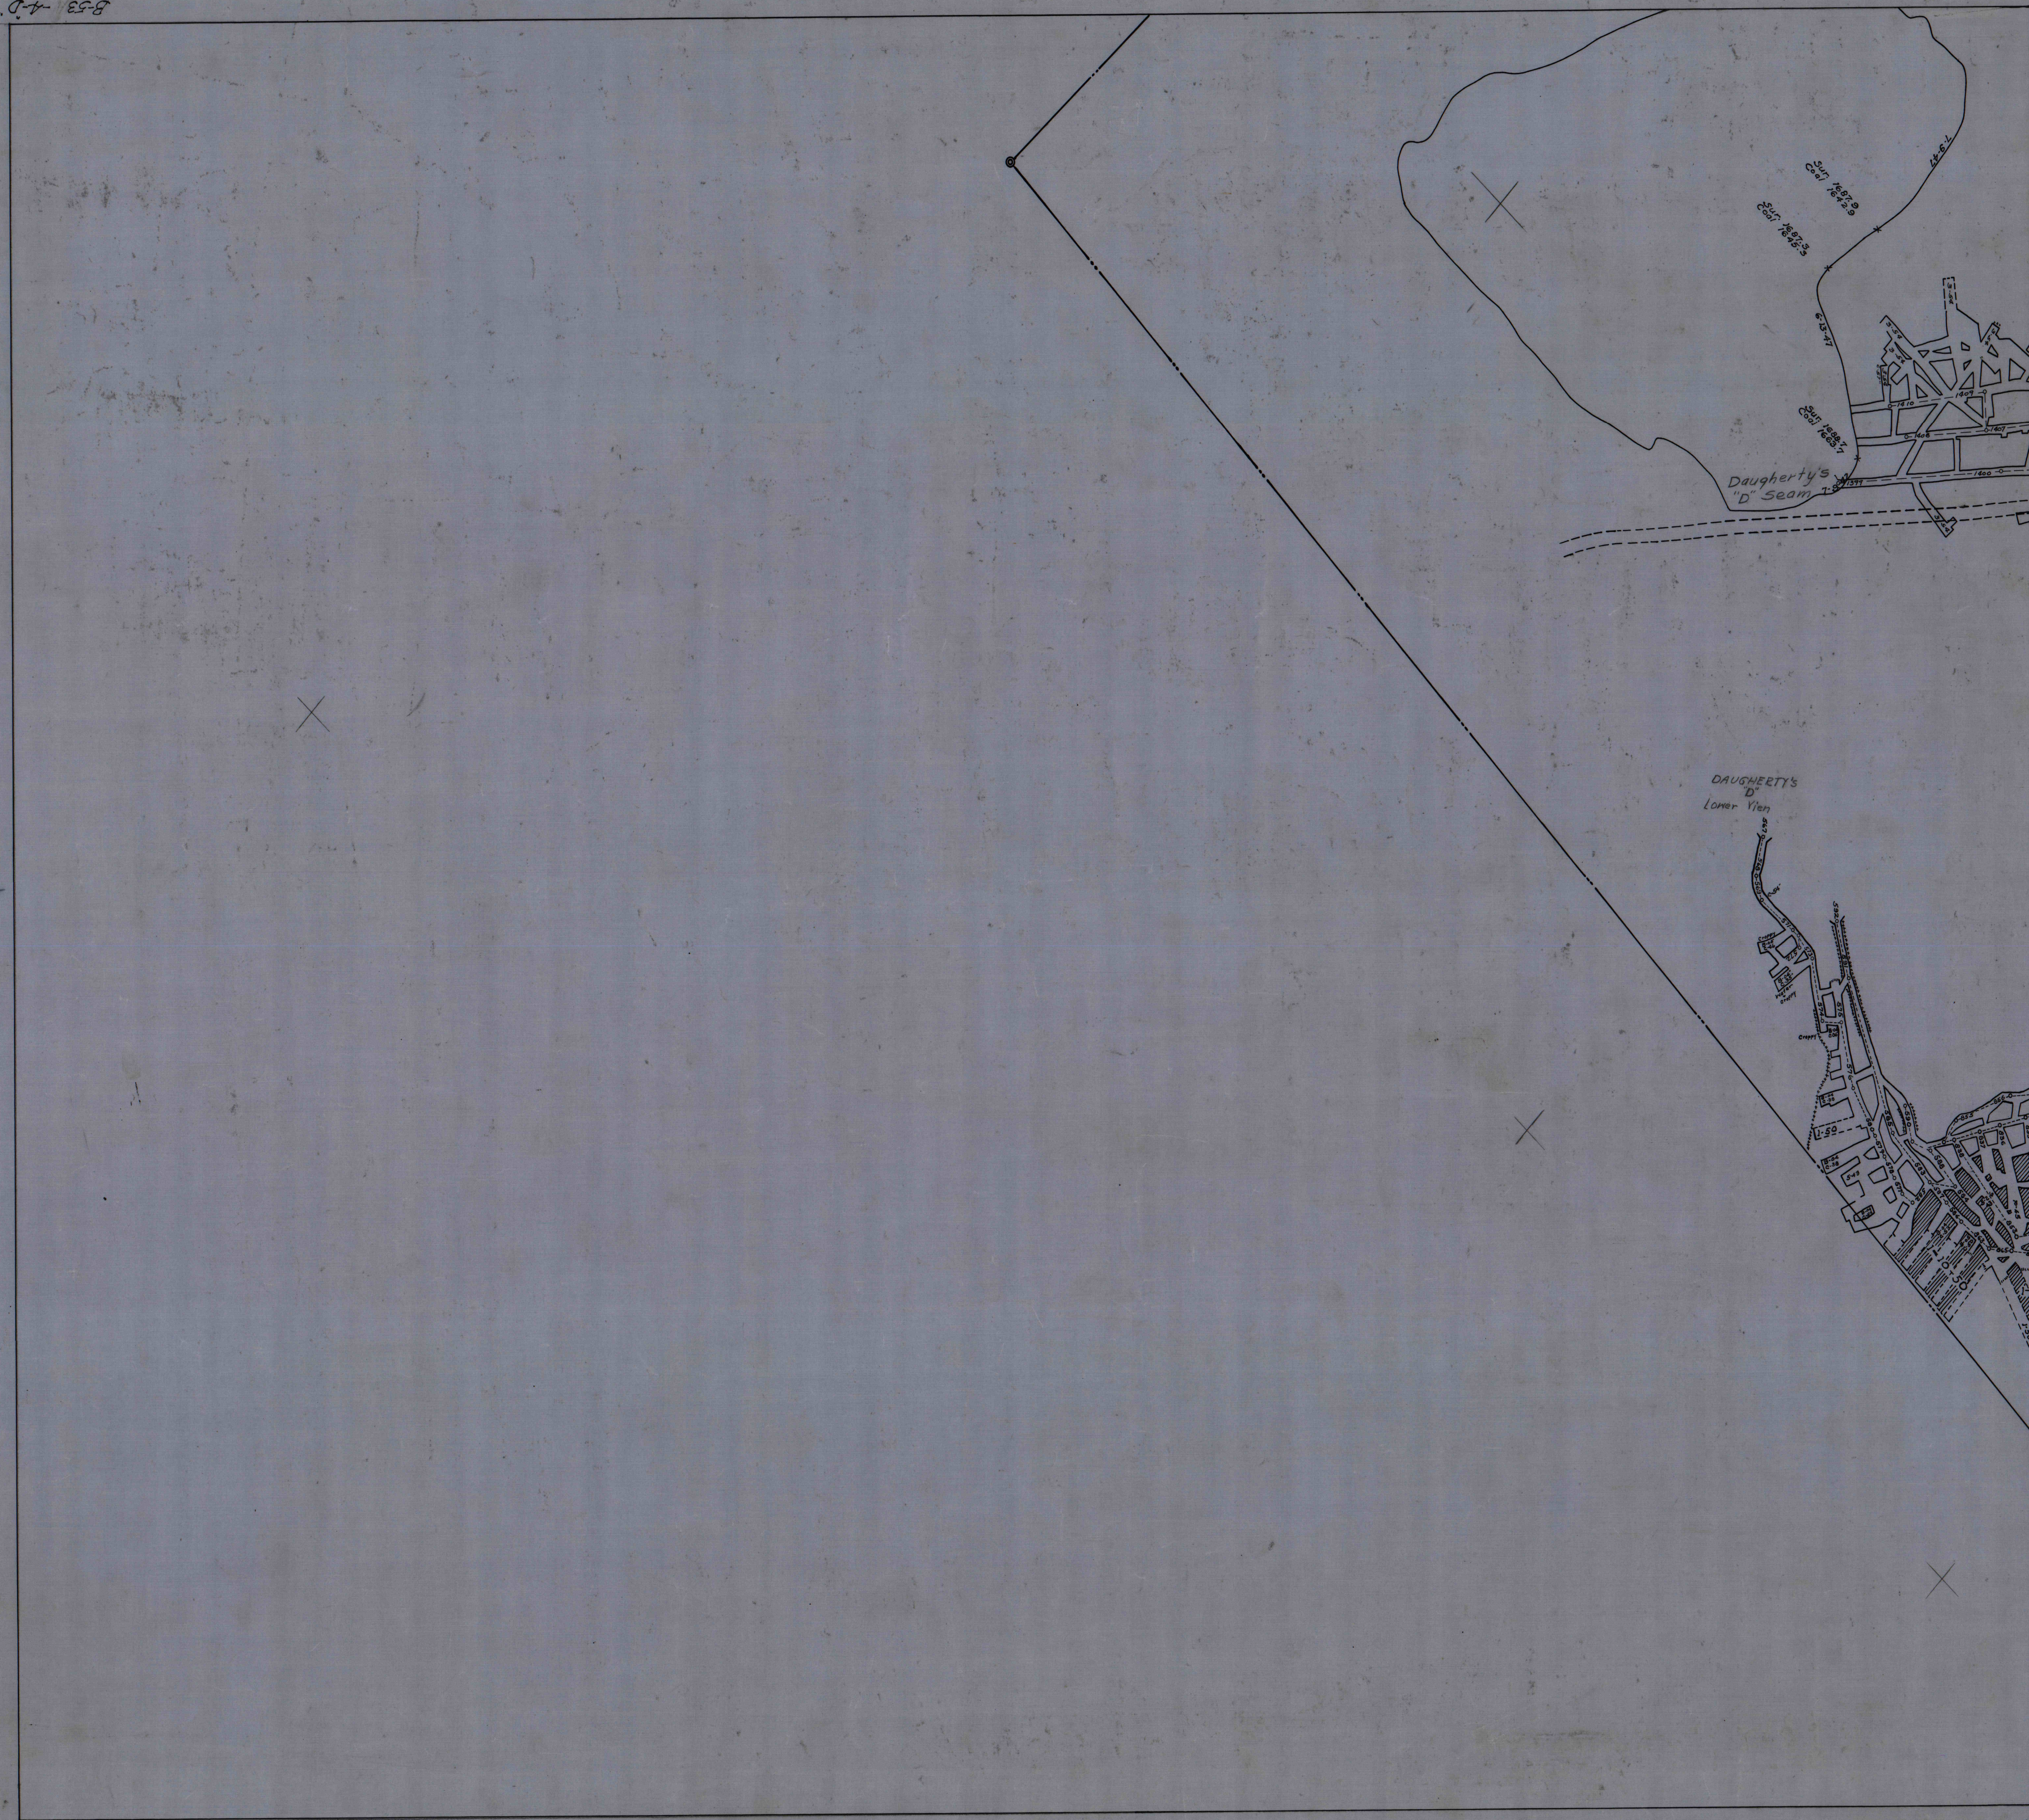

B-53 -4-D

BEECHTREE

DRAWER 69

LOWER BEECHTREE

LOWER

SEAM

DRAWER

69 17

④-D