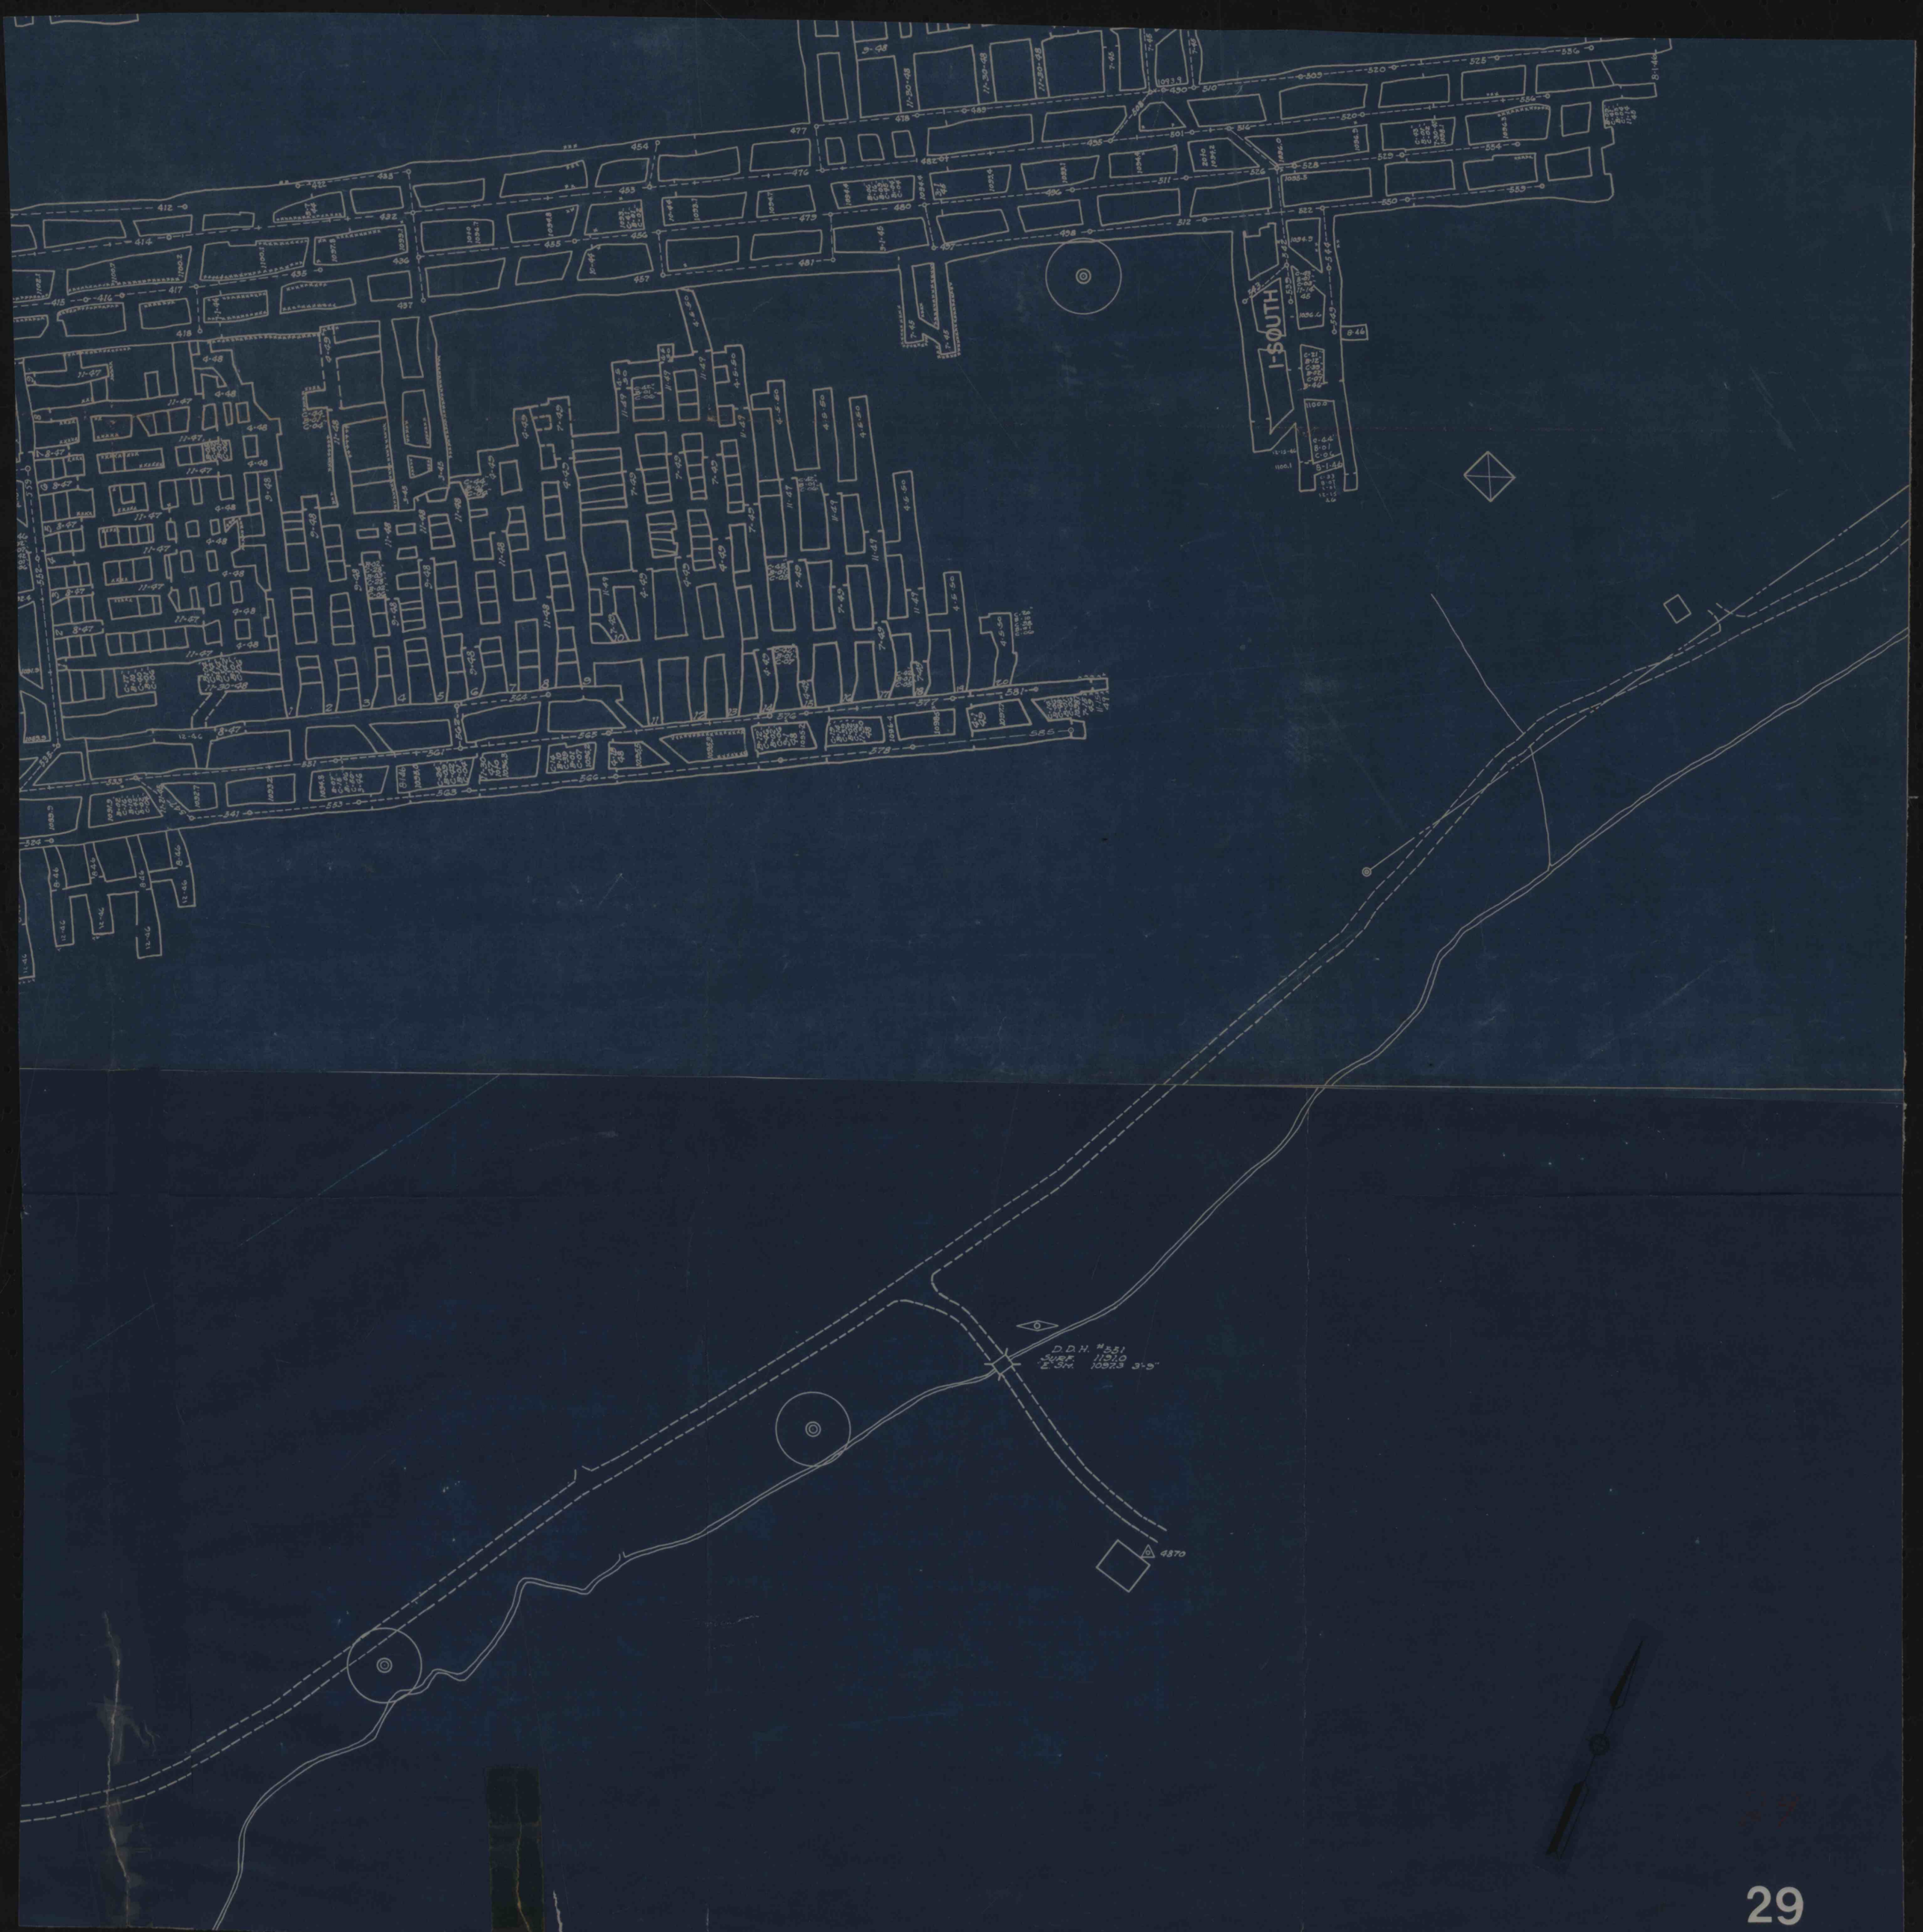
I-SOUTH
D.D.H. #551
SURF. 1131.0
E. SH. 1097.3 3'-9"
4870