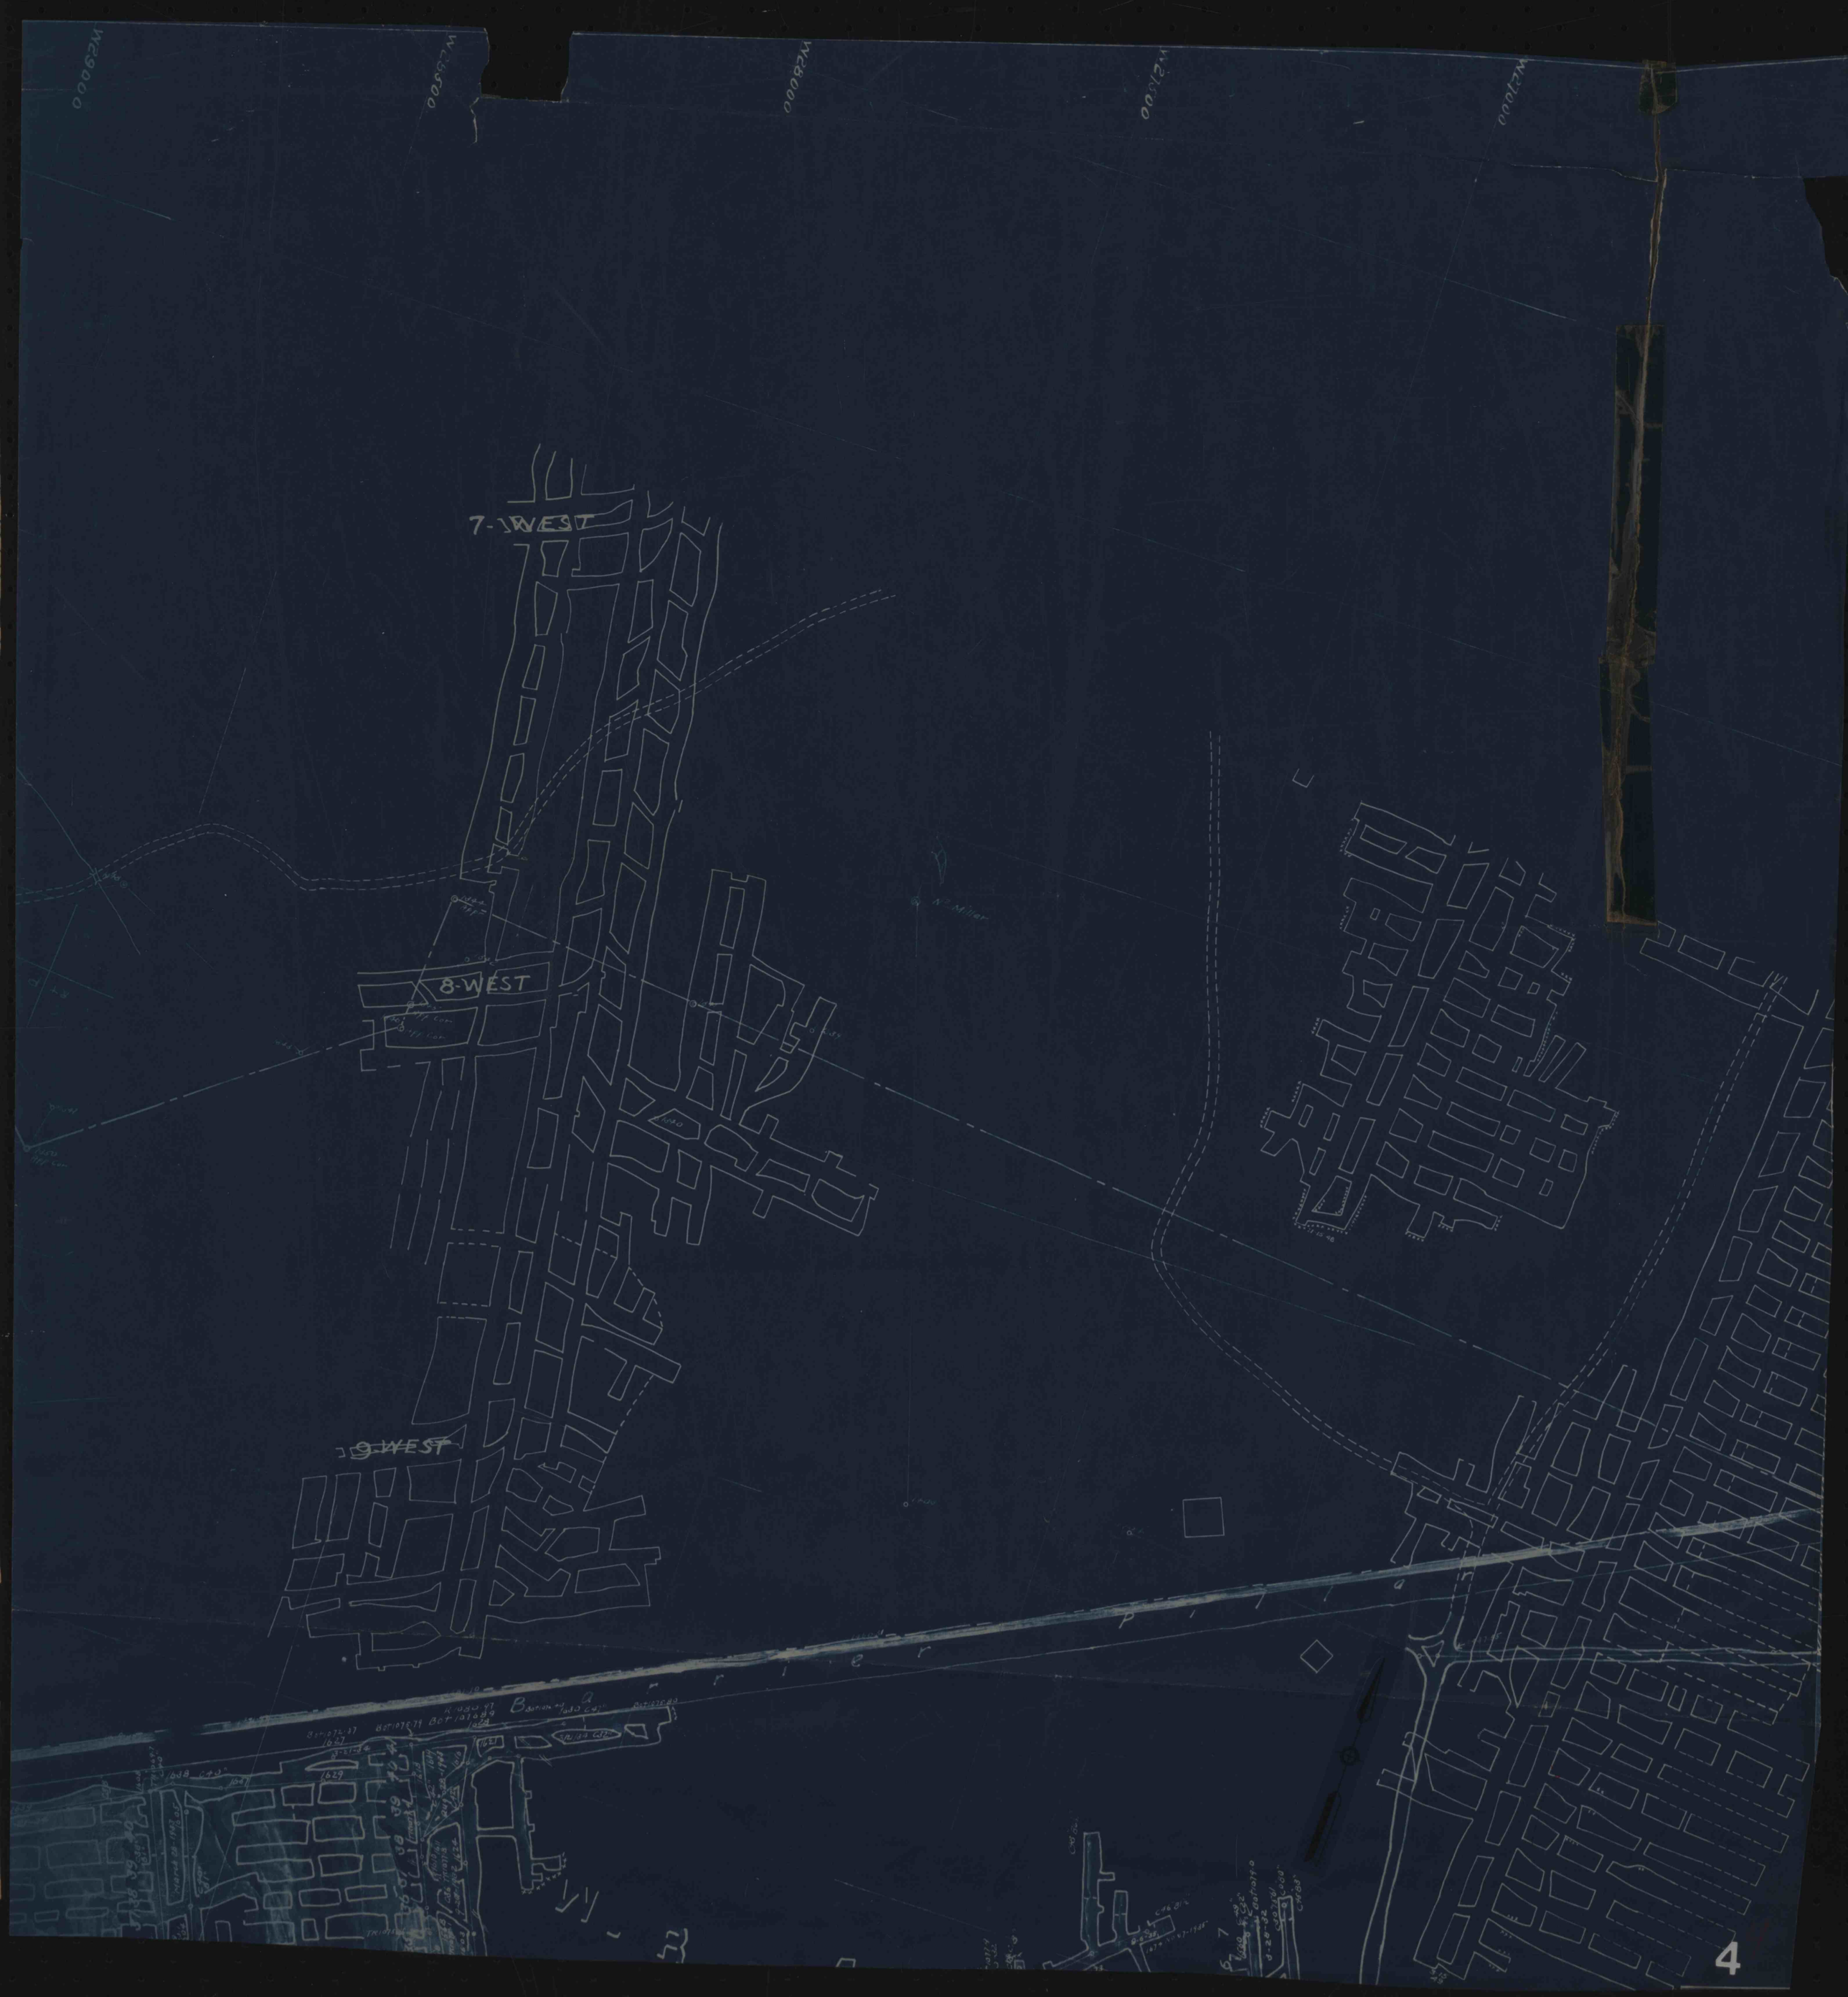
7-WEST
8-WEST
9-WEST
4