


HOMER CITY AREA

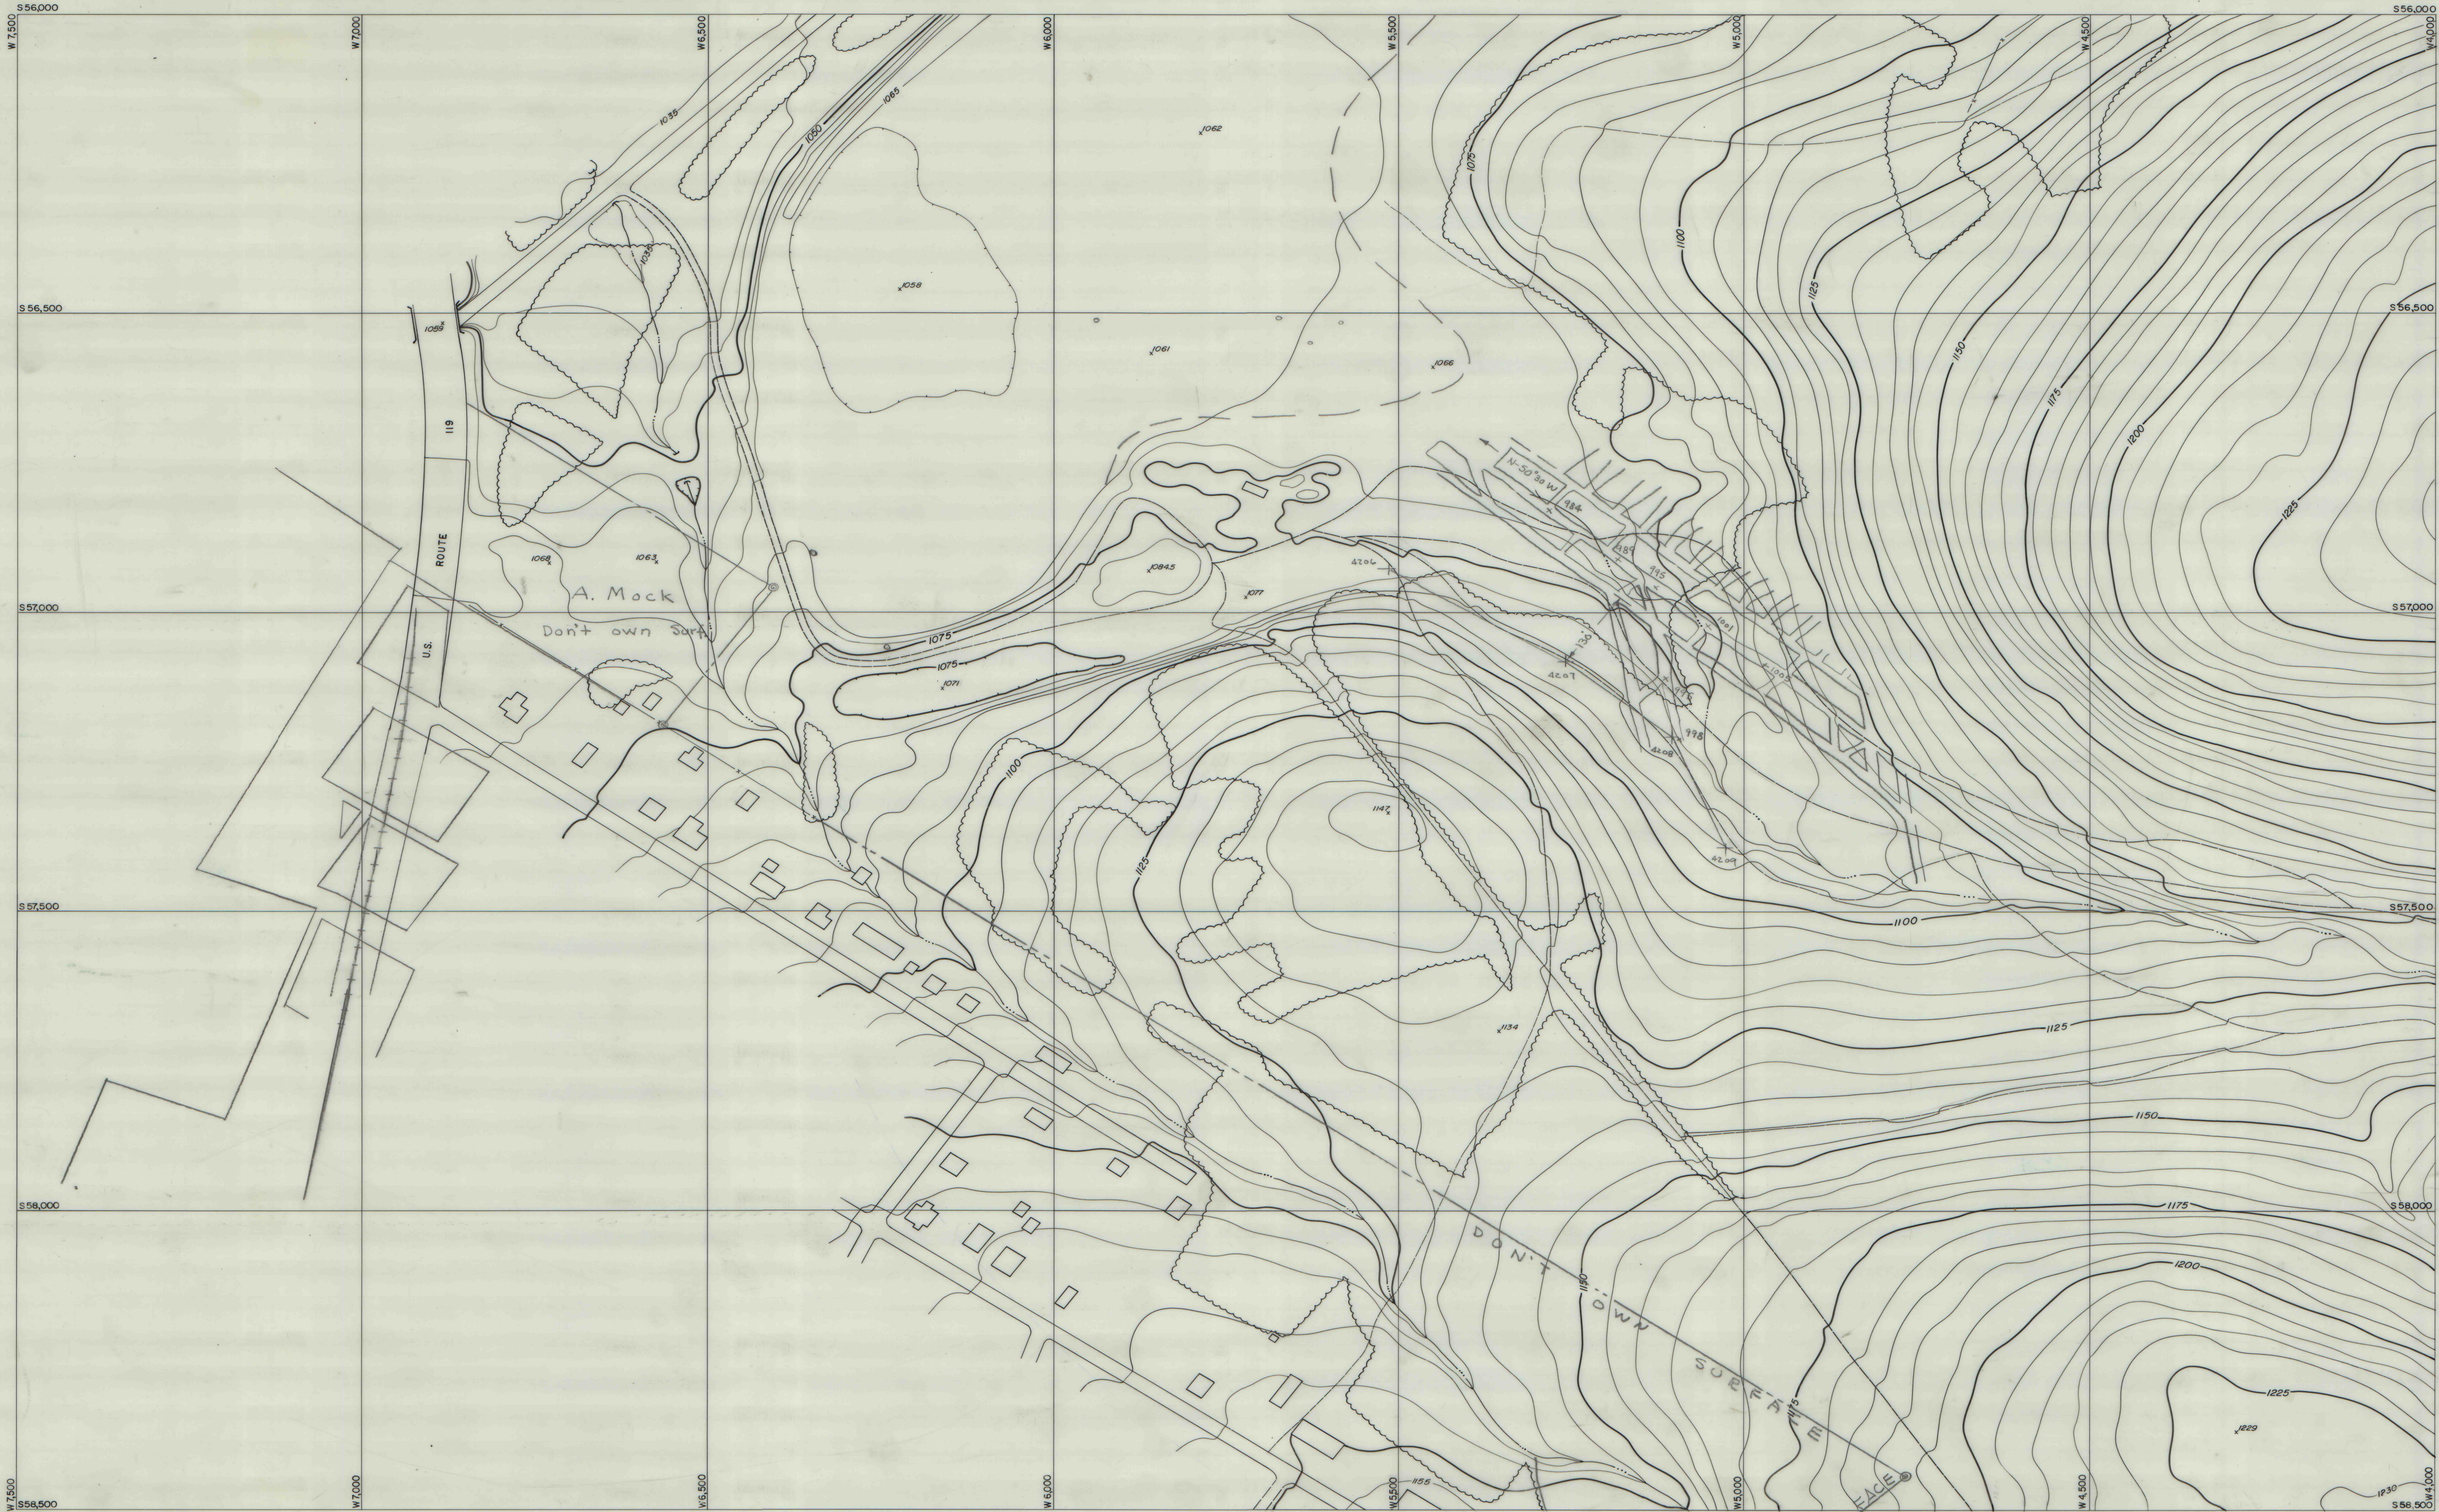

PREPARED BY
AMERICAN AIR SURVEYS, INC.
307 PENN AVENUE
PITTSBURGH, PA.
A 546

SCALE 1" = 100'
CONTOUR INTERVAL 5'

PREPARED FOR
ROCHESTER AND PITTSBURGH COAL CO.
INDIANA
PENNSYLVANIA