


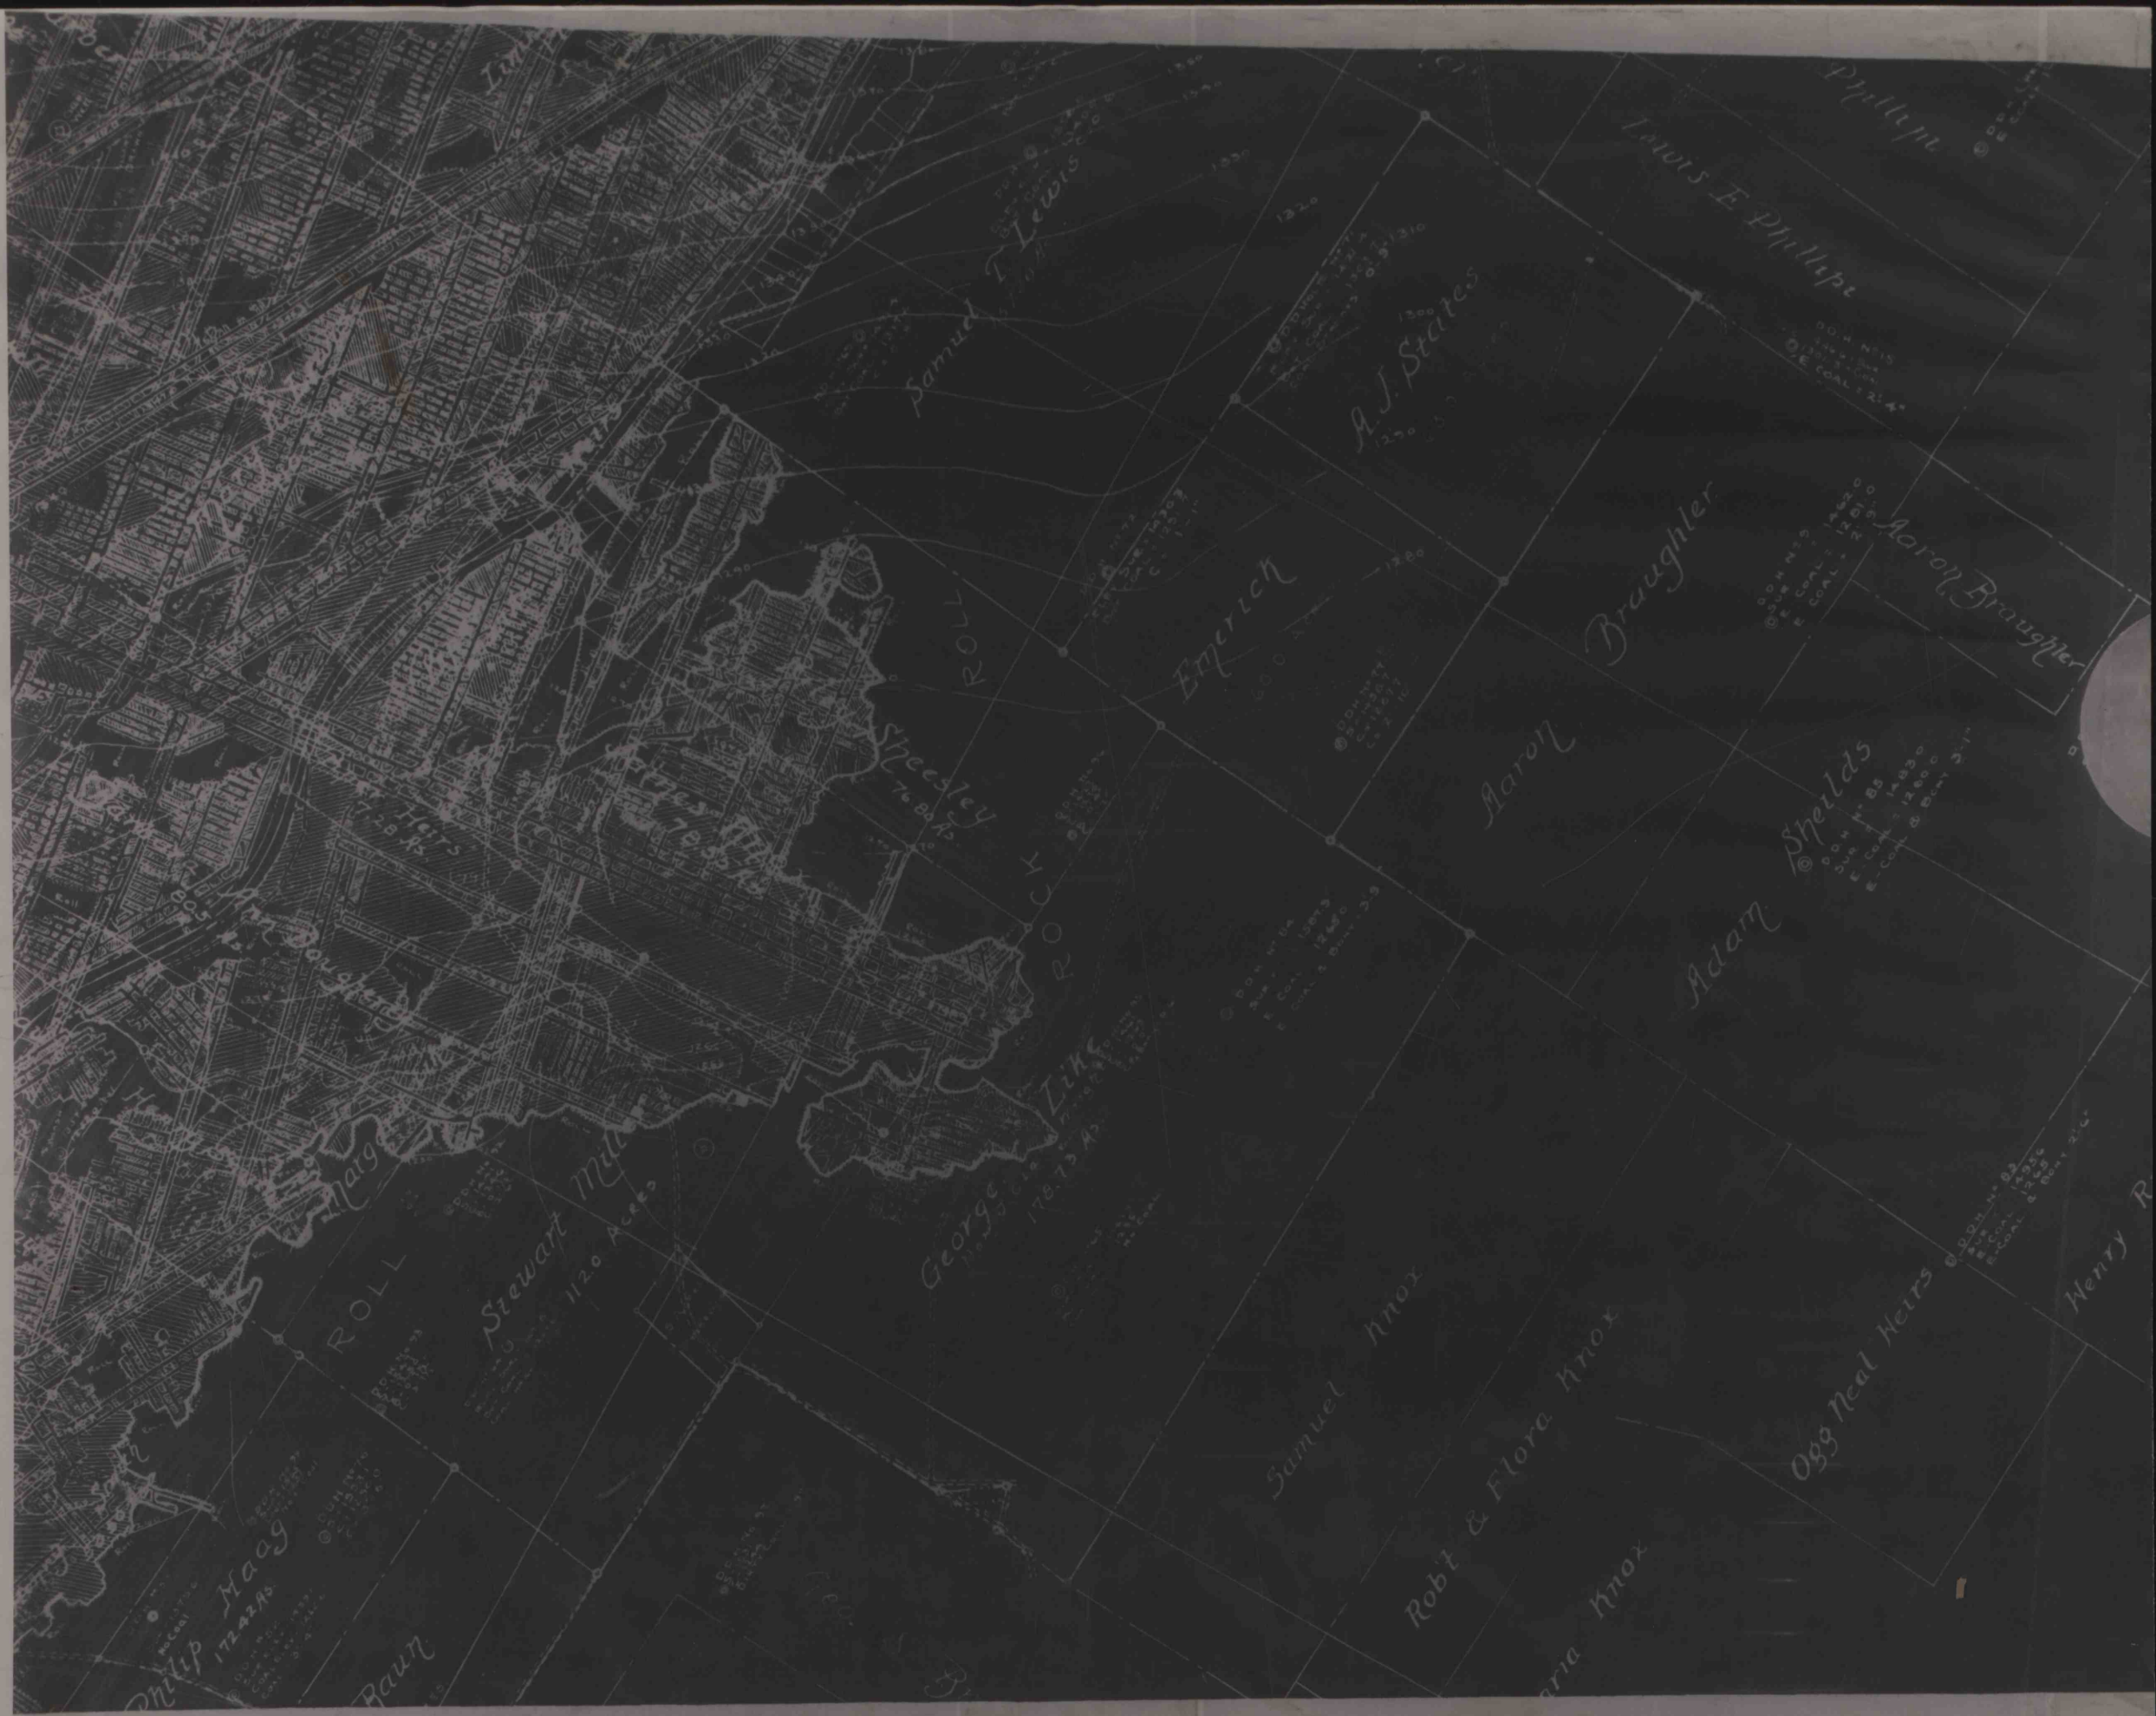

Philip Magg
1722 1/2 Acs

Baun

ROLL

Stewart Mill
1120 Acs

George Link
1787 3/4 Acs

Speesley
700 Acs

Samud D Lewis

Emrich

A. J. States

Maron

Braugler

Adam

Speilds
1788 1/2 Acs

Ogg Neal Heirs

Henry P

Maron Braugler


Phillips