


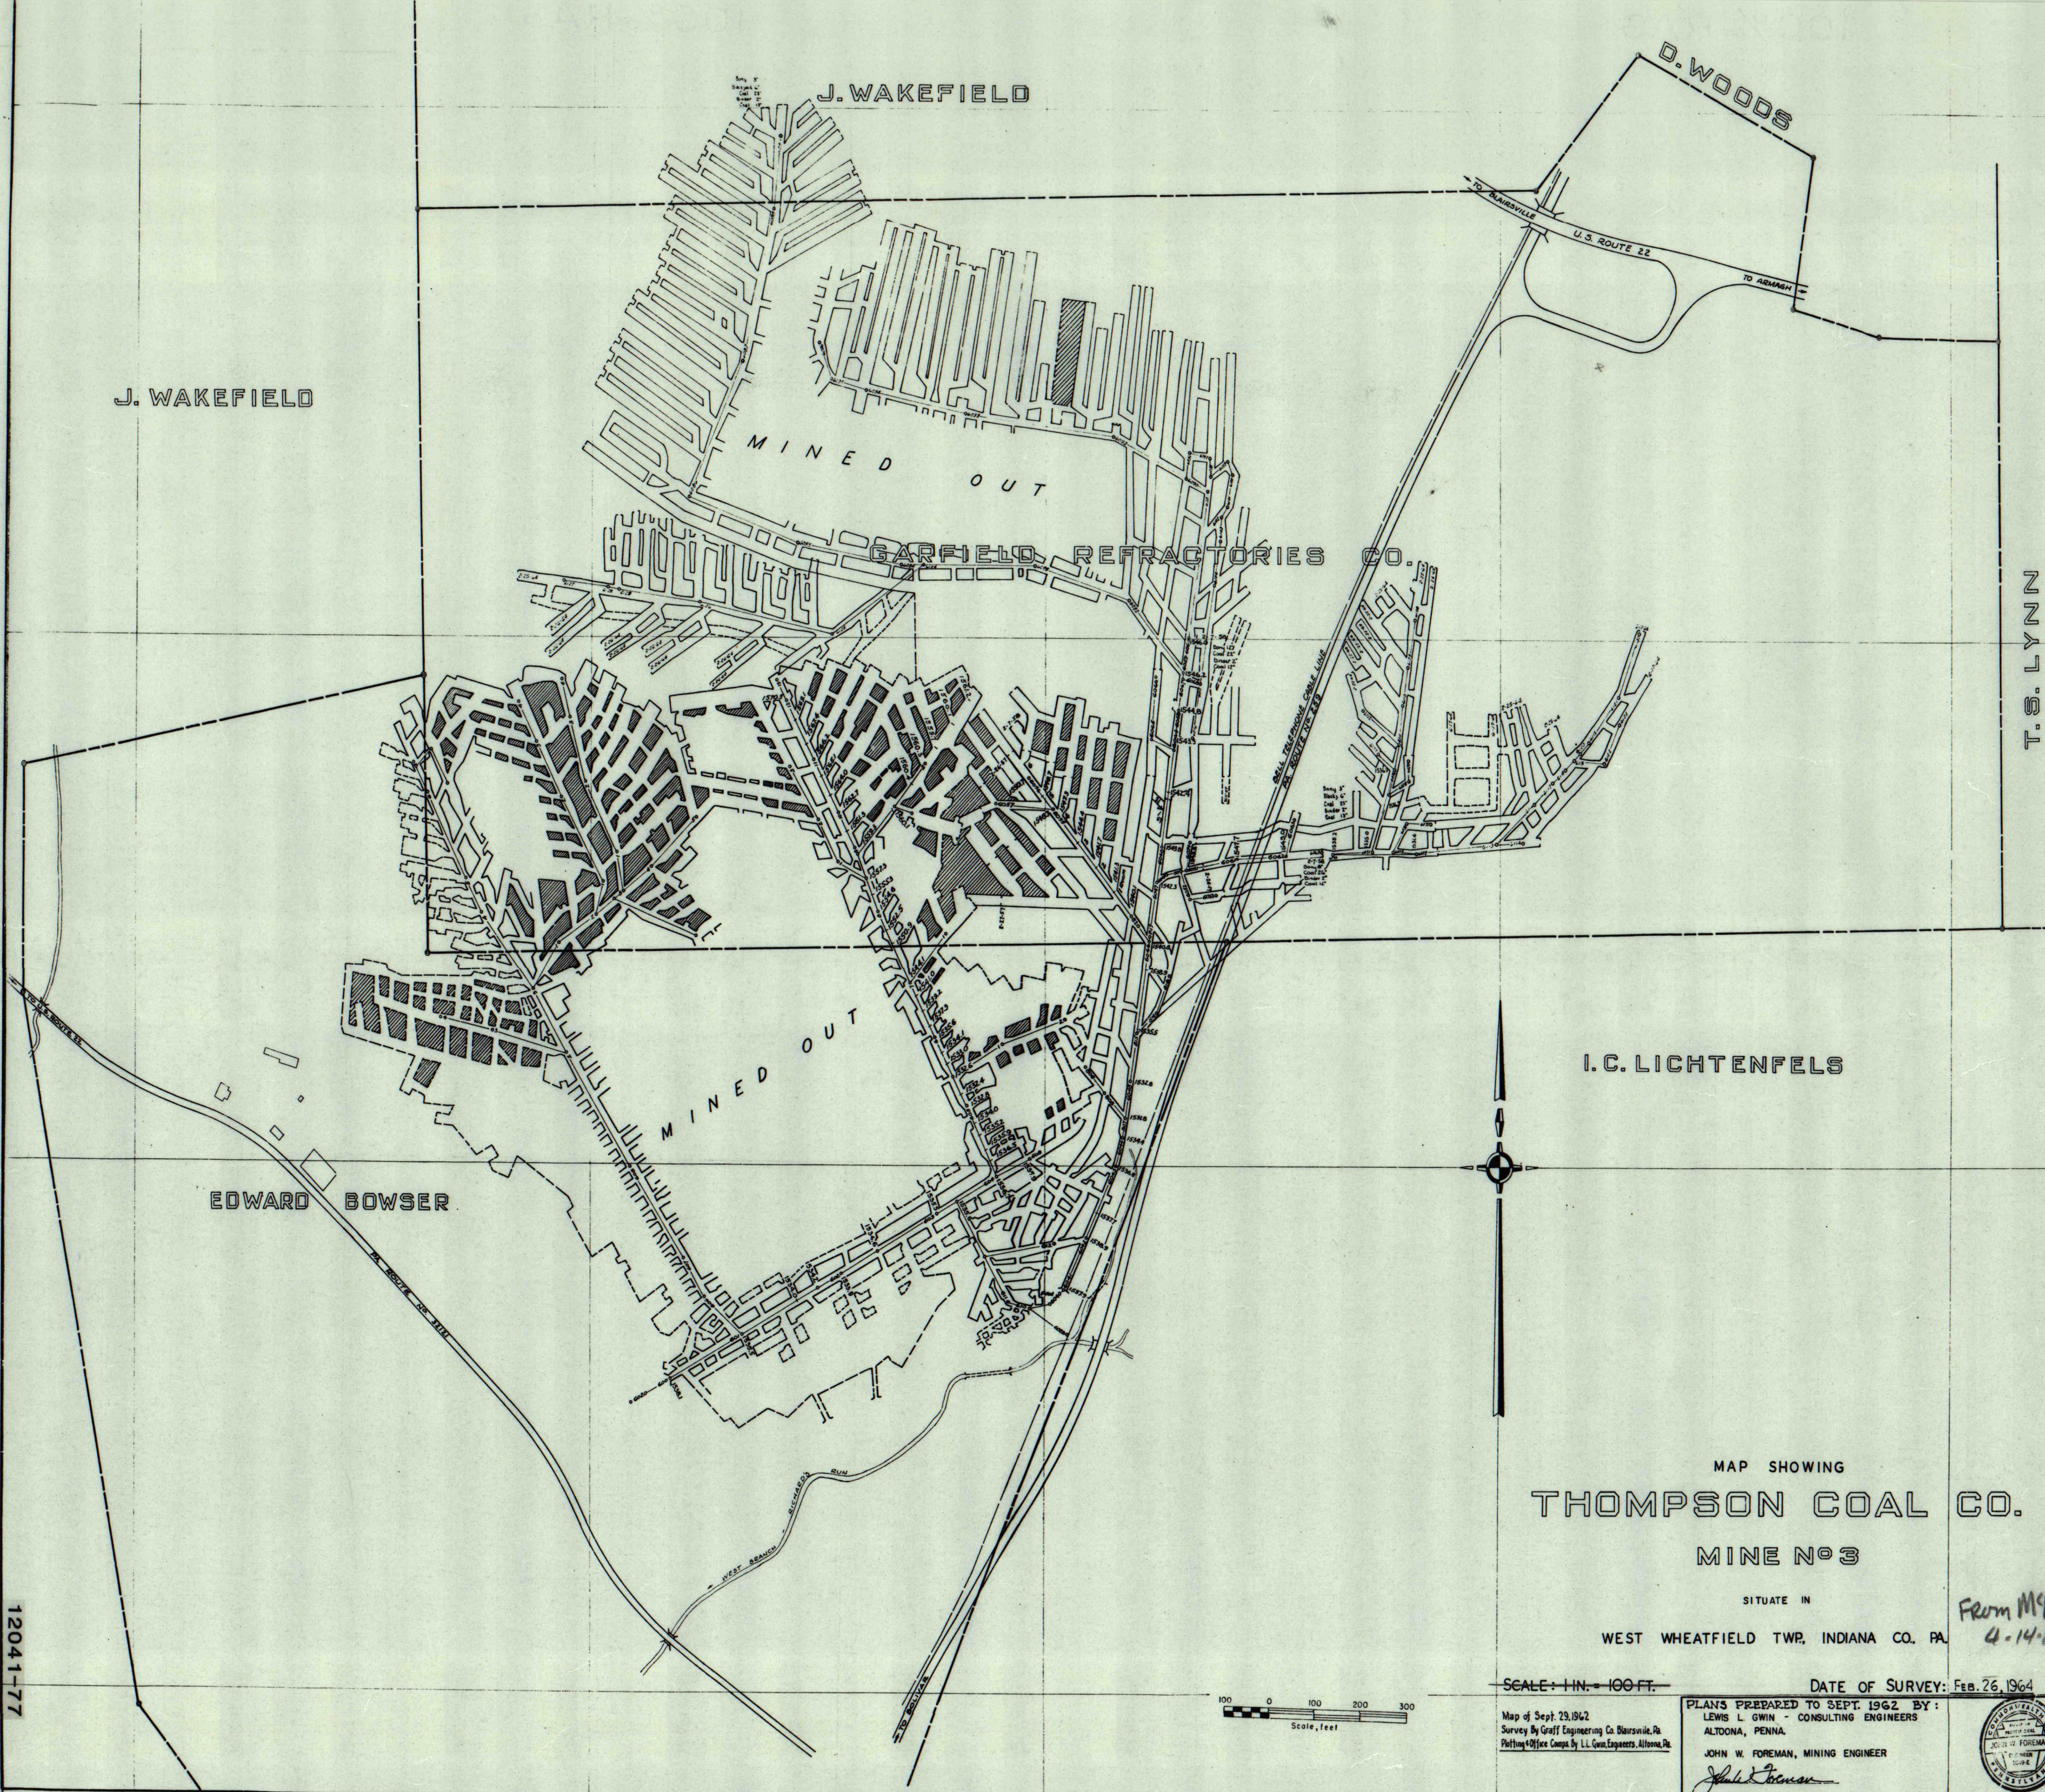

MAP SHOWING
THOMPSON COAL CO.
MINE NO 3

SITUATE IN
WEST WHEATFIELD TWP, INDIANA CO. PA.

SCALE: 1 IN. = 100 FT.


DATE OF SURVEY: Feb. 26, 1964

Map of Sept. 29, 1962
Survey By Graff Engineering Co. Blairsville, Pa.
Plotting & Office Comps. By L.L. Gwin, Engineers, Altoona, Pa.

PLANS PREPARED TO SEPT. 1962 BY:
LEWIS L. GWIN - CONSULTING ENGINEERS
ALTOONA, PENNA.

JOHN W. FOREMAN, MINING ENGINEER

From M. Mum
4-14-87

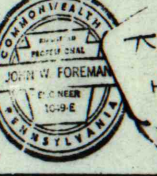

12041-77

GDF 03071 500 32X 325548