


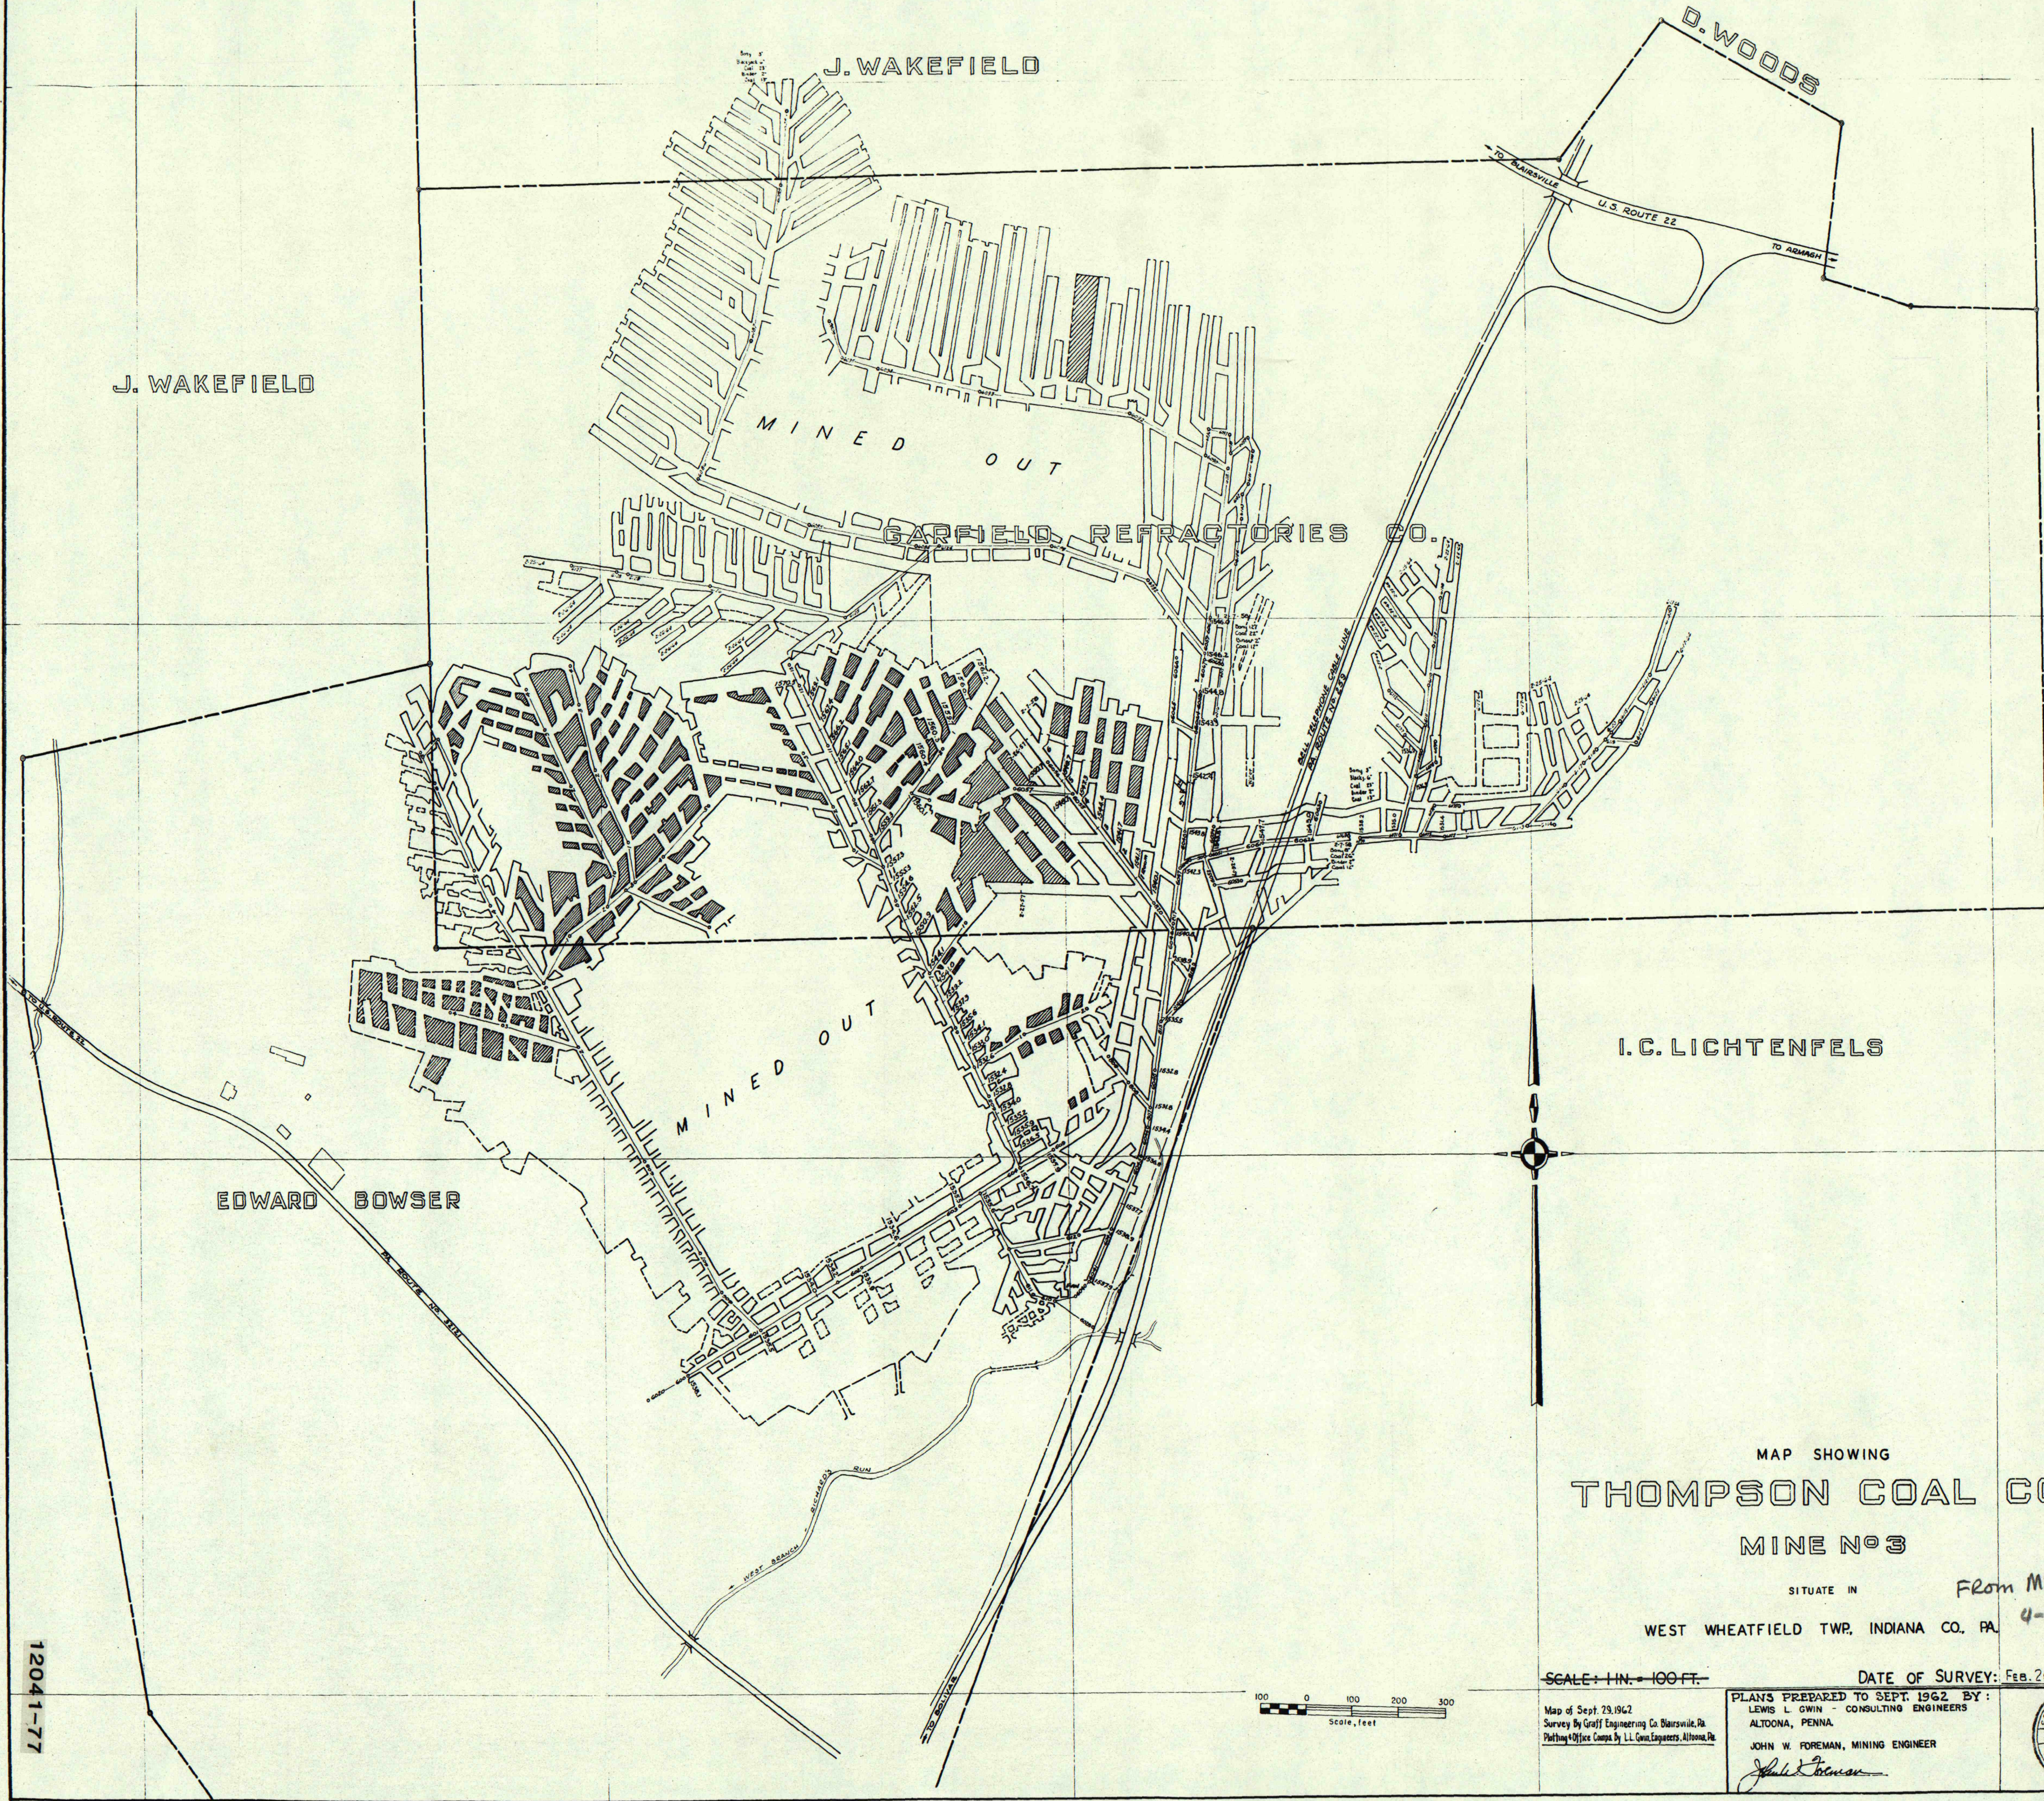

T.S. LYNZ

12041-77

GDF 03071 500 32X 325548