


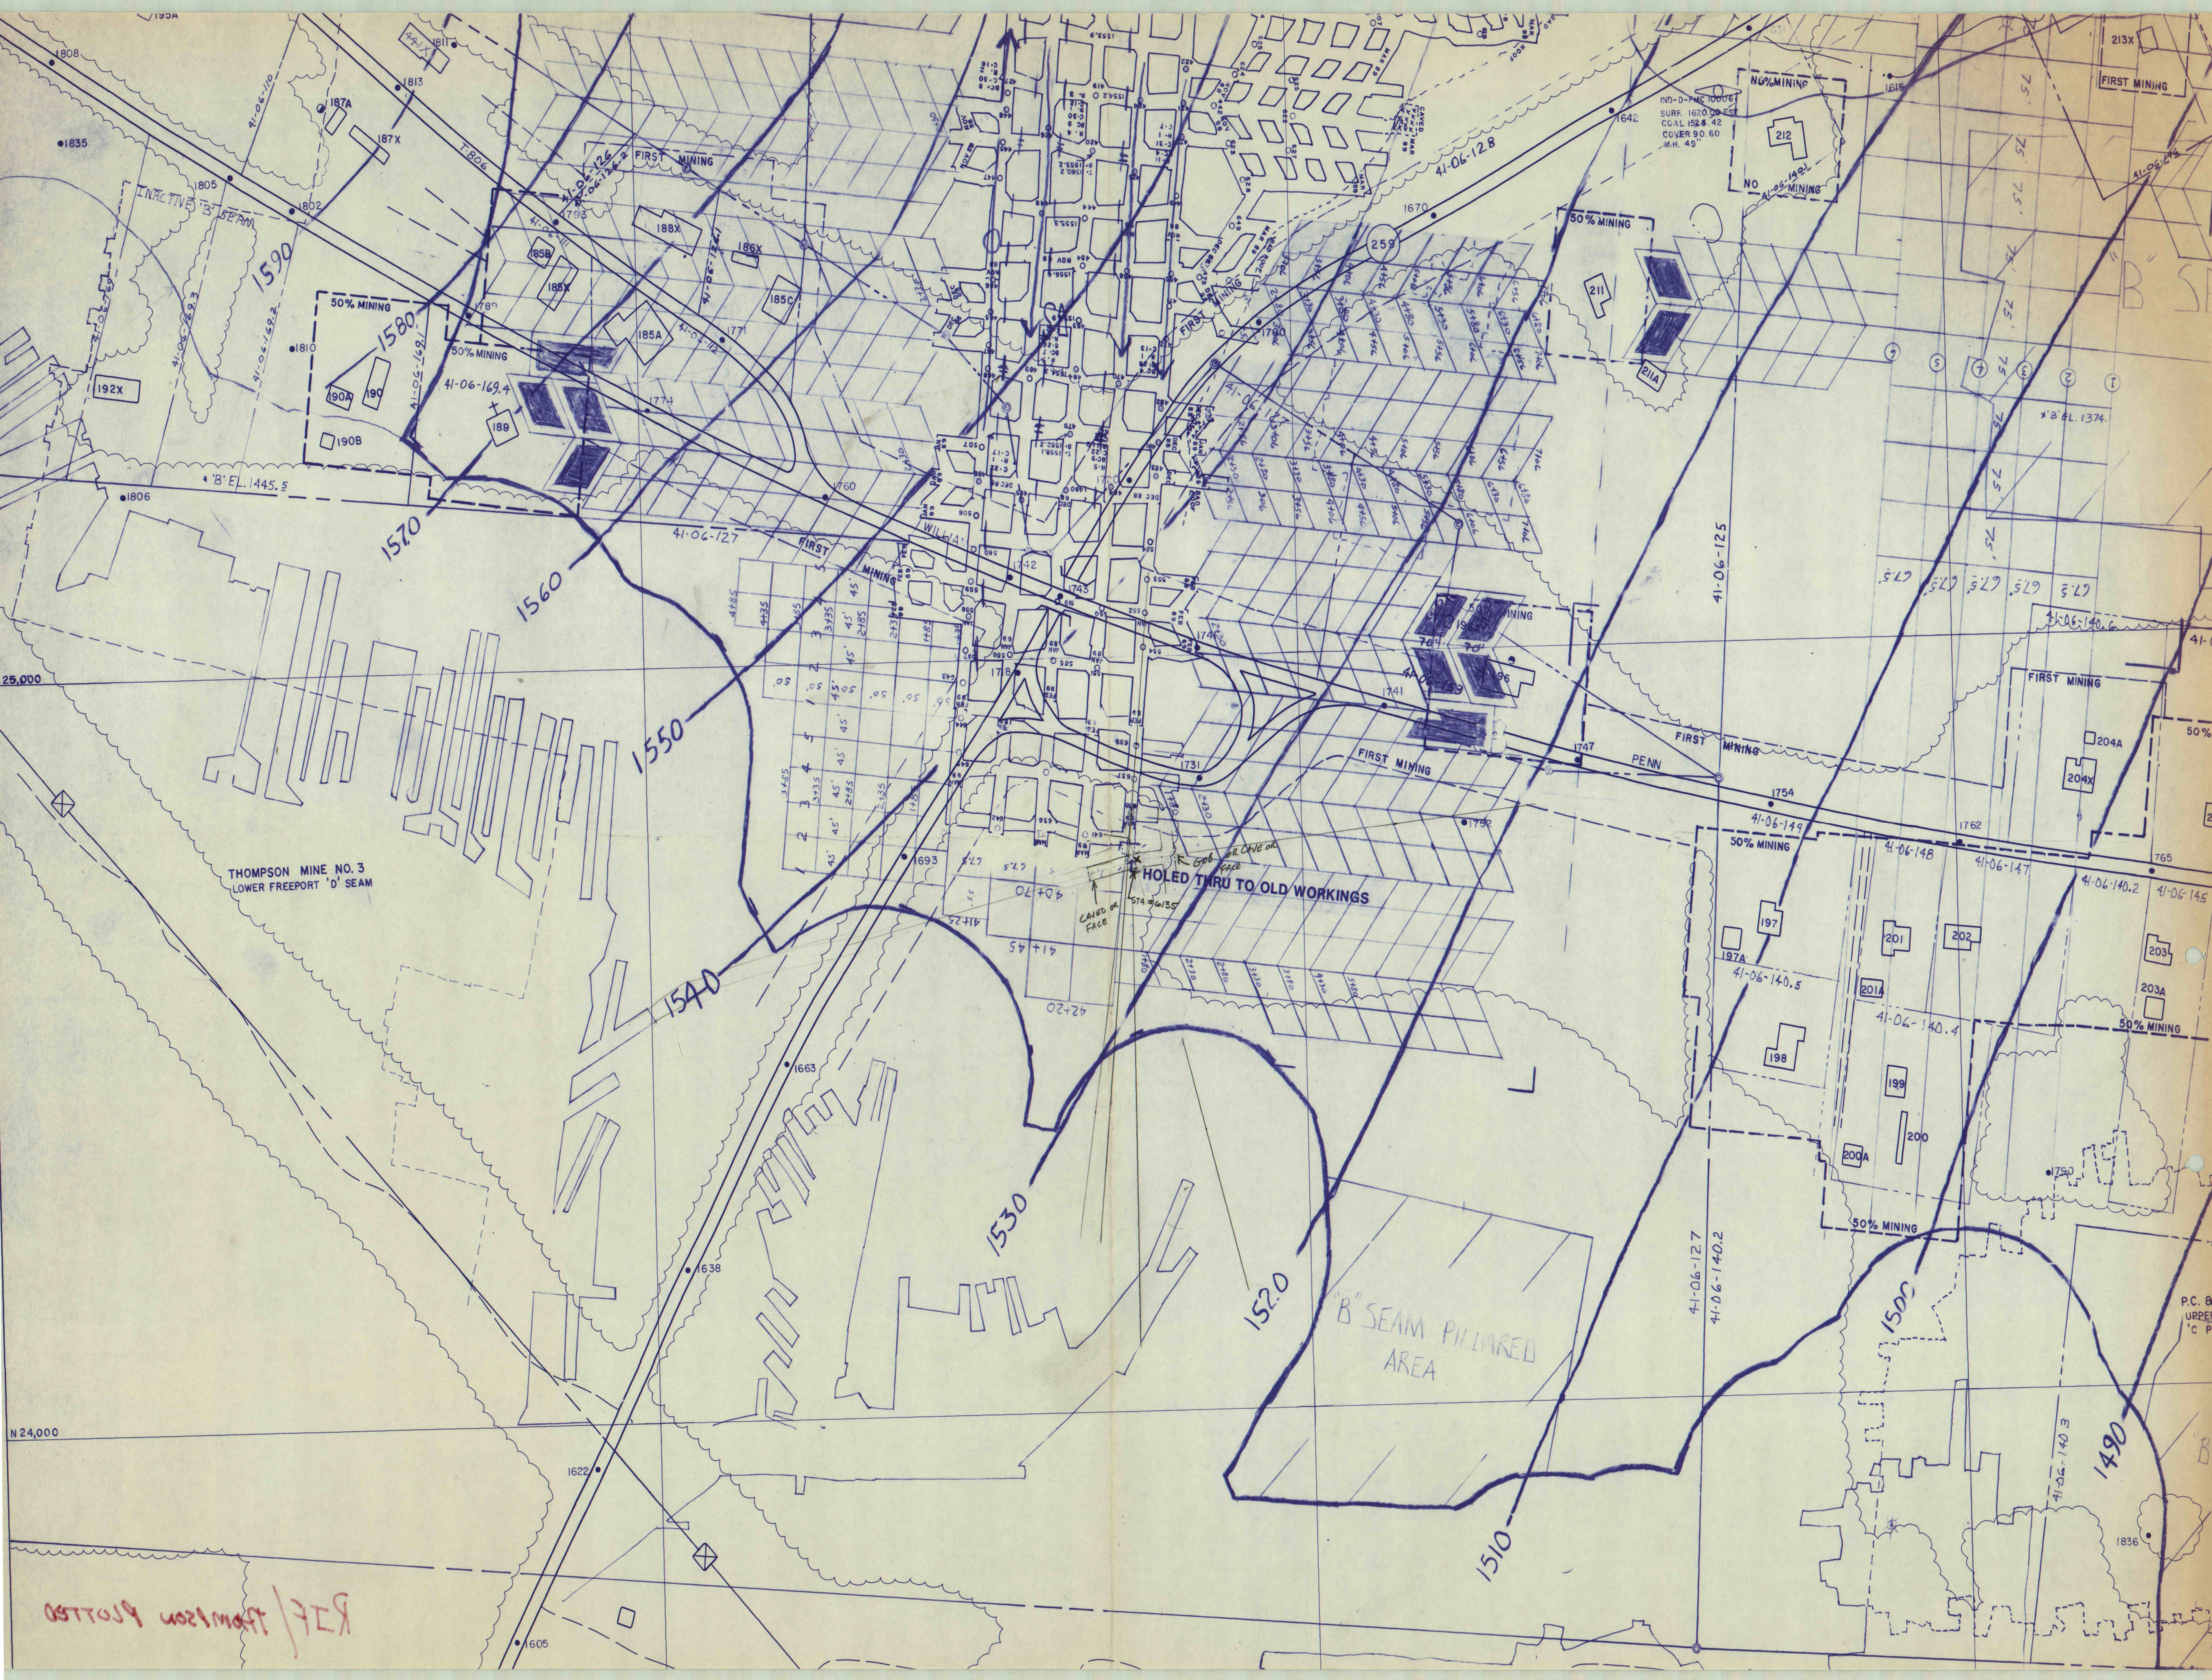

THOMPSON MINE NO. 3
LOWER FREEPORT 'D' SEAM

HOLED THRU TO OLD WORKINGS

B SEAM PILLARED
AREA

