


15580-120  
JJ

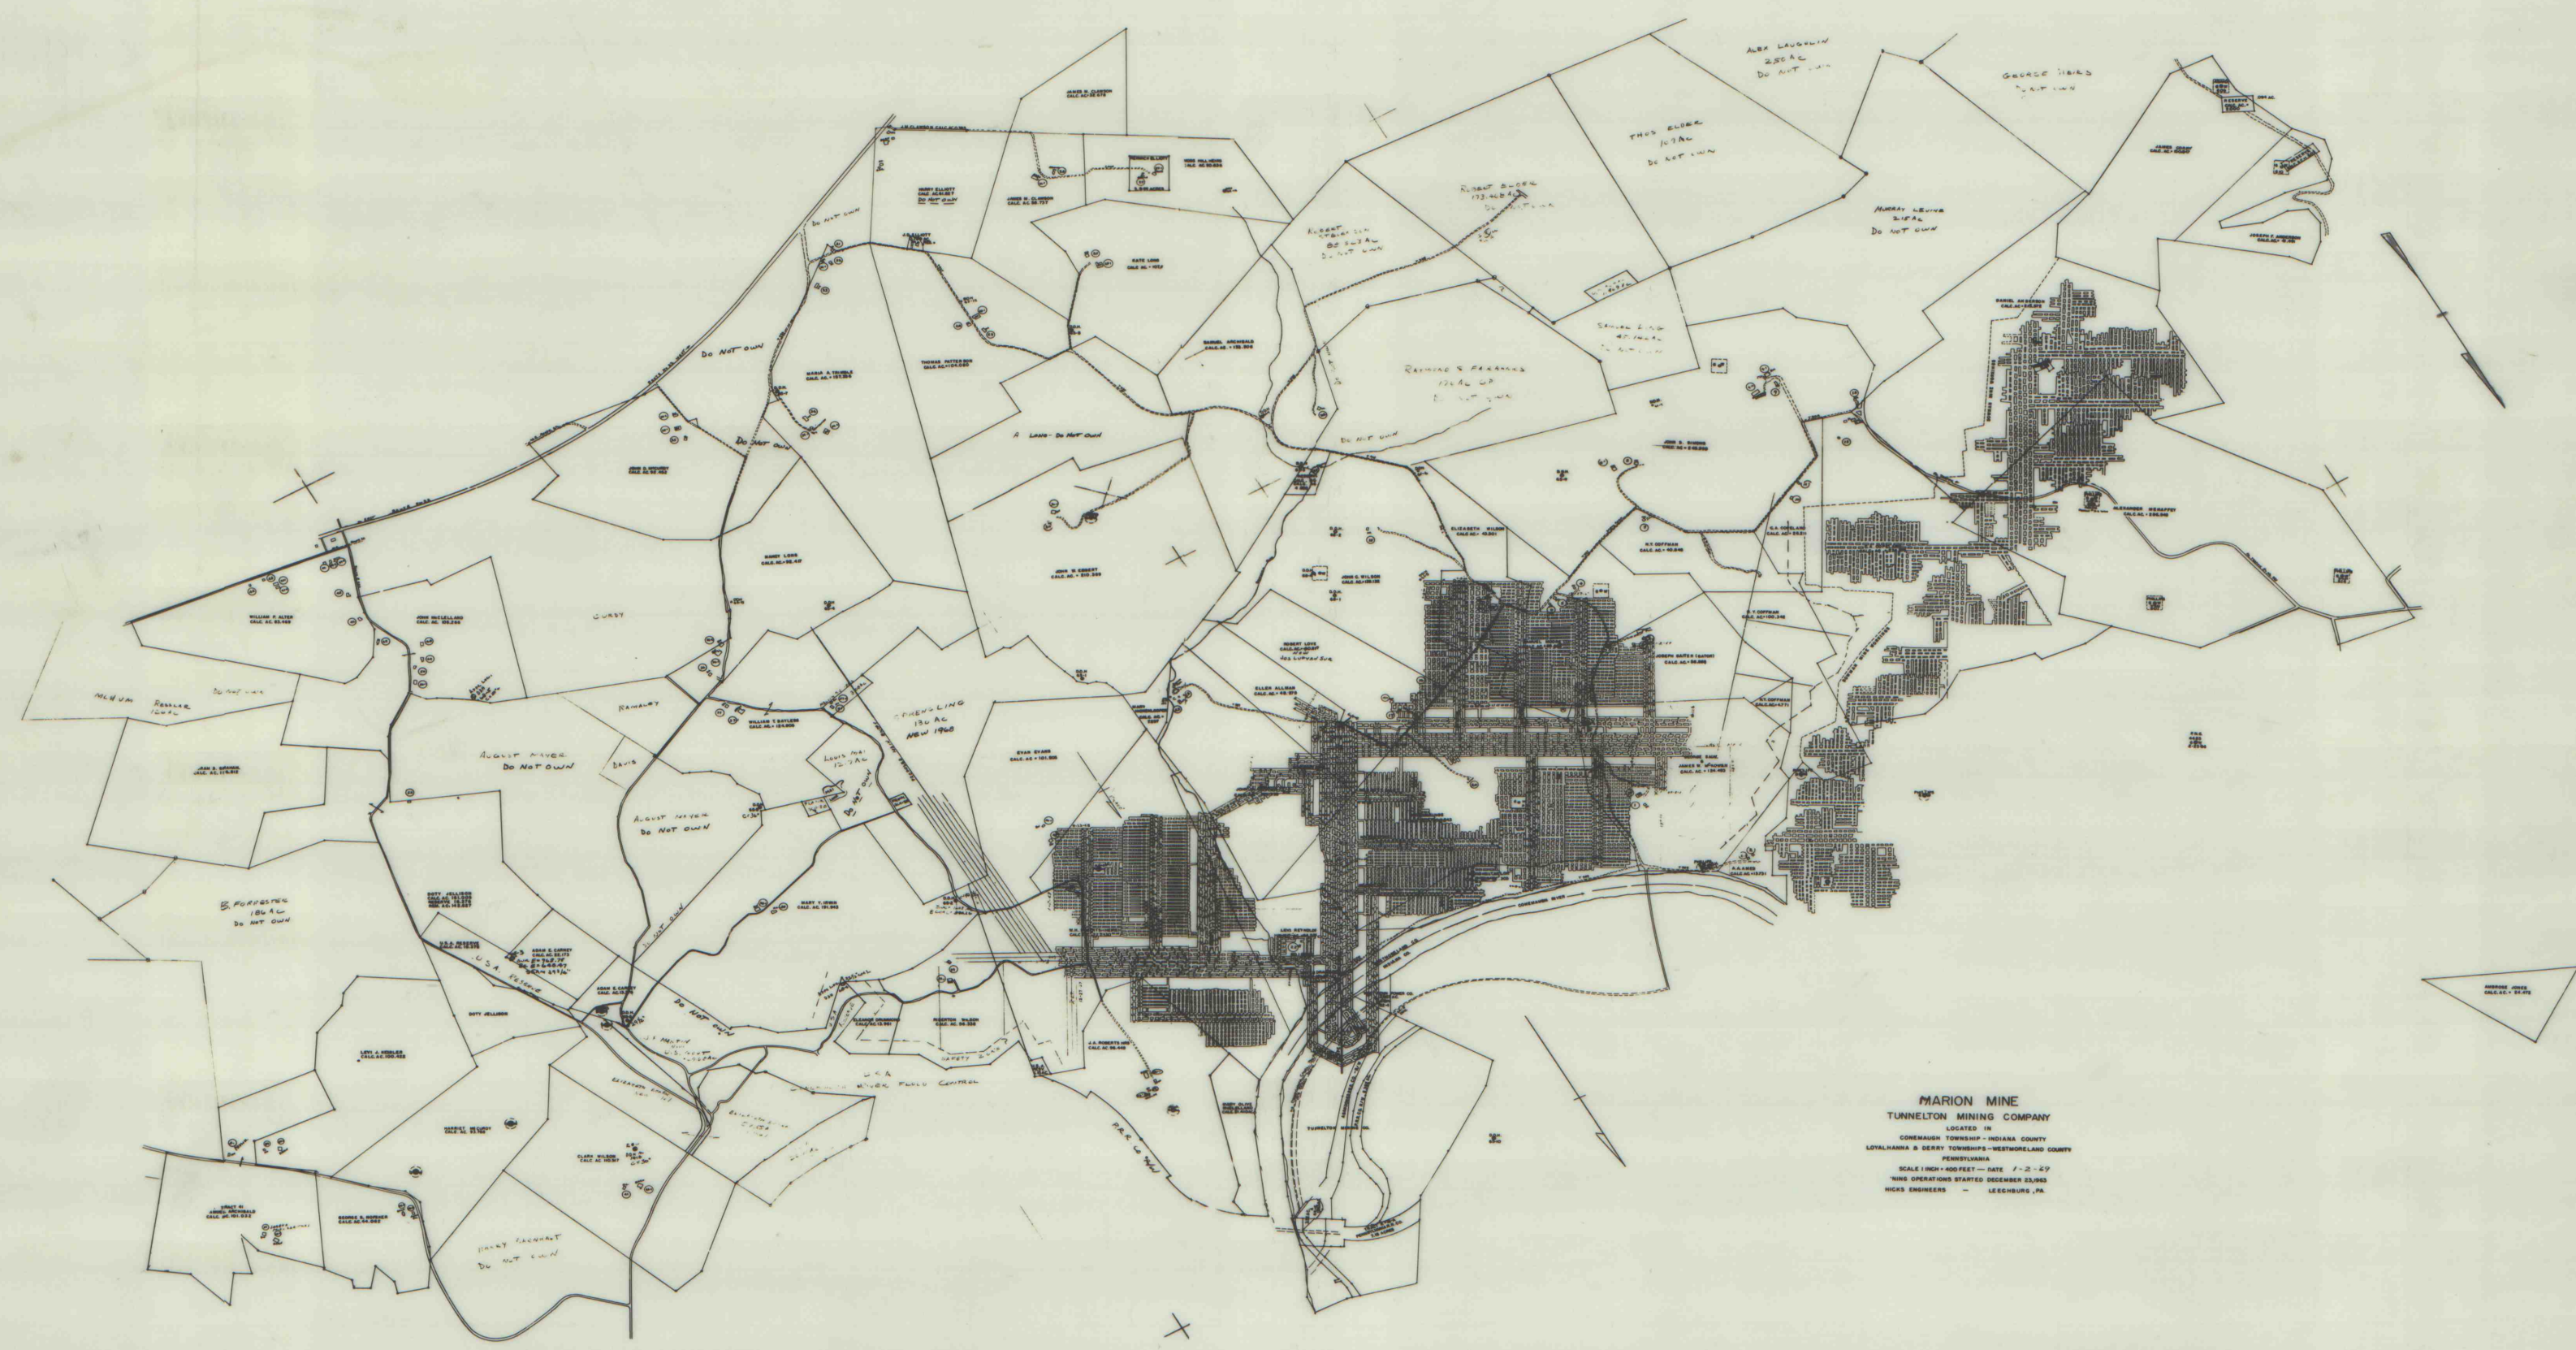

55  
15580-120