


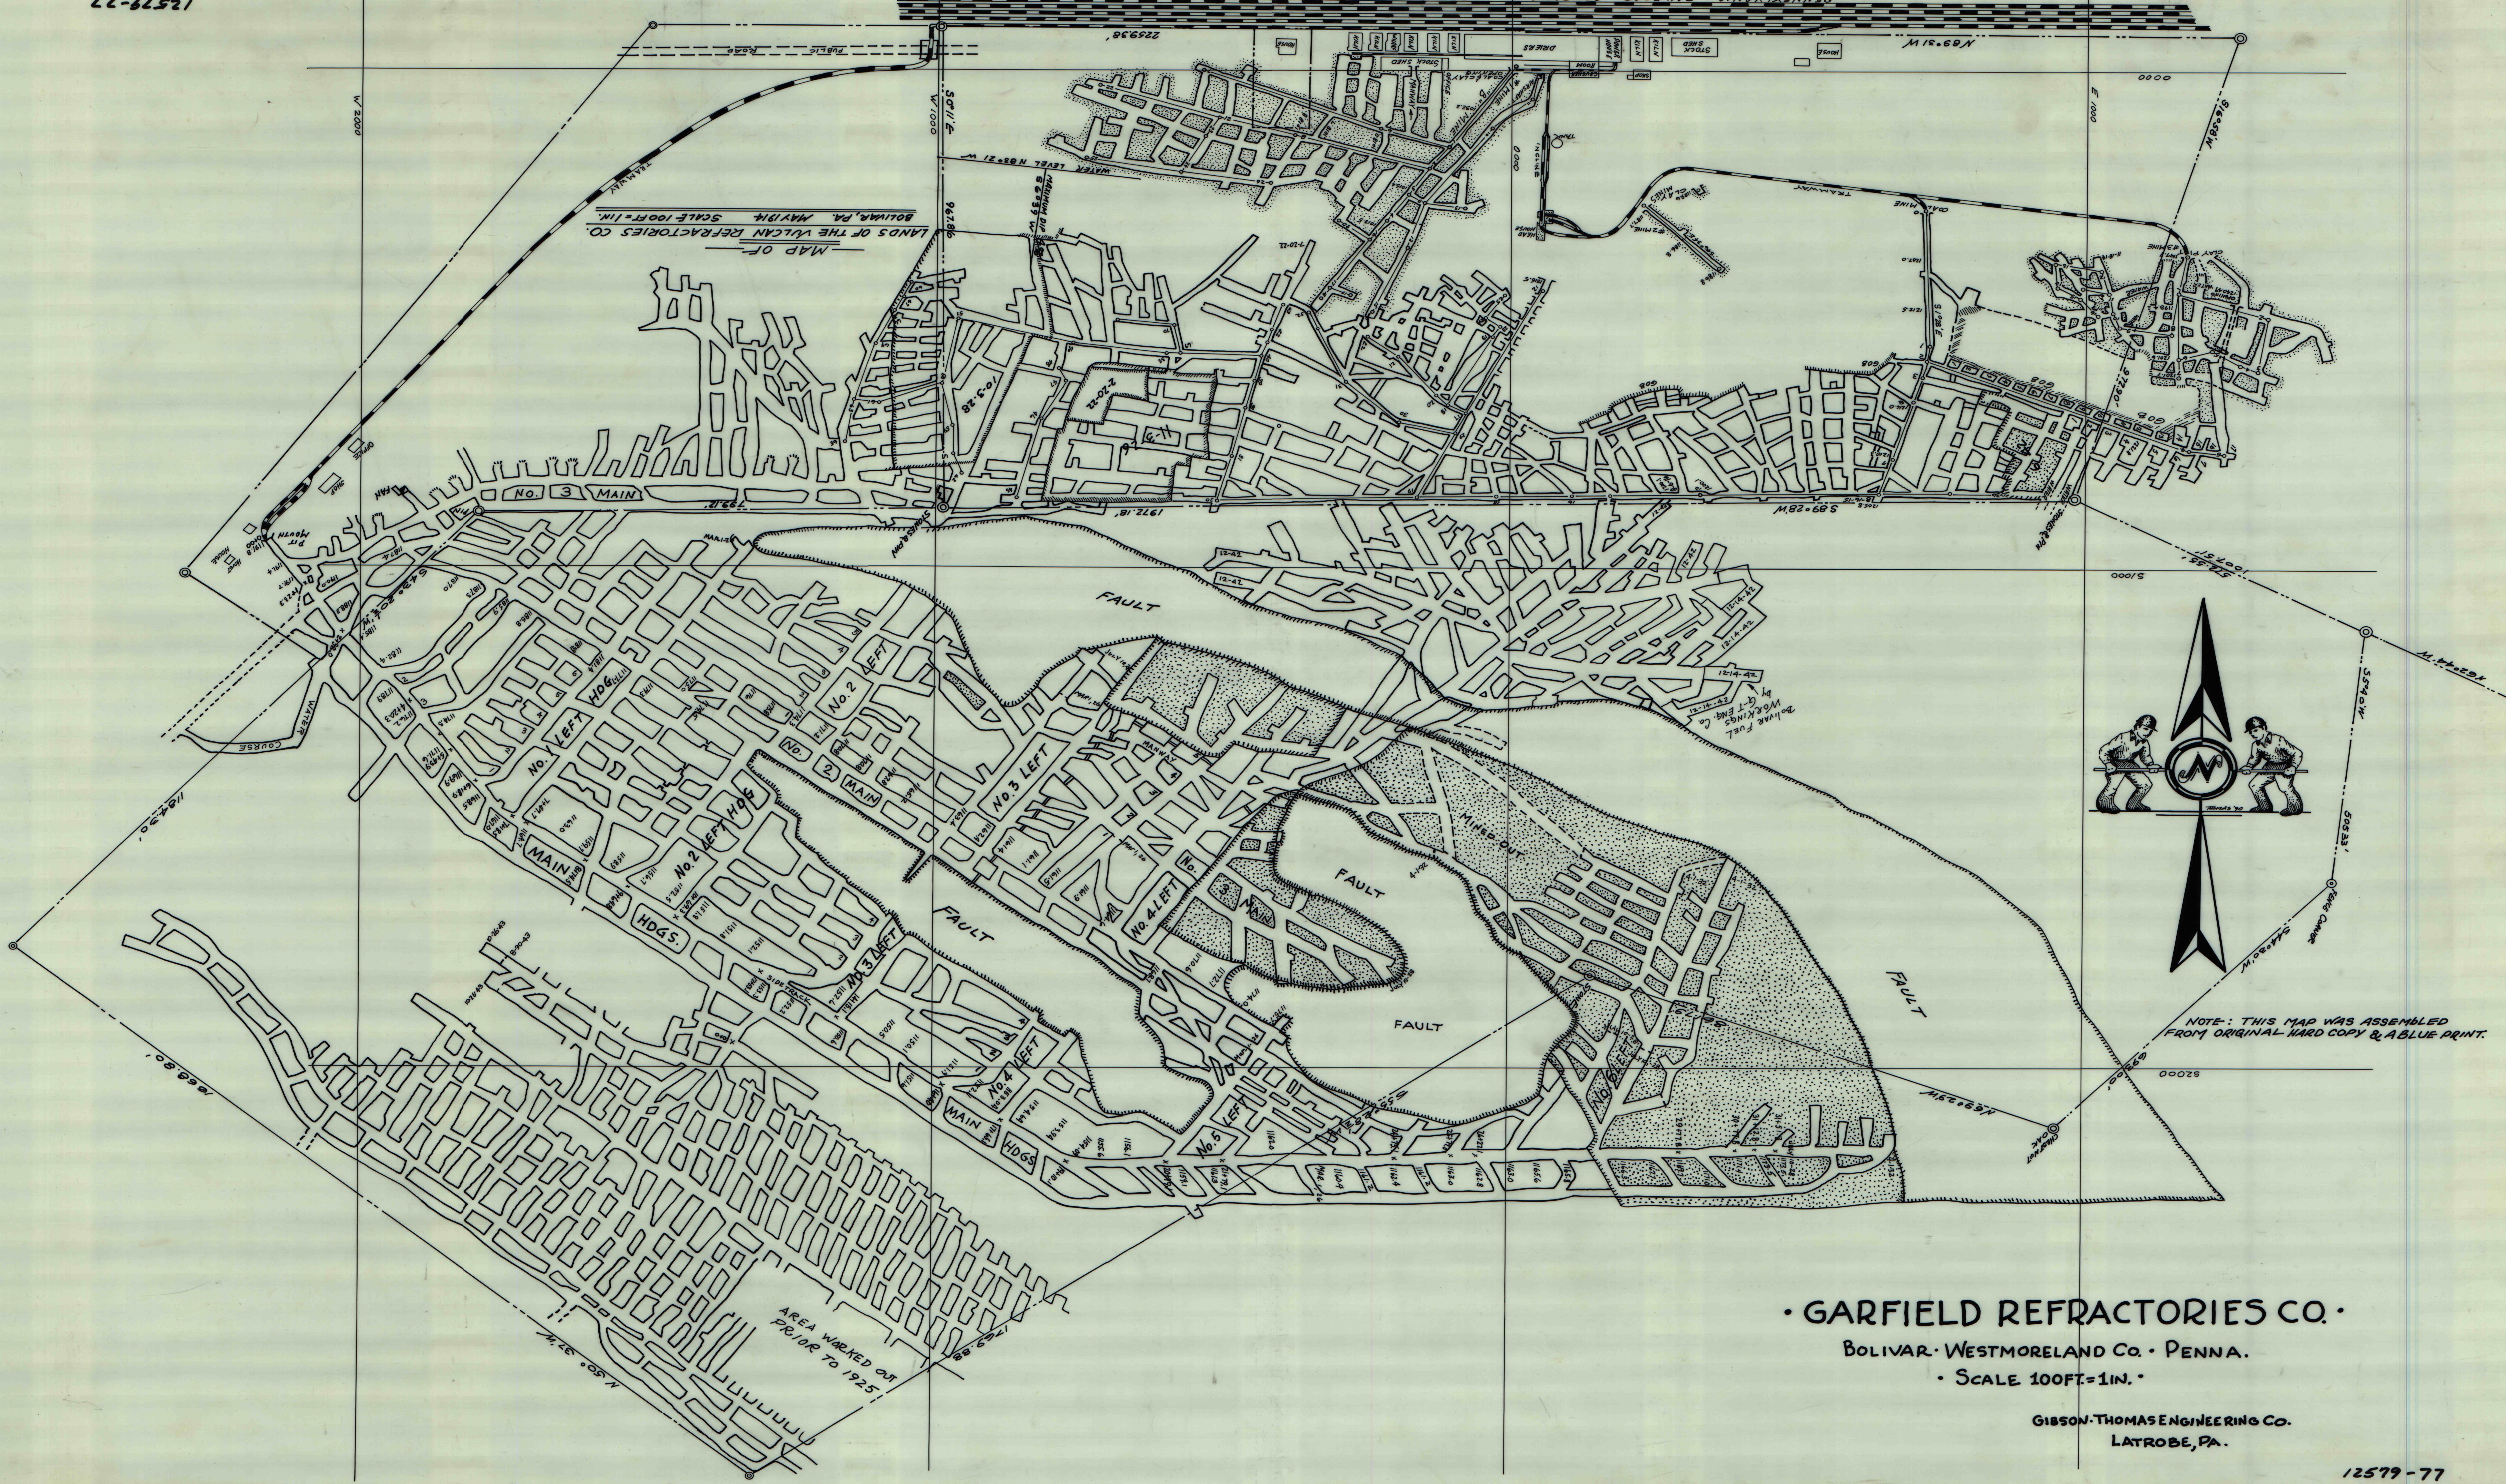

• GARFIELD REFRATORIES CO. •  
BOLIVAR • WESTMORELAND CO. • PENNA.  
• SCALE 100 FT. = 1 IN. •

GIBSON • THOMAS ENGINEERING CO.  
LATROBE, PA.