


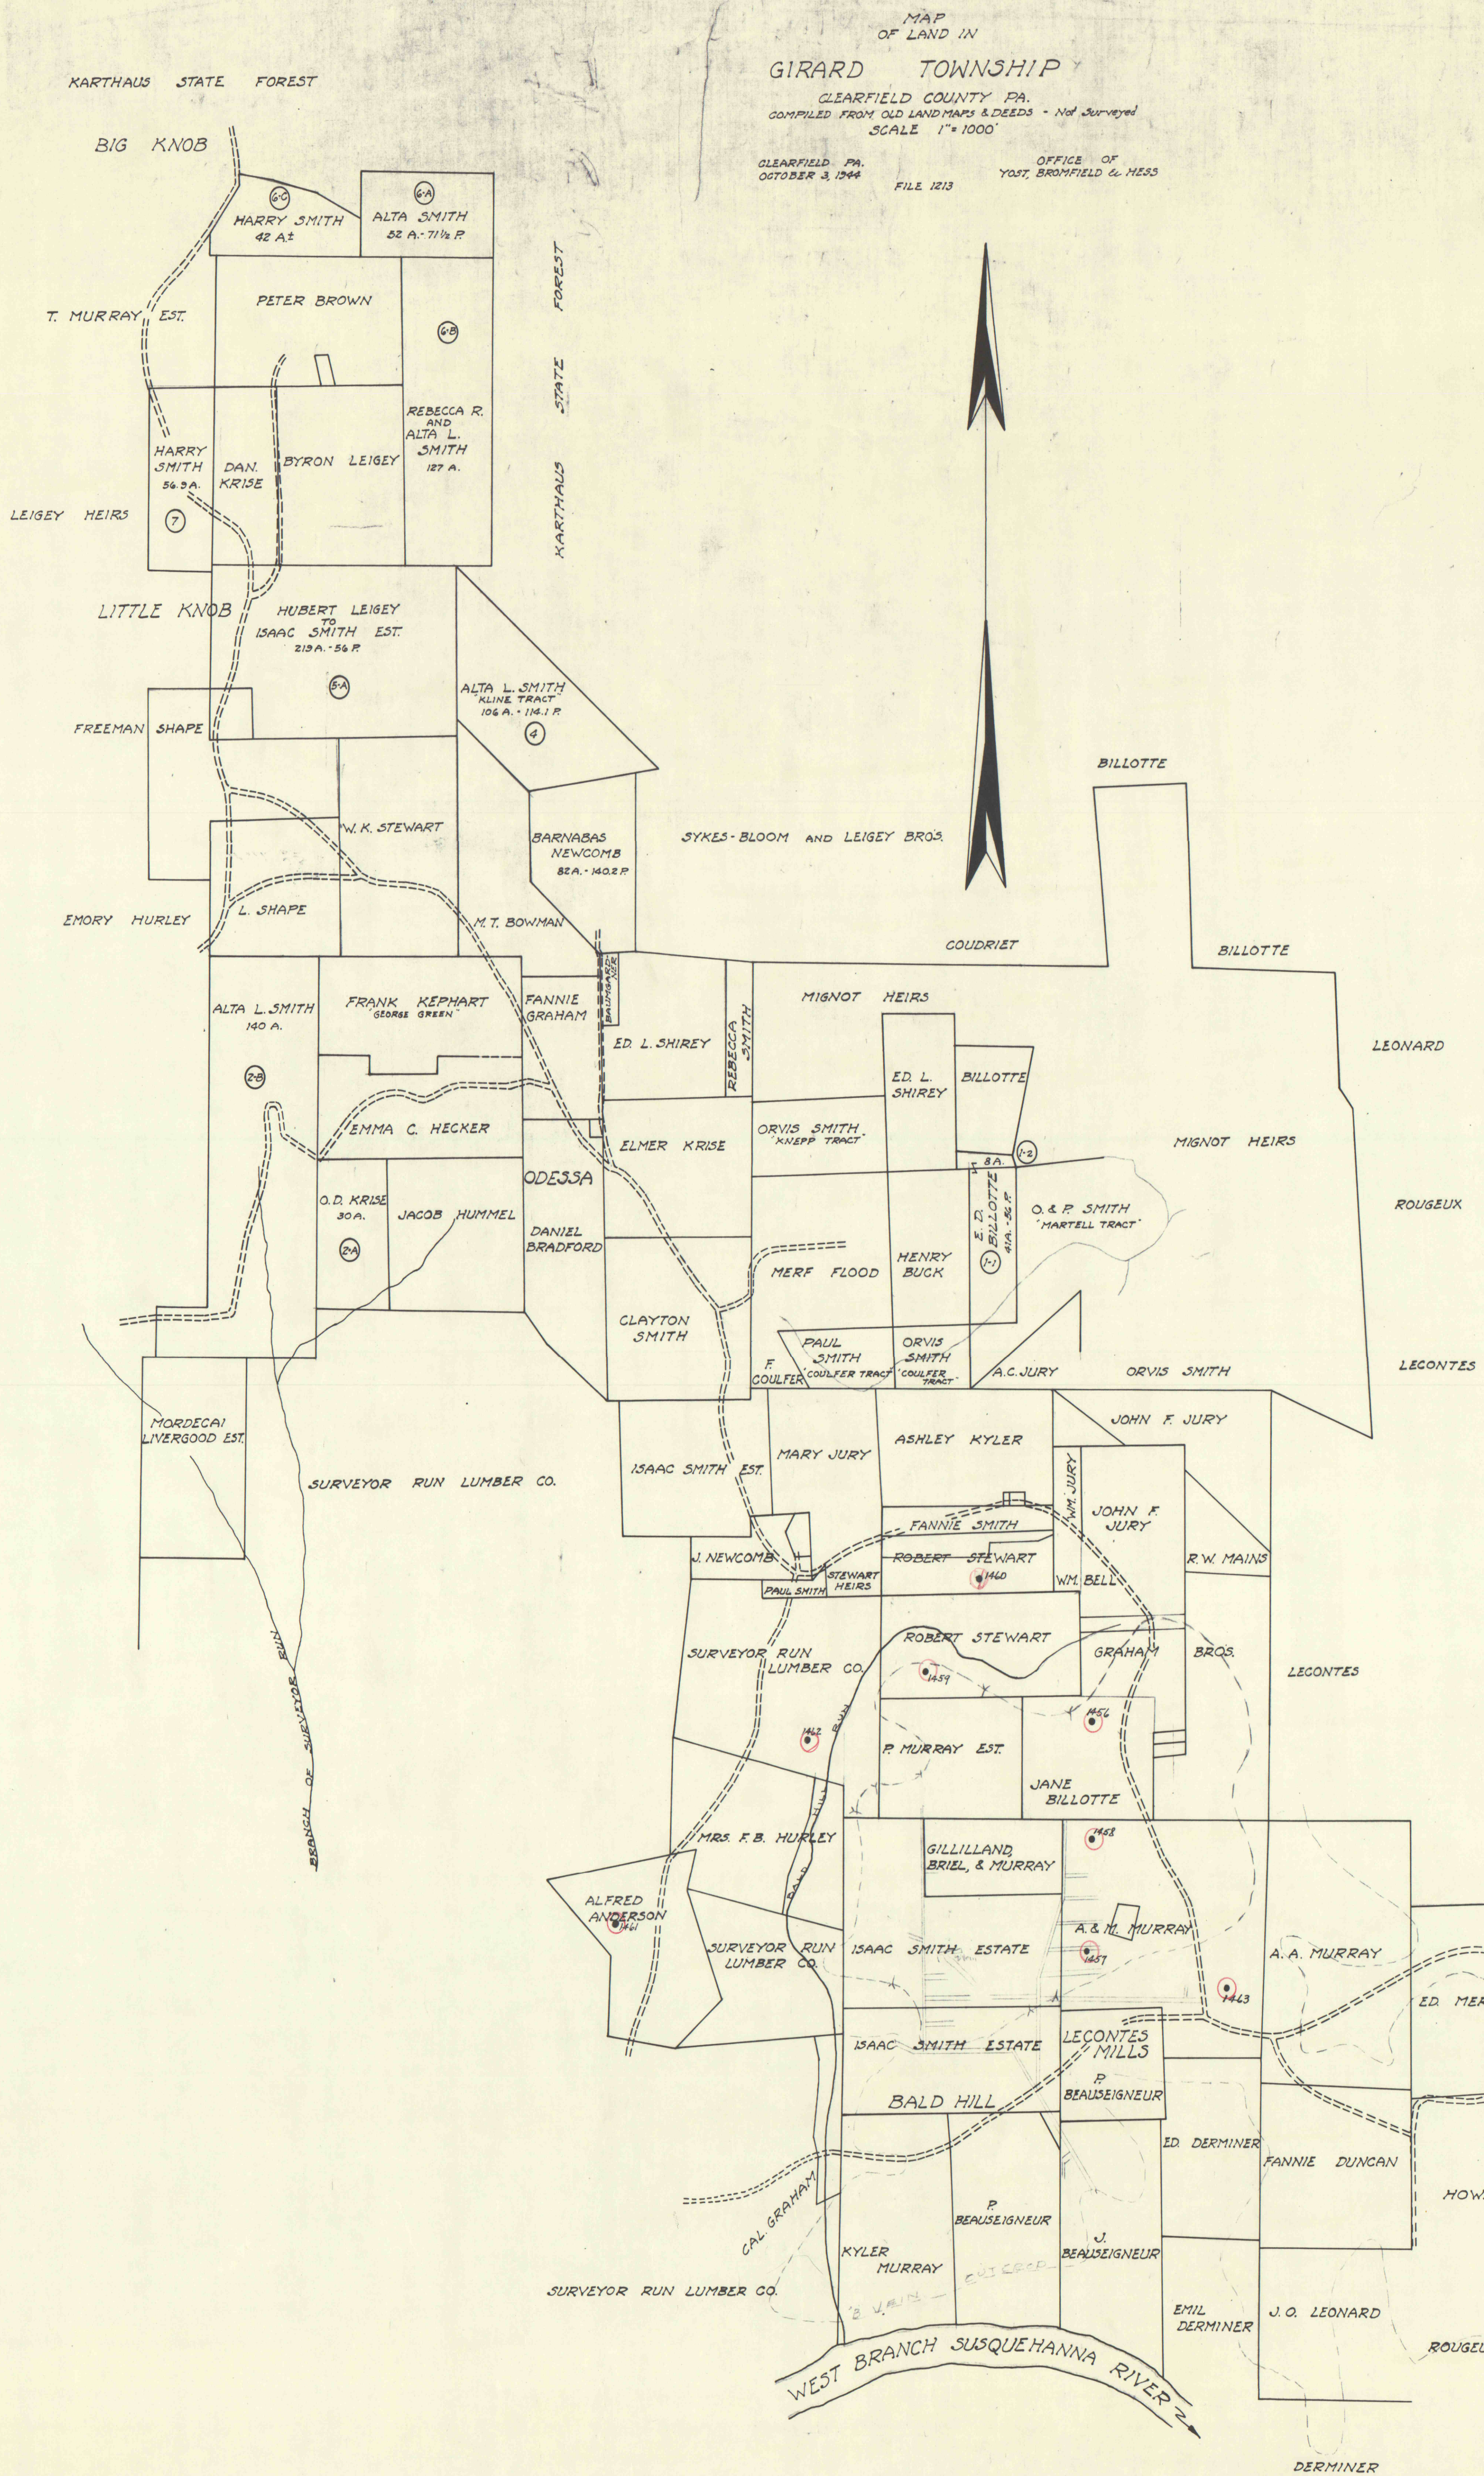

See 400' Print in Data File
Clearfield County - Dealing Holes 1456-1463
Oct 1969
BTHB