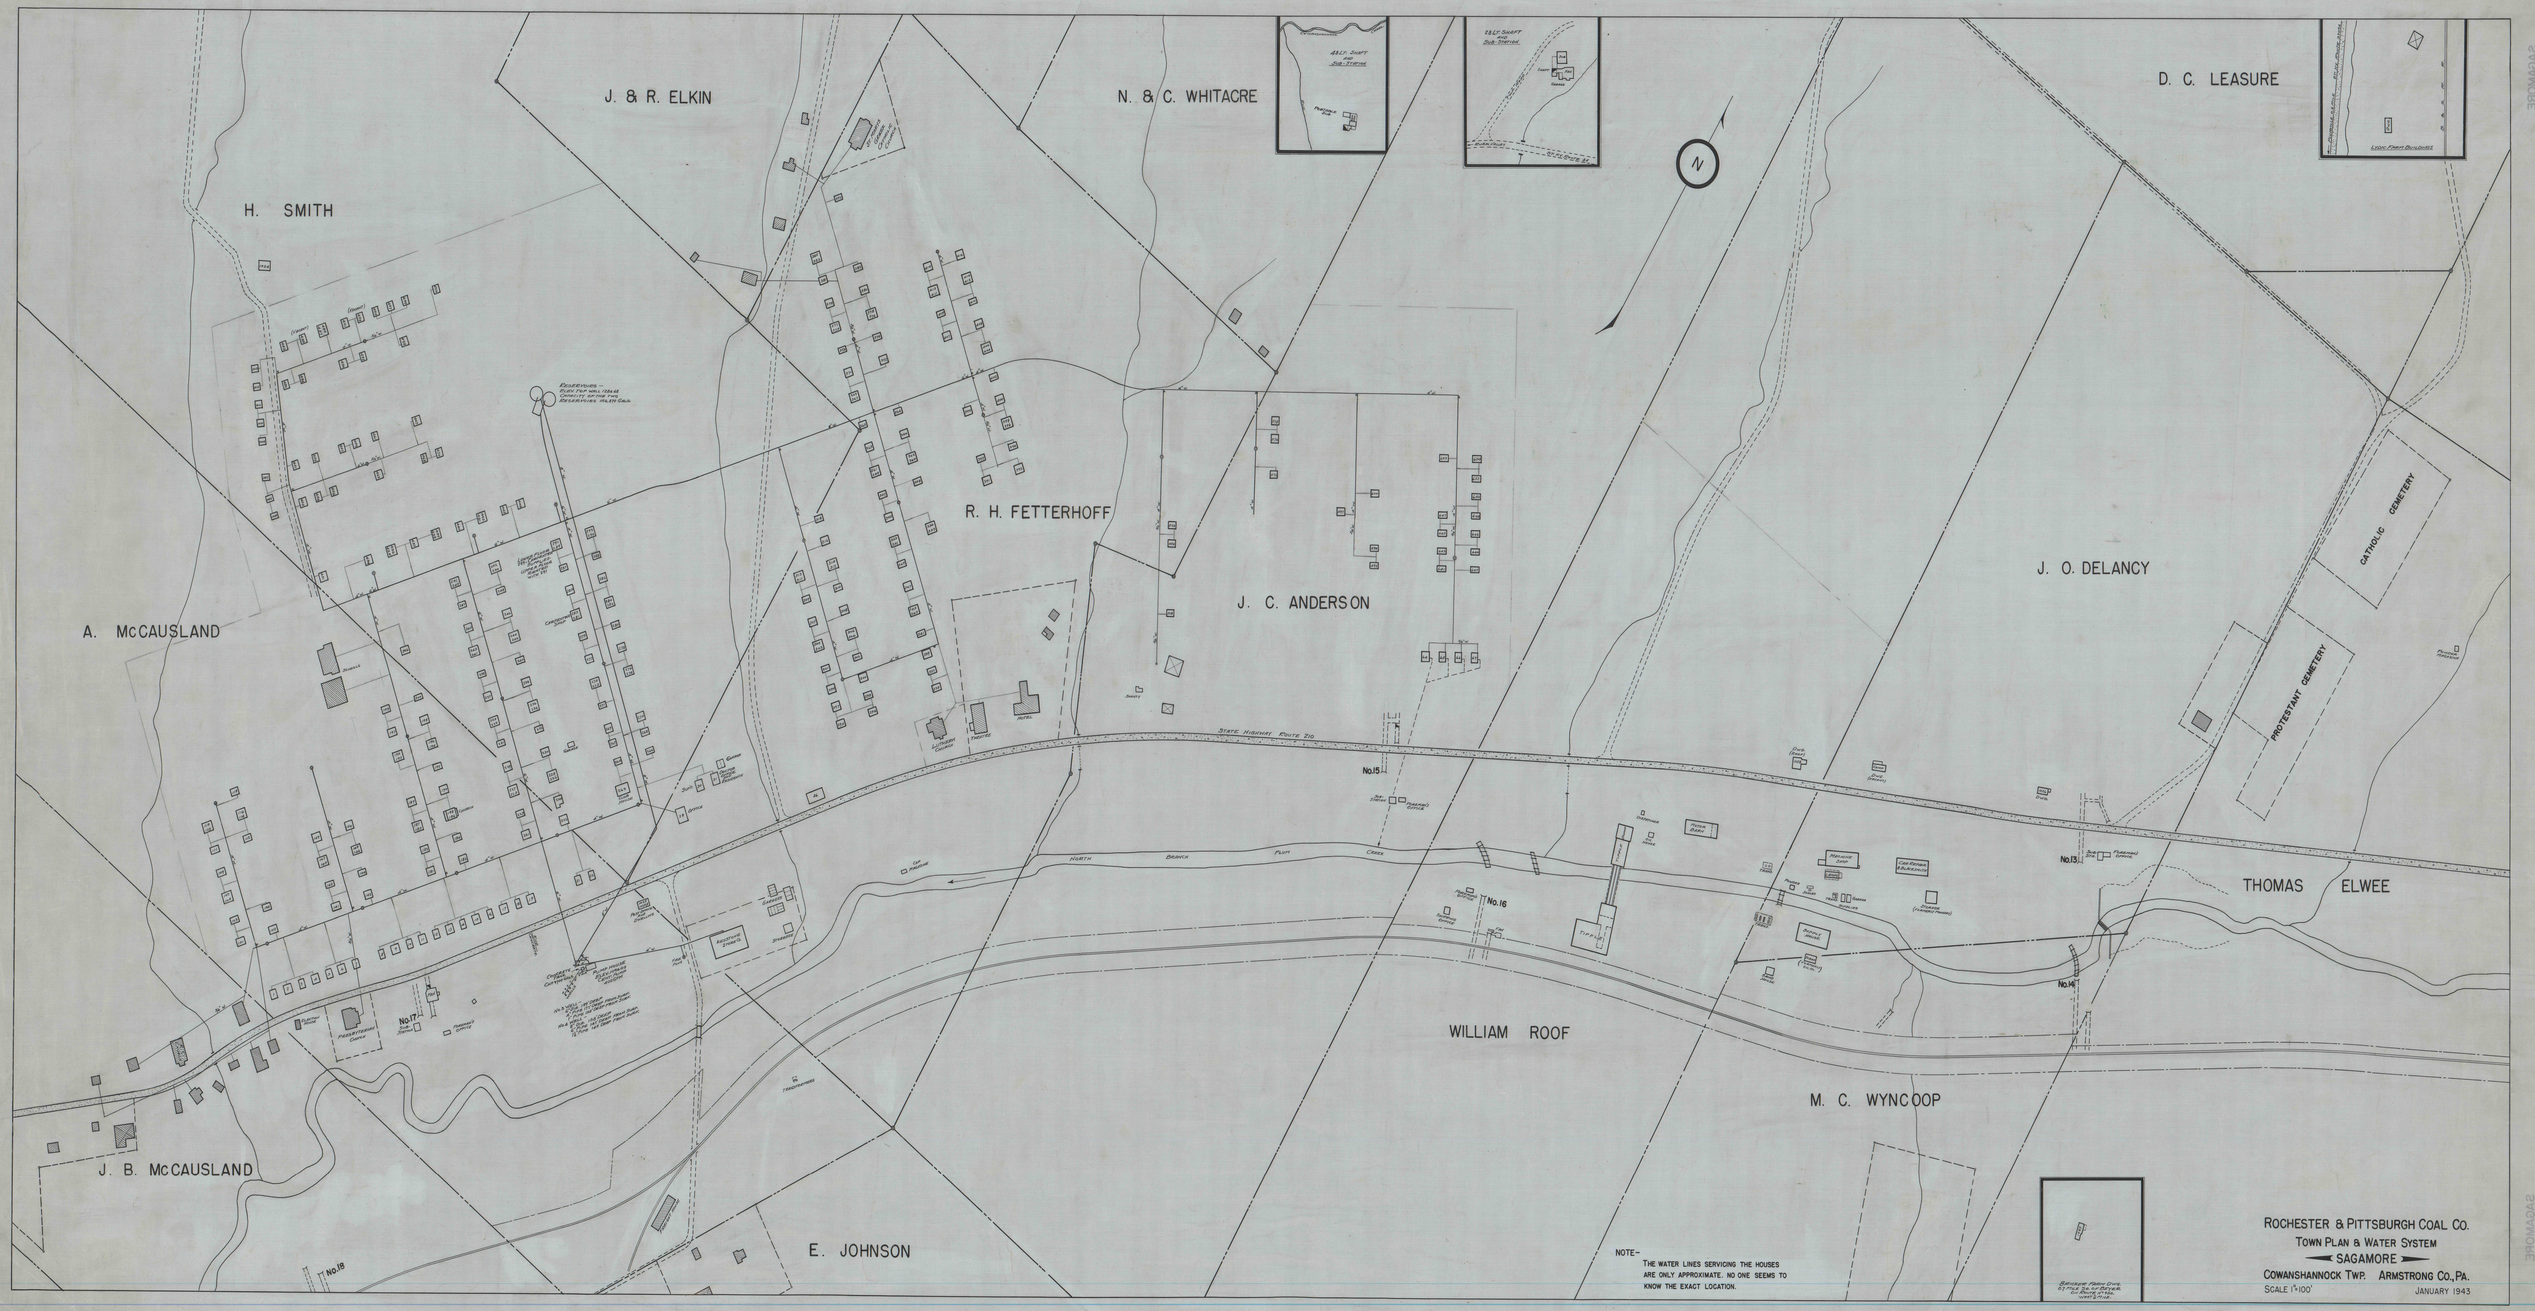

J. & R. ELKIN
N. & C. WHITACRE
D. C. LEASURE
H. SMITH
R. H. FETTERHOFF
J. C. ANDERSON
J. O. DELANCY
A. McCAUSLAND
CATHOLIC CEMETERY
PROTESTANT CEMETERY
STATE HIGHWAY ROUTE 210
NORTH BEAVER RUN CREEK
THOMAS ELWEE
WILLIAM ROOF
M. C. WYNCOOP
J. B. McCAUSLAND
E. JOHNSON
No.13
No.14
No.15
No.16
No.17
No.18
N
NOTE- THE WATER LINES SERVICING THE HOUSES ARE ONLY APPROXIMATE. NO ONE SEEMS TO KNOW THE EXACT LOCATION.
ROCHESTER & PITTSBURGH COAL CO.
TOWN PLAN & WATER SYSTEM
SAGAMORE
COWANSHANNOCK TWP. ARMSTRONG CO., PA.
SCALE 1"=100'
JANUARY 1943