



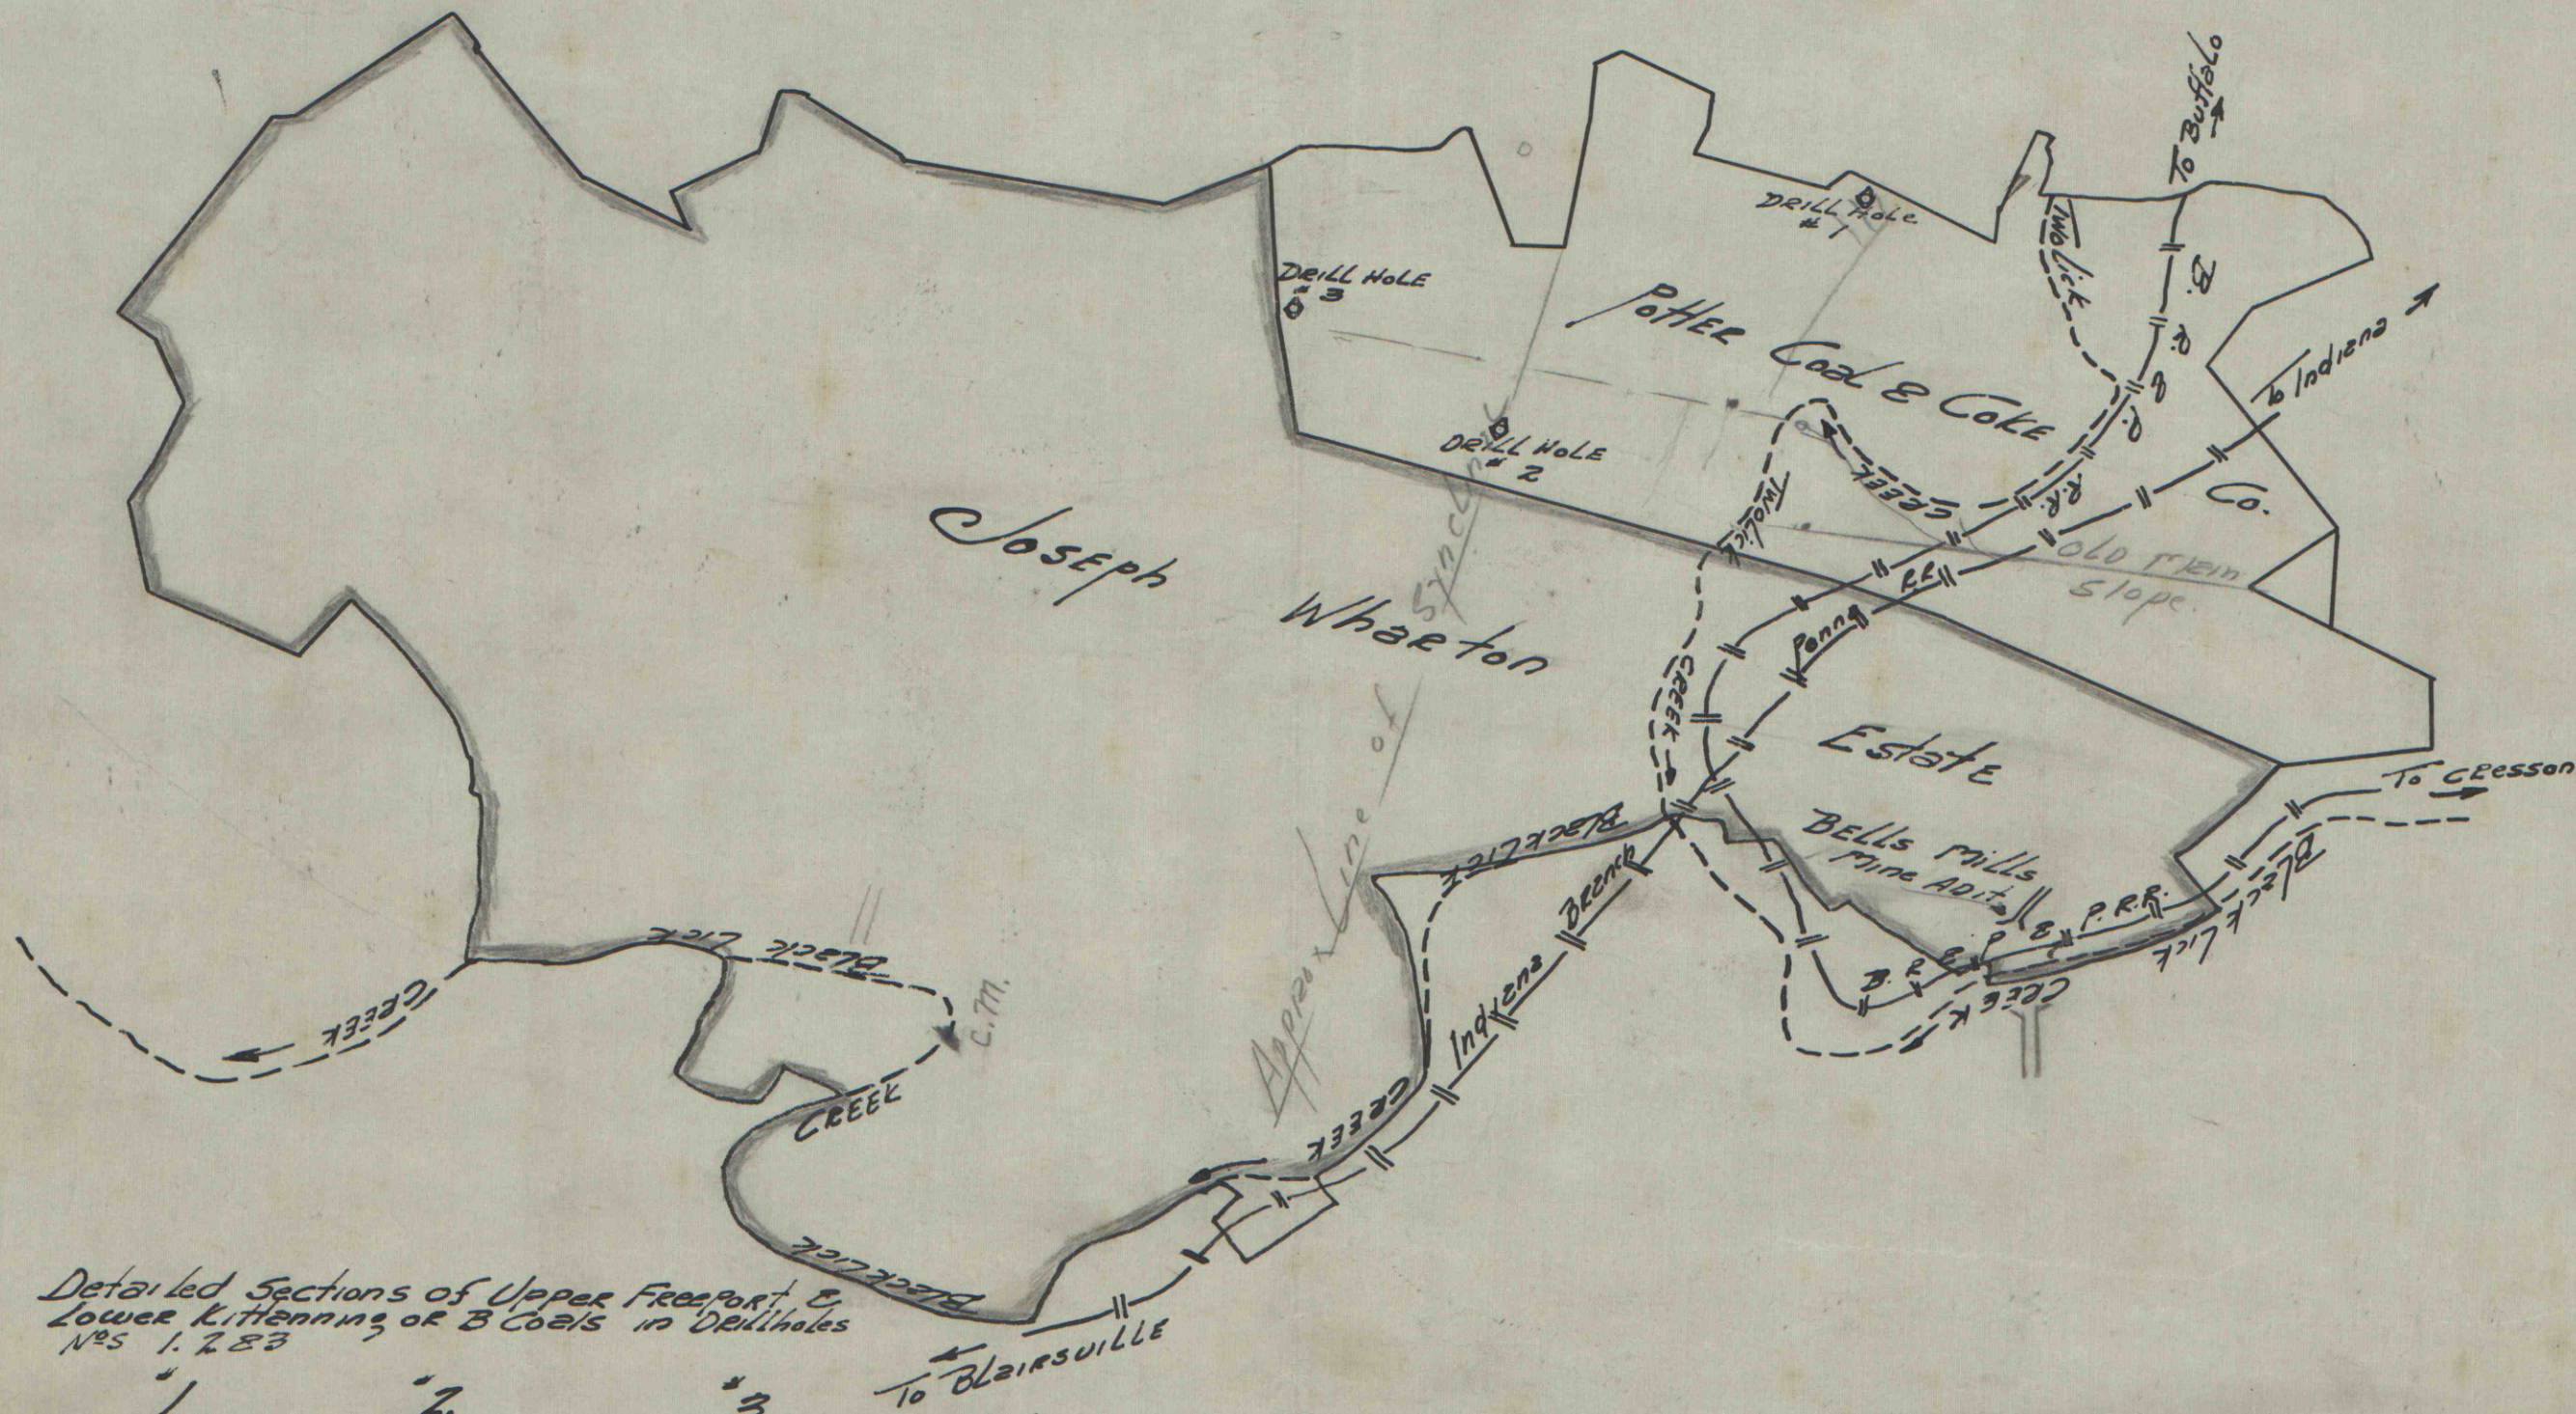

Detailed Sections of Upper Freeport & Lower Kittanning or B Coals in Drillholes Nos 1, 2 & 3

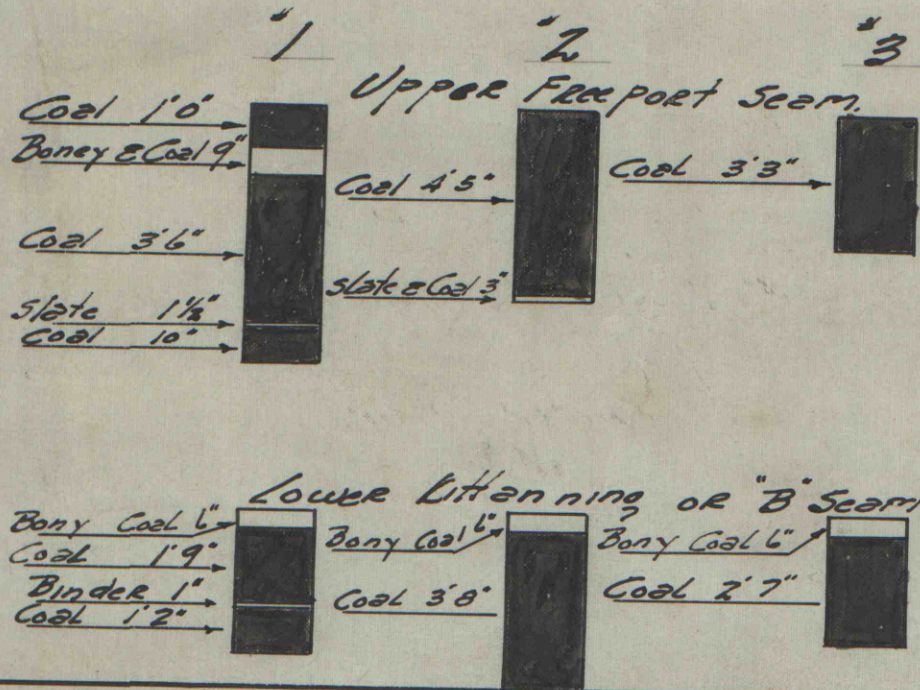

Analyses			ash	Sulphur
Upper Bench	D.H. #1	8.56	11.05	4.14

Sketch Map

Showing some data on Estate of Joseph Wharton in Center, Burrell & Blacklick Townships Indiana County, Pa.
Scale 1" = 2500'. FEB. 24-1931.
Jas. L. Kinter, Engr.