


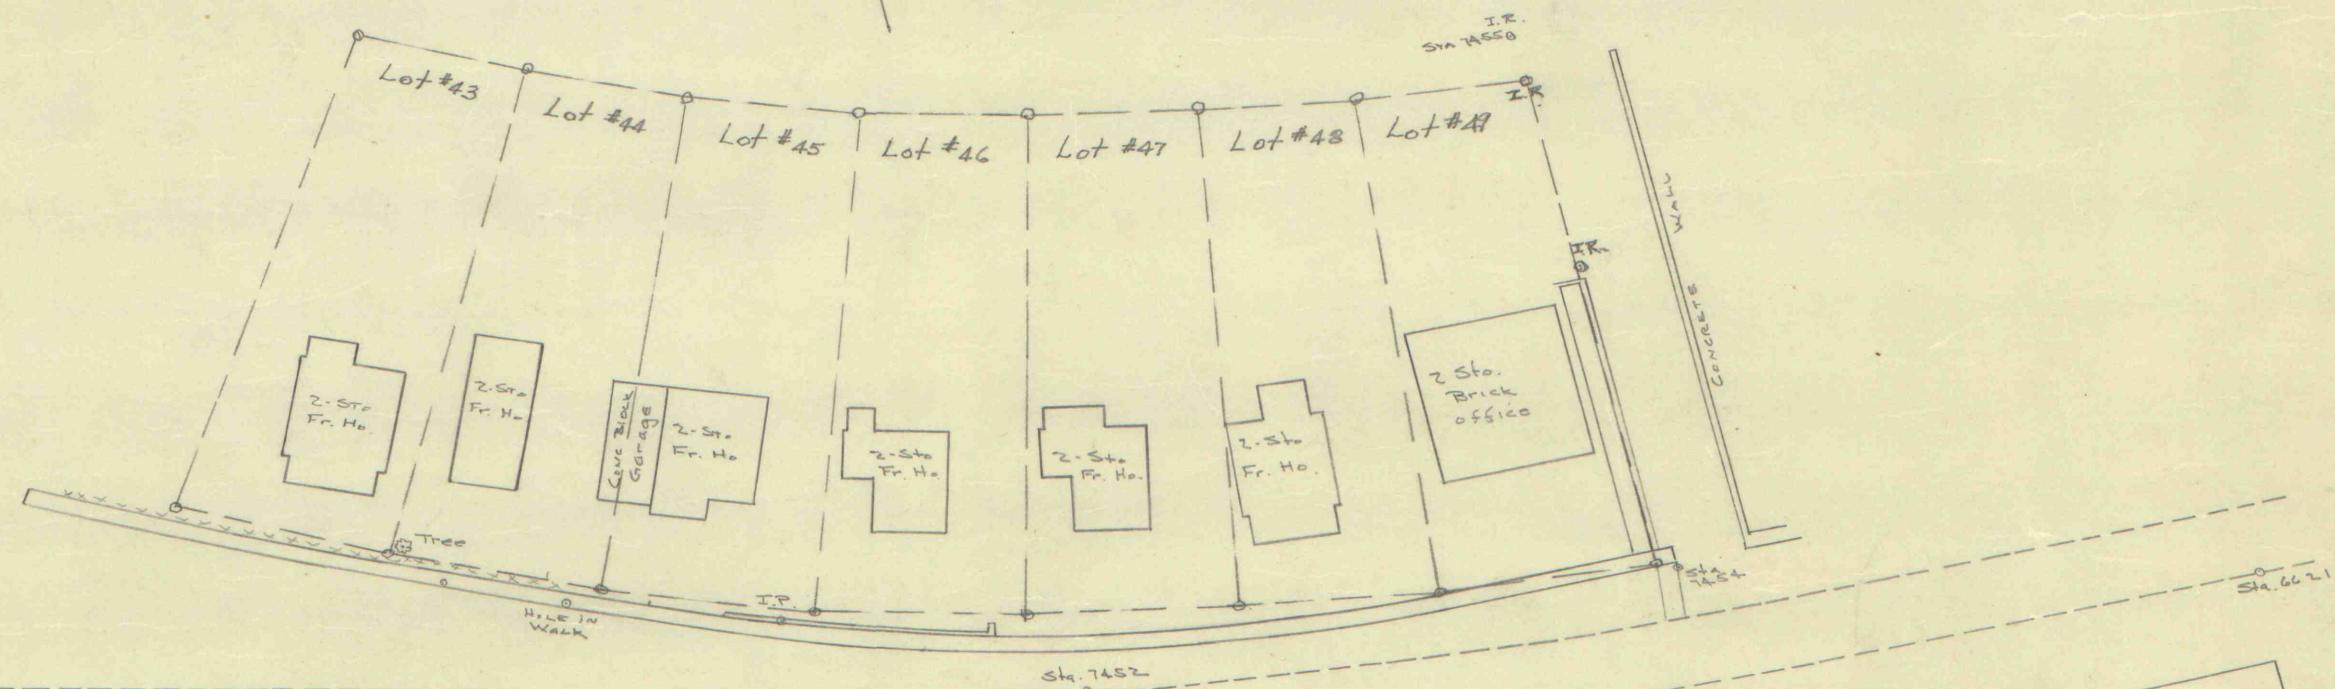

SCALE 1"=50'