


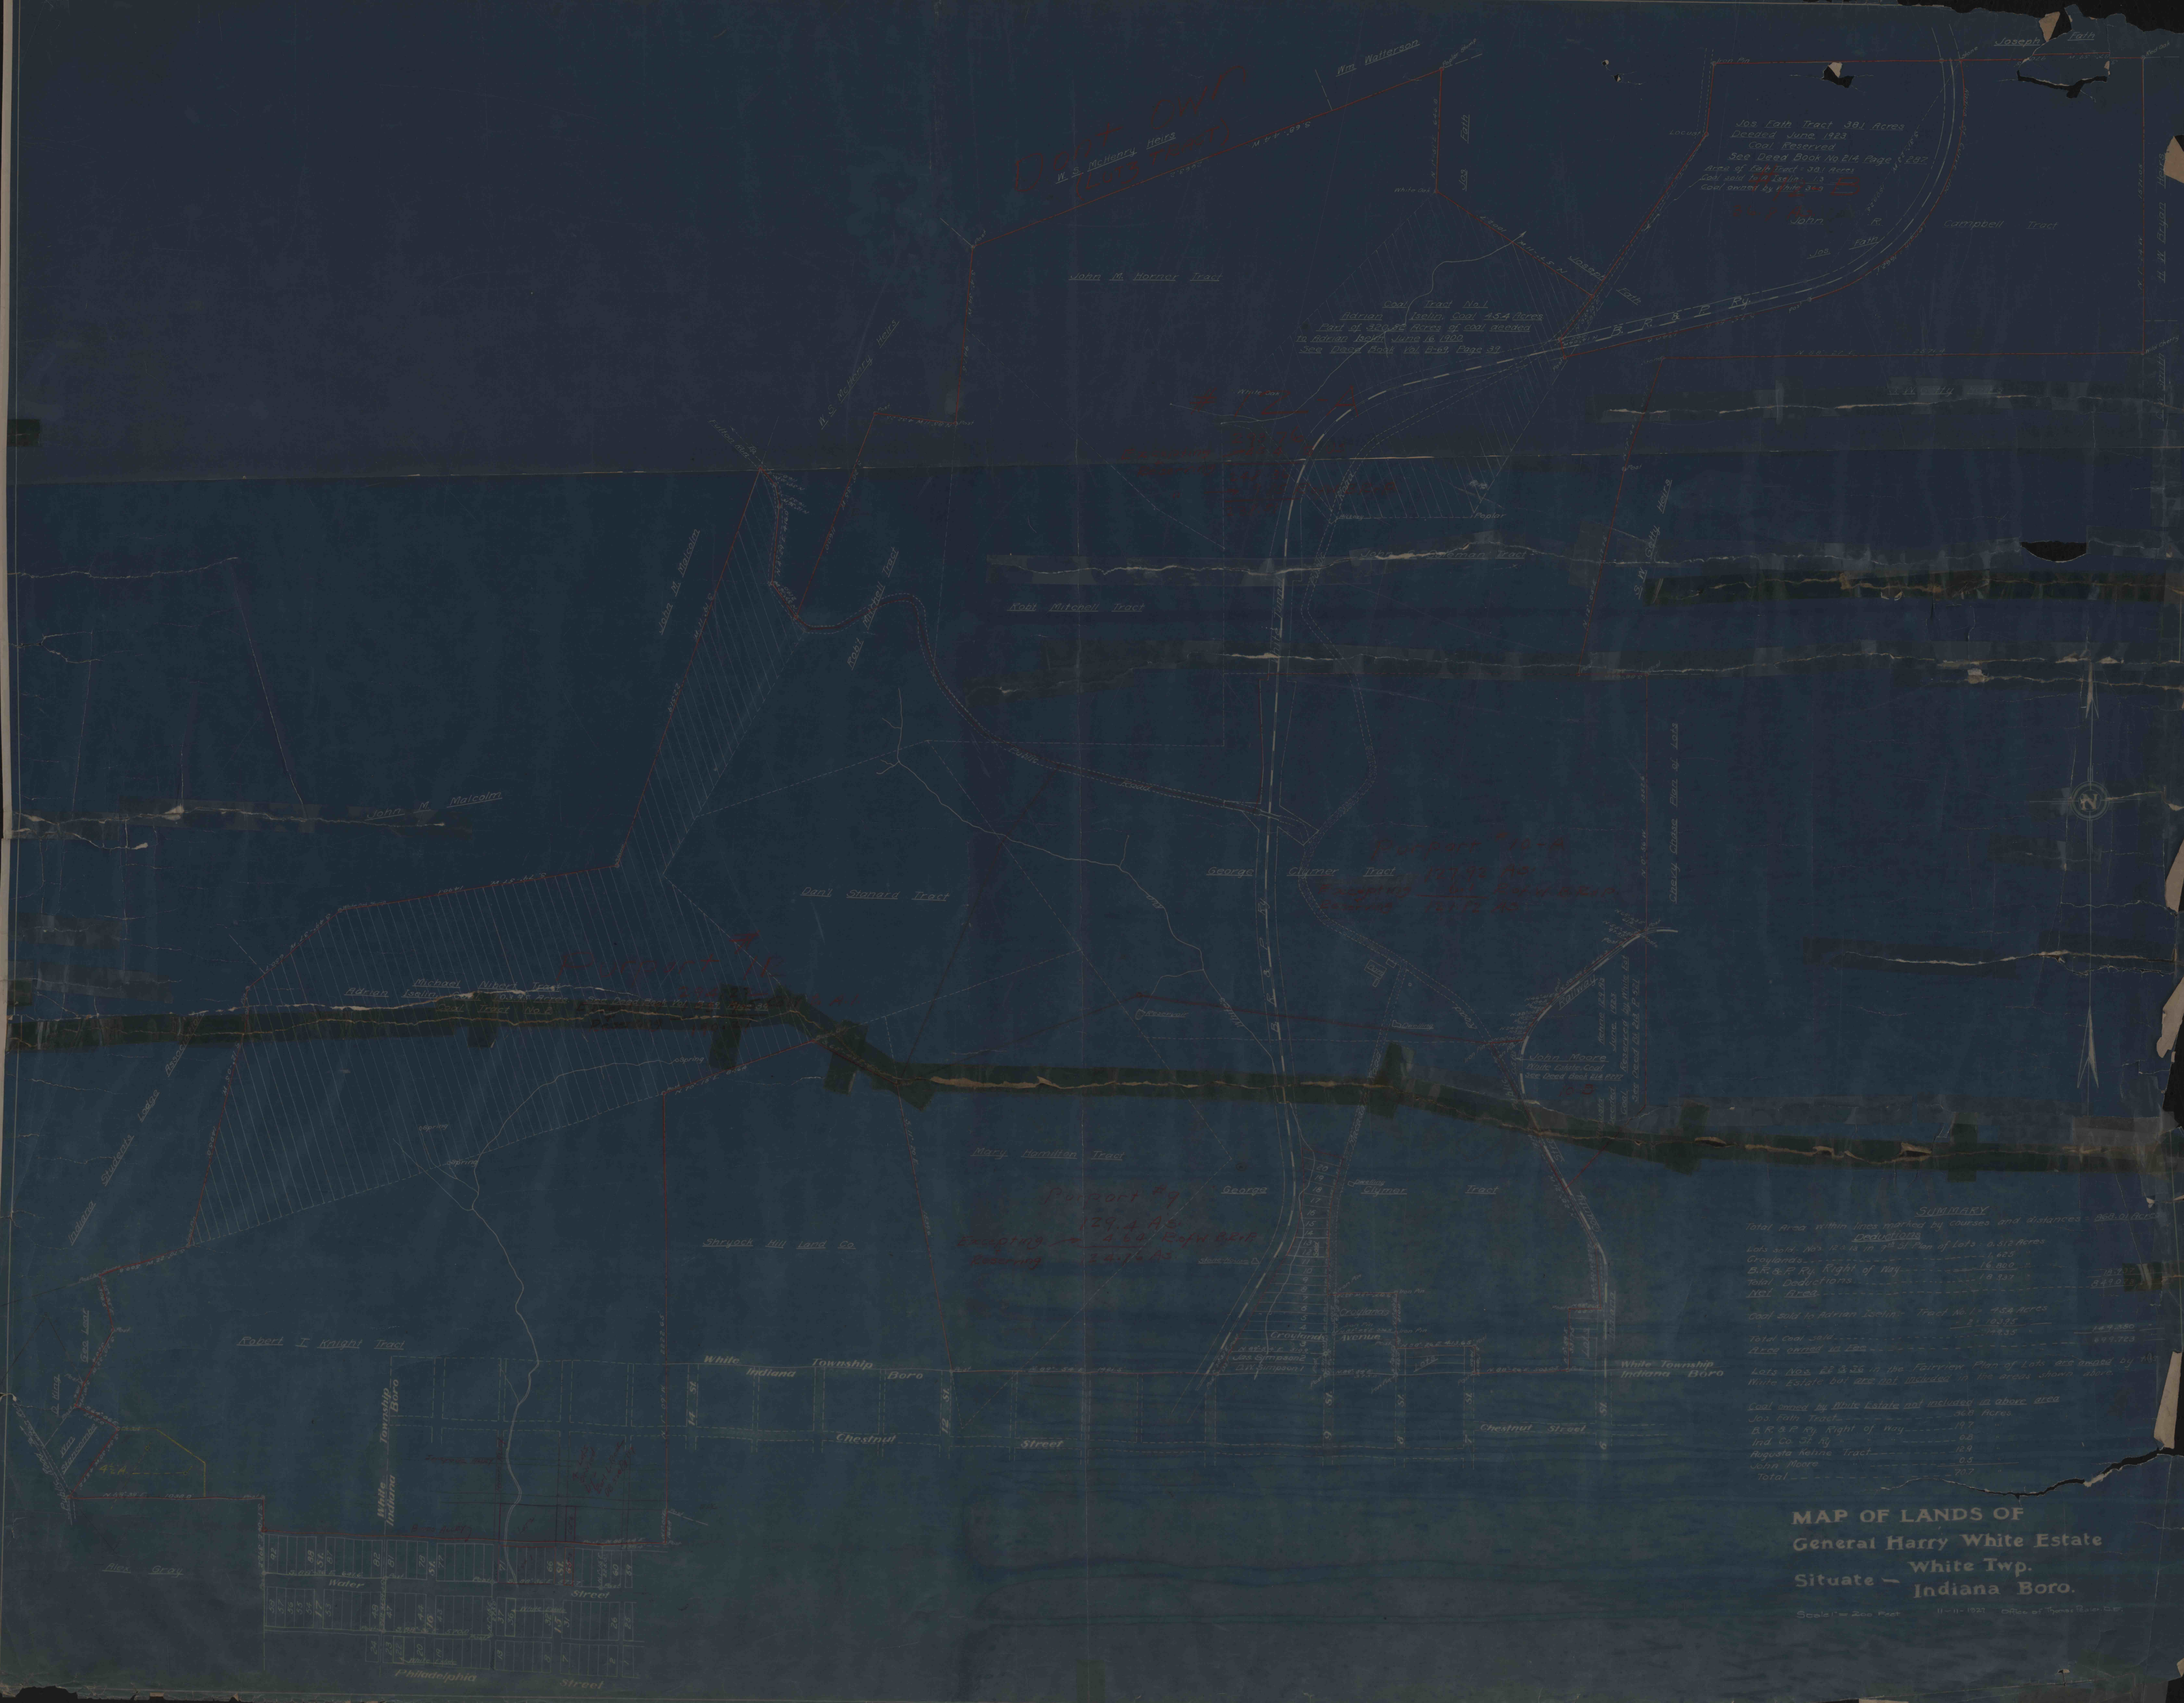

Dent OWR
W. S. McHenry Heirs
(1893 Tract)


Coal Tract No. 1

#12-A

Purport #10-A

Purport #9

Purport #9
129.4 AC
Selling 5.55 RPH GRP
Reserving 24.76 AC

SUMMARY
Total area within lines marked by courses and distances - 681.07 Acres
Deductions
Lots sold, Nos. 12-14 in Fairview Plan of Lots 6.317 Acres
Conveyance to ... 1.675
B.R. & F. Ry. Right of Way 16.000
Total Deductions 23.992
Net Area 657.078

Coal sold to Adrian Felt - Tract No. 1 - 454 Acres
Total Coal sold 454.000
Area owned by Felt 454.000
Lots Nos. 22 & 23 in the Fairview Plan of Lots deeded by
White Estate but are not included in the above shown area
Coal owned by White Estate not included in above area
Jos. Felt Tract 381 Acres
B.R. & F. Ry. Right of Way 16.000

MAP OF LANDS OF
General Harry White Estate
Situate - White Twp.
Indiana Boro.

Scale 1" = 200 Feet N. 11-11-1921 Office of Town & Range Com.