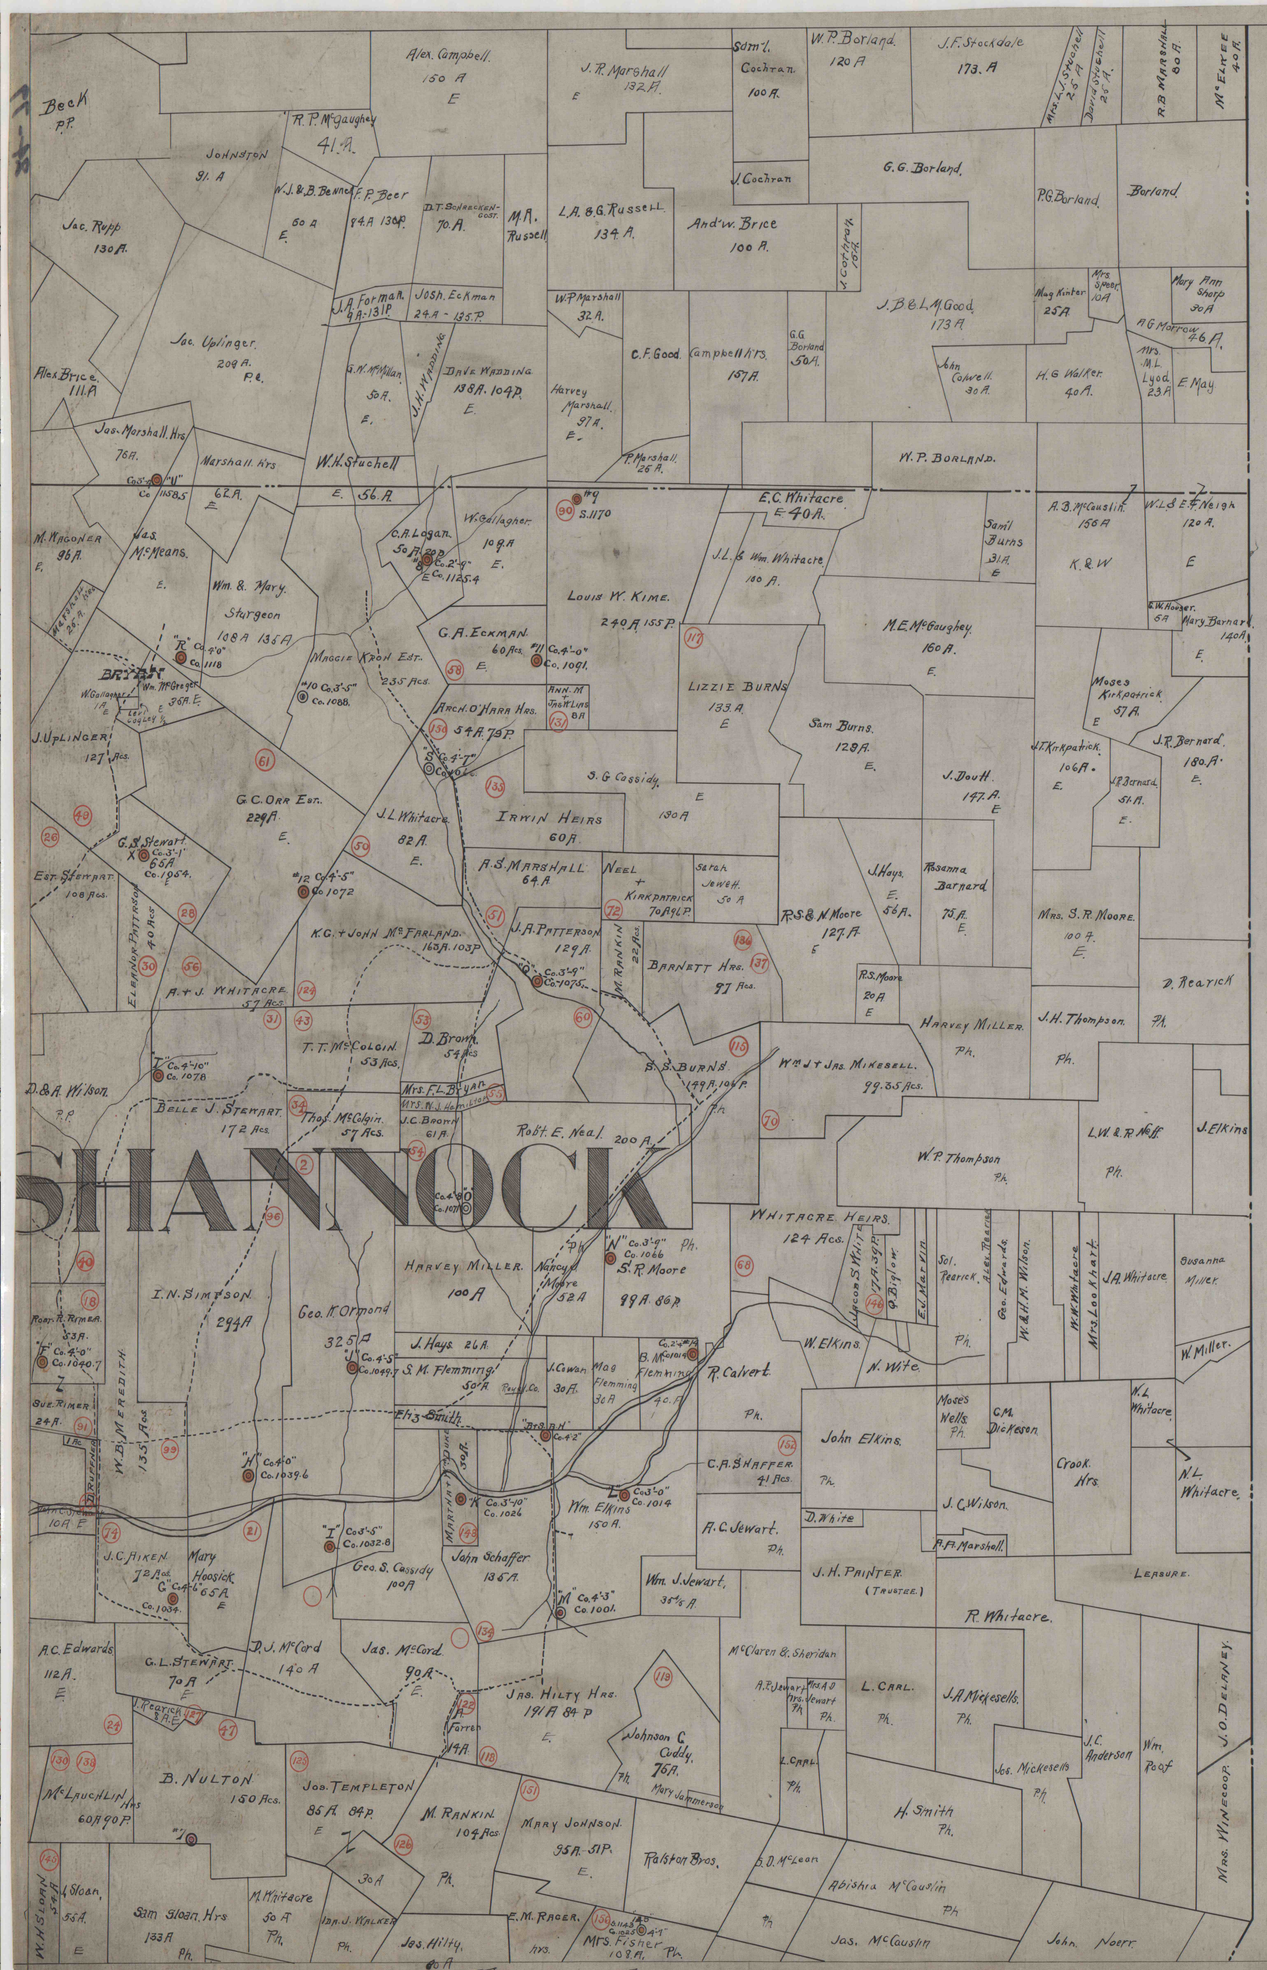

Scale 1" = 1320'

622.1893-84-99

35/1