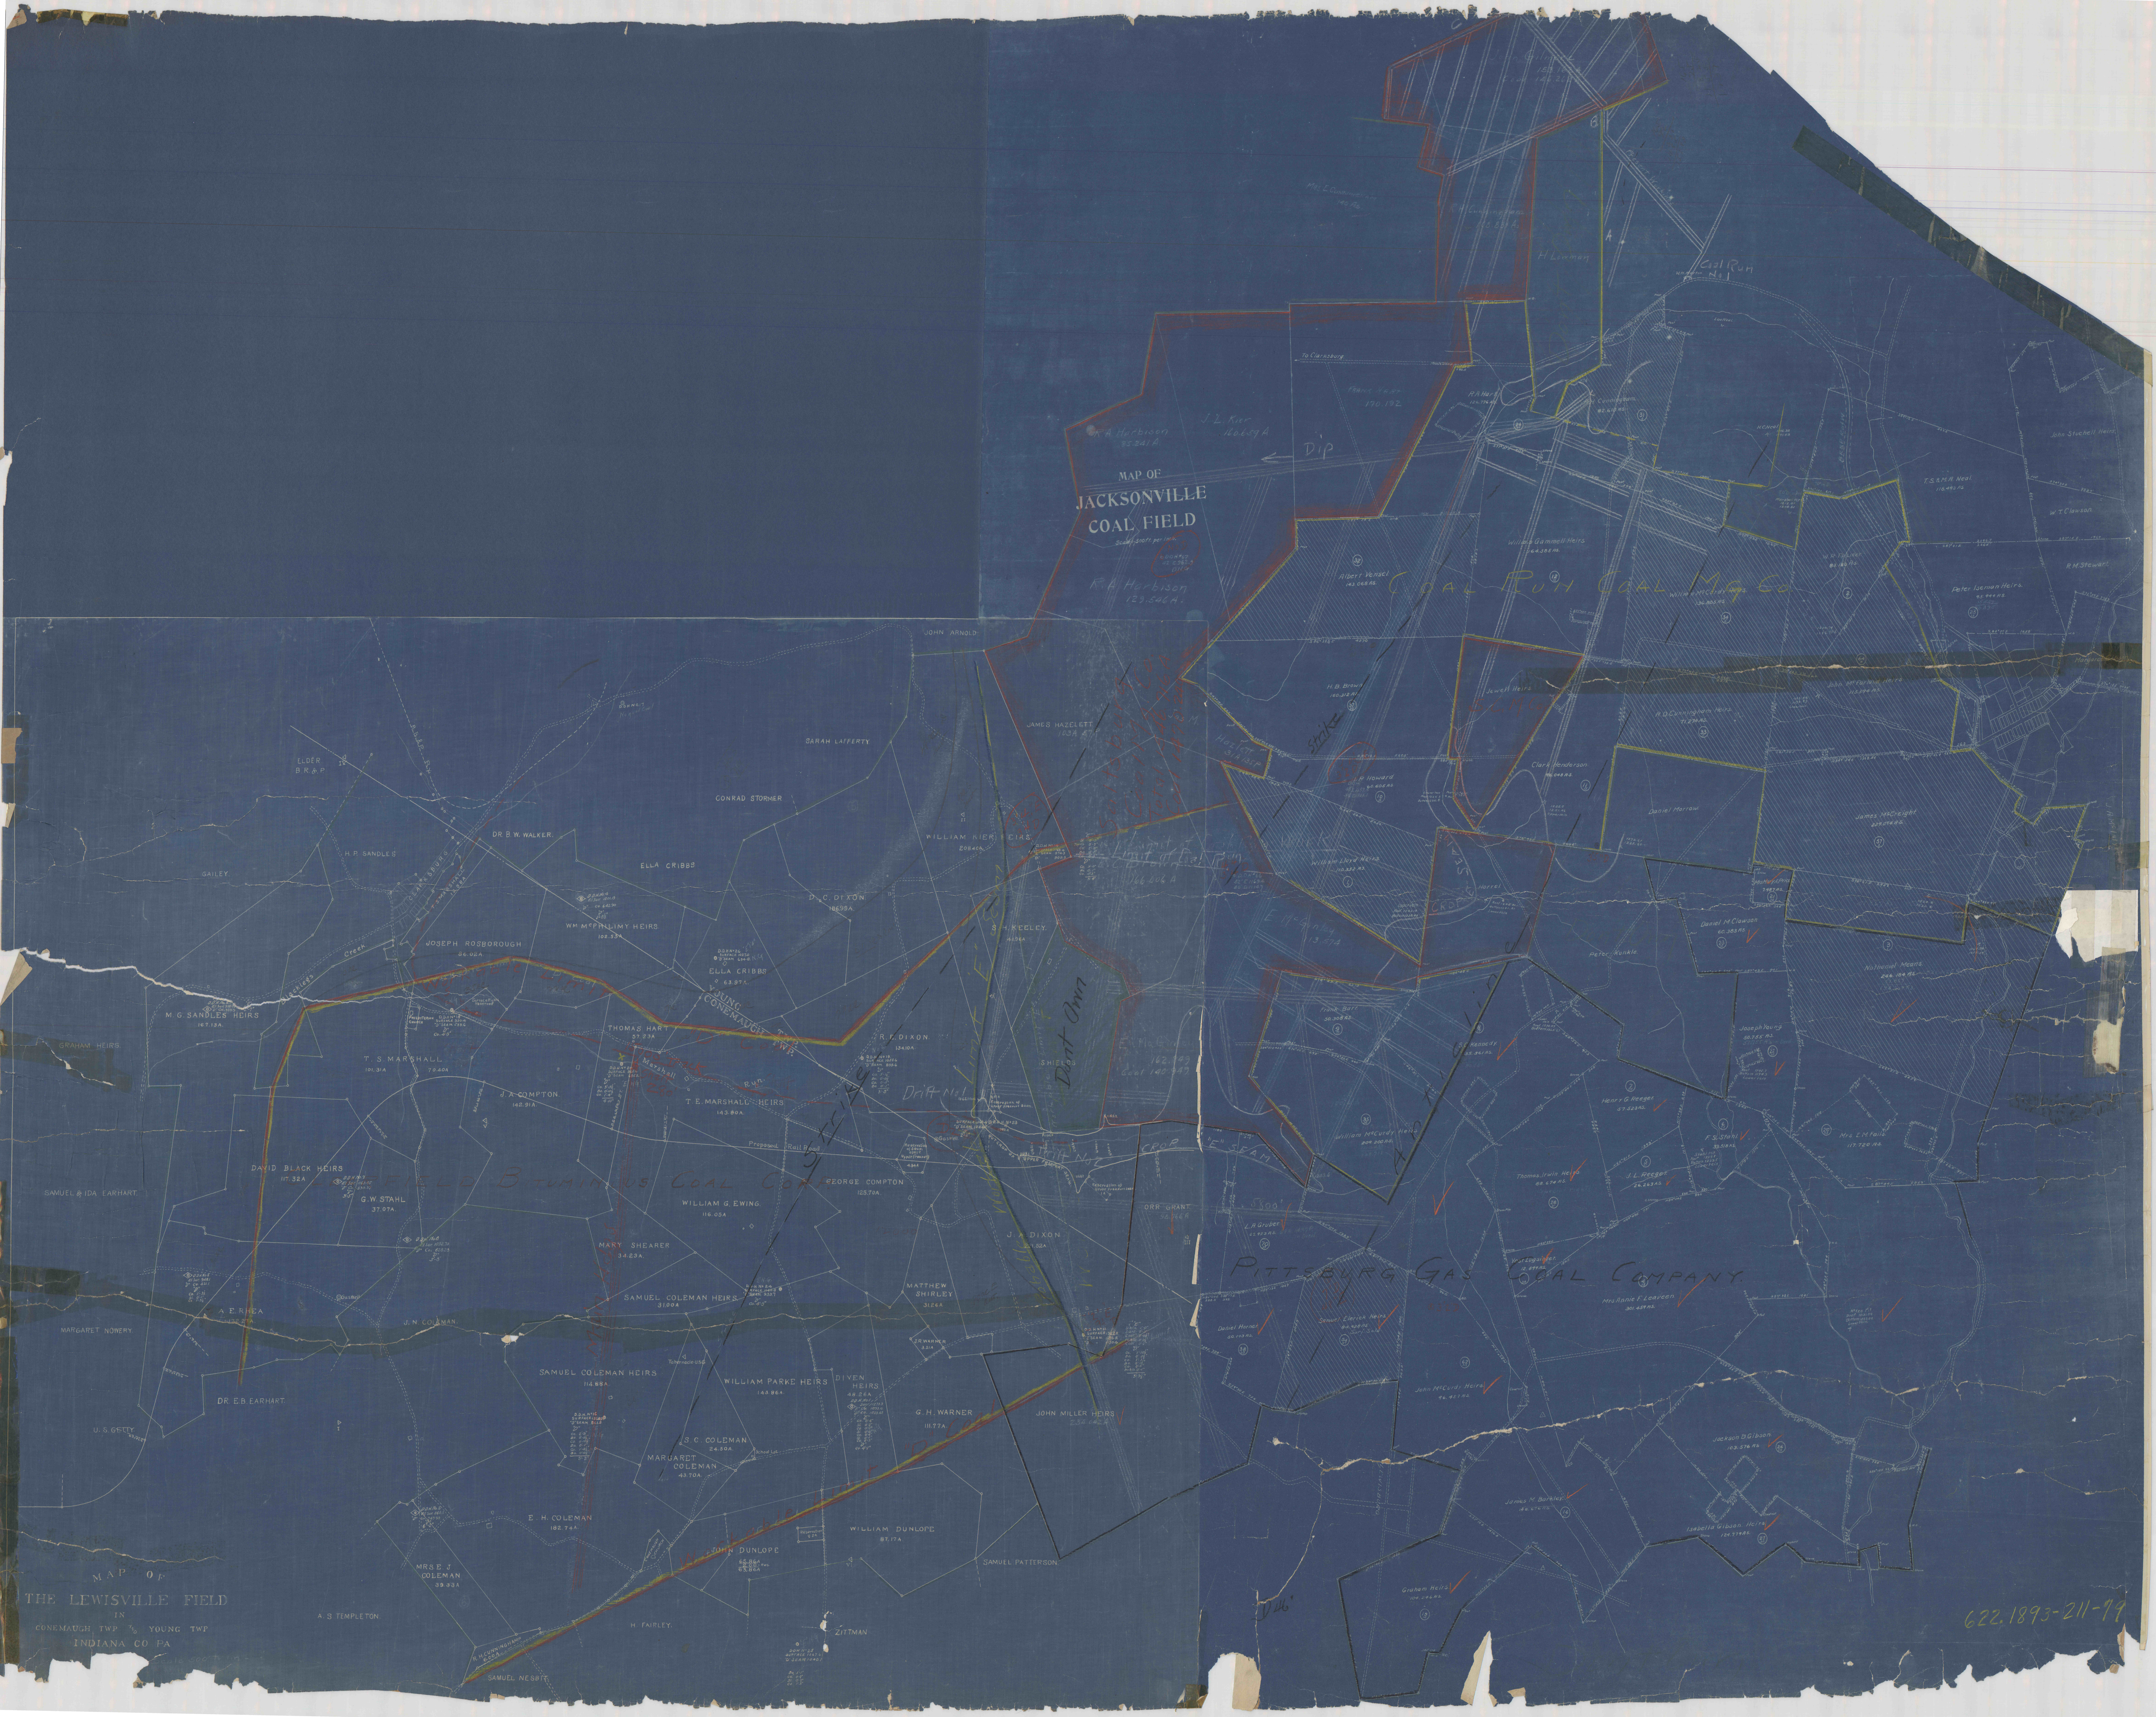

MAP OF THE LEWISVILLE FIELD

IN

CONEMAUGH TWP AND YOUNG TWP

INDIANA CO PA

Scale 500' To 1in

MAP OF JACKSONVILLE COAL FIELD

Scale:- 500 ft. per Inch.

No 5
D.D.H #67
42' E 962.9
D.N.G.
R.A. Harbison 85.241 A.
J. L. Kier 160.659 A
R.A. Harbison 129.546 A.
Dip
To Clarksburg
Frank Hart 170.192
H. Lemman
Coal Run No 1
R.A. Hart 126.776 As.
Cunningham 82.610 As.
H.C. Neal
T.S. & M.A. Neal 116.493 As.
John Stuchell Heirs
W. T. Clawson
R.M. Stewart
Albert Vensel 143.068 As.
William Gammell Heirs 164.385 As.
Coal Run Coal Mg Co
William McCurdy Hrs 136.805 As.
W. R. Fulmer 83.180 As.
Peter Iseman Heirs 95.944 As.
H.B. Brown 160.312 As.
Jewell Heirs
S.C.M.Co
John McFarland Heirs 113.594 As.
R.D. Cunningham Heirs 71.274 As.
Clark Henderson 146.048 As.
R. Howard 60.605 As.
Daniel Morrow
James McCreight 229.094 As.
Hazlett 31 A 135 P
Strike
William Lloyd Heirs 110.352 As.
Horrel
E. McGinley 13.574
Mrs Mary A. Price 7.487 As.
Daniel M. Clawson 60.383 As.
Peter Kunkle
Nathaniel Means 246.184 As.
Frank Barr 50.308 As.
S.C. Kennedy 35.361 As.
Joseph Young 50.755 As.
Henry G. Reeger 57.523 As.
F. S. Stahl 33.518 As.
Mrs E. M. Fails 117.720 As.
William McCurdy Heirs 209.200 As.
Thomas Irwin Heirs 88.674 As.
J. L. Reeger 26.263 As.
"E" Seam
Crop
5800'
L. A. Gruber 62.923 As.
Pittsburg Gas Coal Company
Daniel Horner 50.193 As.
Samuel Elerick Heirs 84.928 As. Surf. Sold
John McCurdy Heirs 96.457 As.
Mrs Annie F. Leaveen 301.459 As.
Jackson B. Gibson 103.576 As.
James M. Barkley 148.676 As.
Isabella Gibson Heirs 124.779 As.
Graham Heirs
Anticline
JOHN ARNOLD
SARAH LAFFERTY
CONRAD STORMER
JAMES HAZELETT 103 A 57 P
WILLIAM KIER HEIRS 208.40 A.
L. C. Brown 166.606 A
Limit of Coal Run
ELDER B.R.&P.
B.R.&P. RY.
DR. B. W. WALKER.
H. P. SANDLES
GAILEY
CLARKSBURG
T. S. MARSHALL 12.58 A
Blacklegs Creek
ELLA CRIBBS
D.D.H. No 4 El. Sur. 1201.19 "D" Co. 642.90
WM McPHILIMY HEIRS. 102.53 A.
D. C. DIXON 186.99 A.
JOSEPH ROSBOROUGH 86.02 A.
Workable Limit
M. G. SANDLES HEIRS 167.13 A.
GRAHAM HEIRS.
PRESBYTERIAN CHURCH
D.D.H. No 18 SURFACE 930.4 "D" SEAM 533.6
Surface Rights Reserved
D.D.H. No 26 SURFACE 1027.0 "D" SEAM 694.8
ELLA CRIBBS 63.97 A.
YOUNG TWP. CONEMAUGH TWP.
S. H. KEELEY. 41.96 A.
THOMAS HART 57.23 A.
Marshall Run
T. S. MARSHALL 101.31 A 70.40 A
J. A. COMPTON. 142.91 A.
T. E. MARSHALL HEIRS 143.80 A.
R. E. DIXON. 134.10 A.
D.D.H. No 19 SURFACE 1055.6 "D" SEAM 899.6
Drift No 1
SHIELDS
Don't Own
Limit "E" Seam
E. McGinley 162.949 Coal 140.949
Proposed Rail Road
Reservation of Seam above Upper Freeport 4.34 A
D.D.H. No 23 "D" SEAM 1024
Gas Well
OUTCROP OF UPPER FREEPORT SEAM.
Drift No 2
Reservation of Upper Freeport Seam. 1 A
ORR GRANT. 98.766 A
DAVID BLACK HEIRS 117.32 A.
D.D.H. No 7 El. Sur. 1163.55
G. W. STAHL 37.07 A.
Bituminous Coal Corp.
GEORGE COMPTON 125.70 A.
WILLIAM G. EWING. 116.05 A
SAMUEL & IDA EARHART.
MARY SHEARER 34.23 A.
J. A. DIXON 221.52 A.
D.D.H. No 6 El. Sur. 1092.70 "D" Co. 628.25
D.D.H. No 24 SURFACE 1140.8 "D" SEAM 933.7
SAMUEL COLEMAN HEIRS 31.00 A
MATTHEW SHIRLEY 31.26 A.
A. E. RHEA 172.27 A.
J. N. COLEMAN.
MARGARET NOWERY.
J. R. WARNER 3.21 A
D.D.H. No 11
Tabernacle-U.S.
SAMUEL COLEMAN HEIRS 114.88 A.
WILLIAM PARKE HEIRS 143.86 A.
DIVEN HEIRS 48.26 A
D.D.H. No 16 SURFACE 1260.2 "D" SEAM 861.9
S. C. COLEMAN 24.50 A.
School Lot
MARGARET COLEMAN 43.70 A.
G. H. WARNER 111.77 A.
JOHN MILLER HEIRS 234.042 A
U. S. GETTY 63.776
DR. E. B. EARHART.
E. H. COLEMAN 182.74 A.
CONEMAUGH CHURCH
JOHN DUNLOPE 65.86 A 2.00 Res. 63.86 A
Reservation 2 A
WILLIAM DUNLOPE 87.17 A.
SAMUEL PATTERSON.
Workable Limit "D" Coal
MRS. E. J. COLEMAN 39.33 A
D.D.H. No 3 El. Sur. 1160.5
A. S. TEMPLETON.
R. H. CUNNINGHAM 6.00 A
H. FAIRLEY.
ZITTMAN
D.D.H. No 25 SURFACE 1267.41 "D" SEAM 1040.1
SAMUEL NESBIT.

622.1893-211-77