

SCALE 1" = 40'

SCALE 1" = 40'

PROPOSED COMPLETION TIMETABLE


EXCAVATION PROGRESS

CONCRETE PROGRESS

636' DEEP



REVISIONS

HELVETIA SCHEDULE

3-1-67

NO.	DATE	DESCRIPTION
1	3-1-67	Set Up
2	3-1-67	Set Up
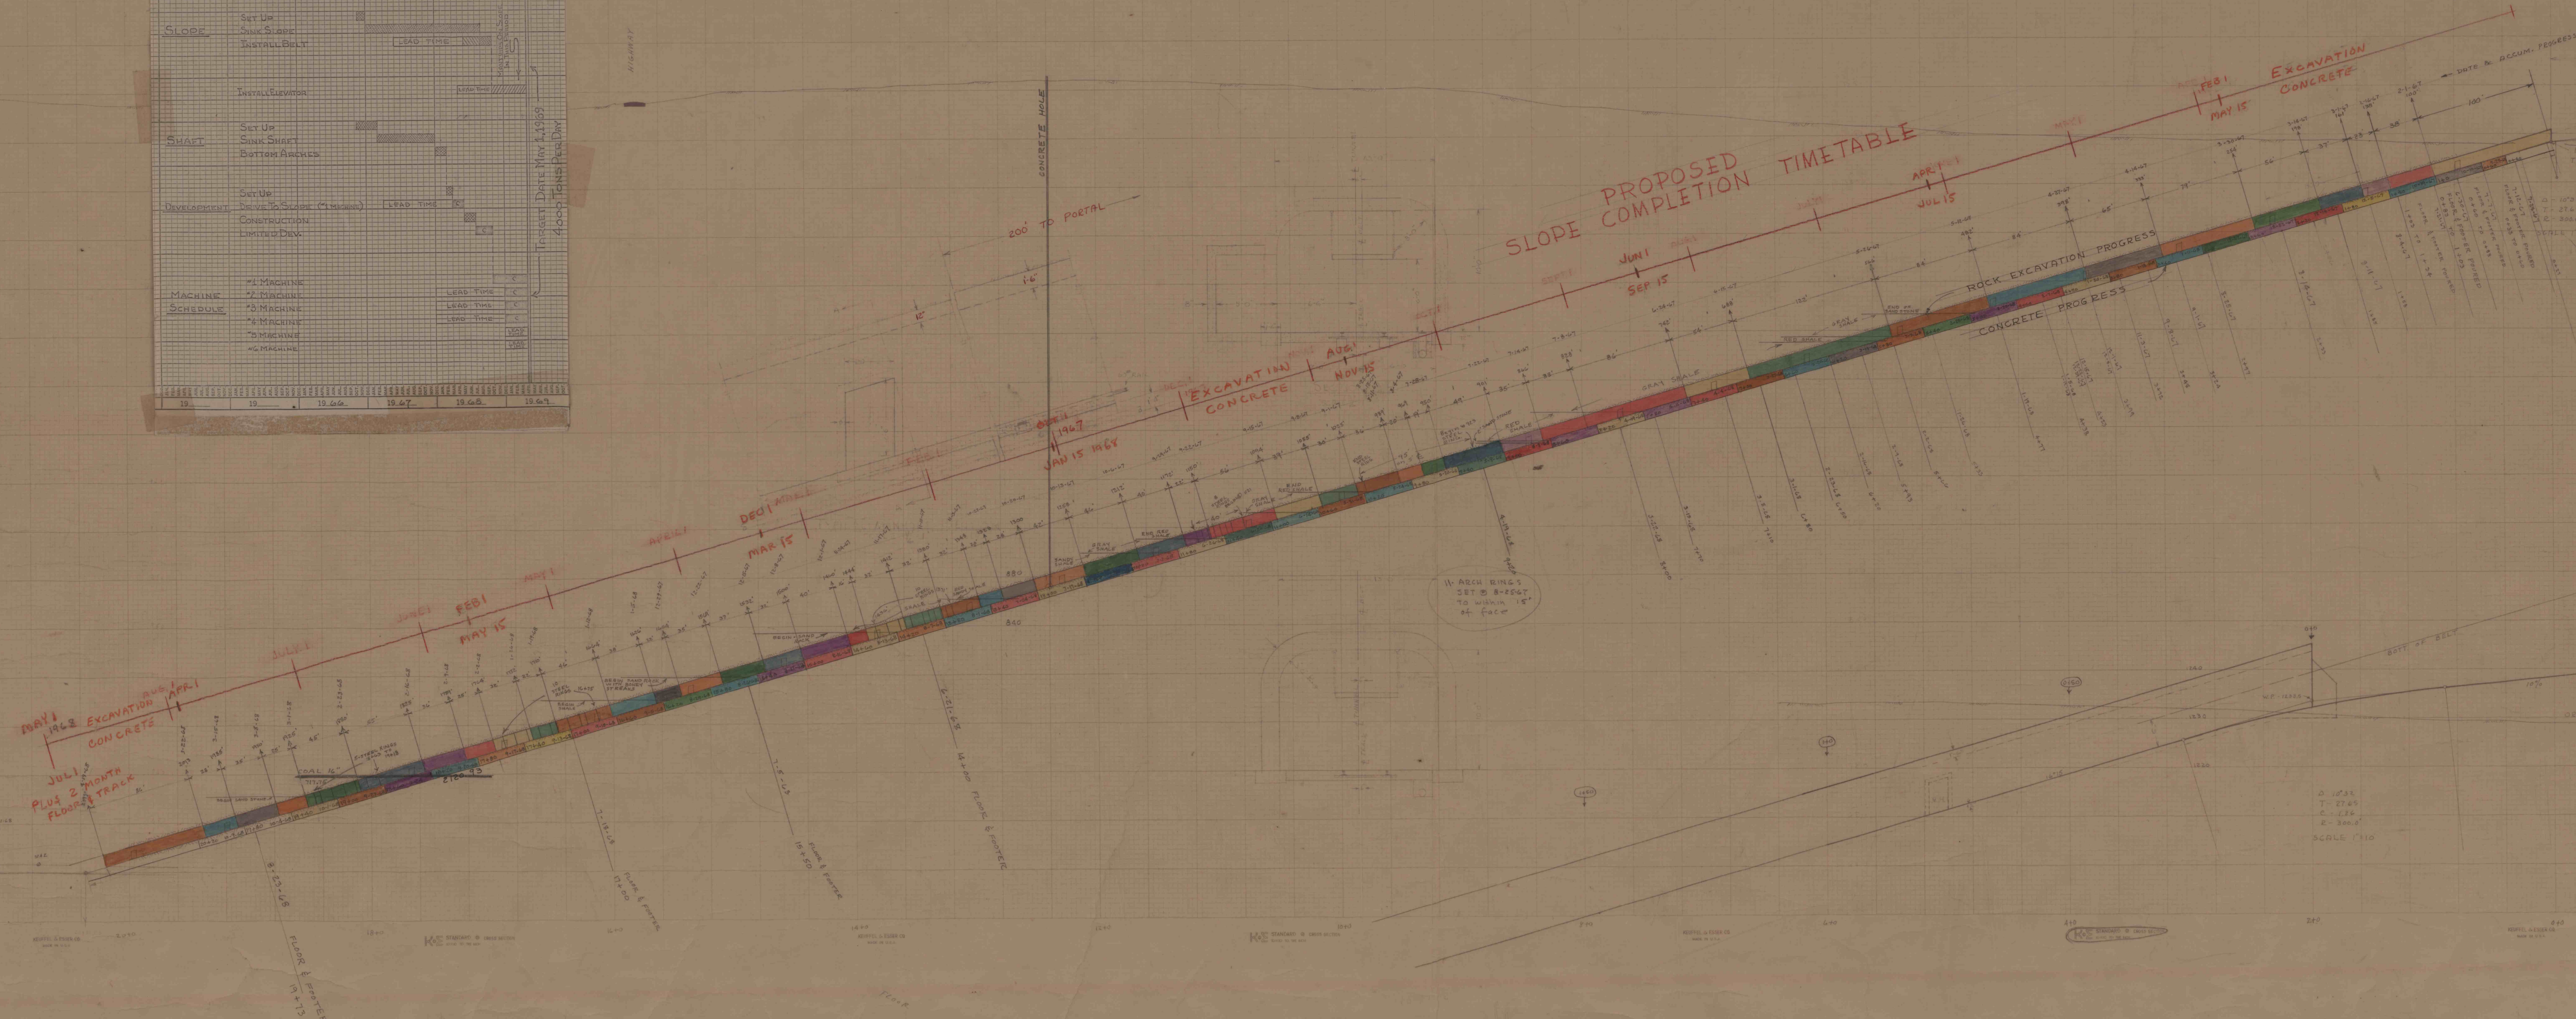

EXCAVATION PROGRESS AVERAGE 138' / MONTH
FOOTER & FLOOR POURING AVERAGE 150' / MONTH
ARCH POURING - AVERAGE 15' / MONTH

WORK PRINT

HELVETIA COAL CO.

Proposed Shaft

HELVETIA COAL CO.

Revised - 2-15-67