


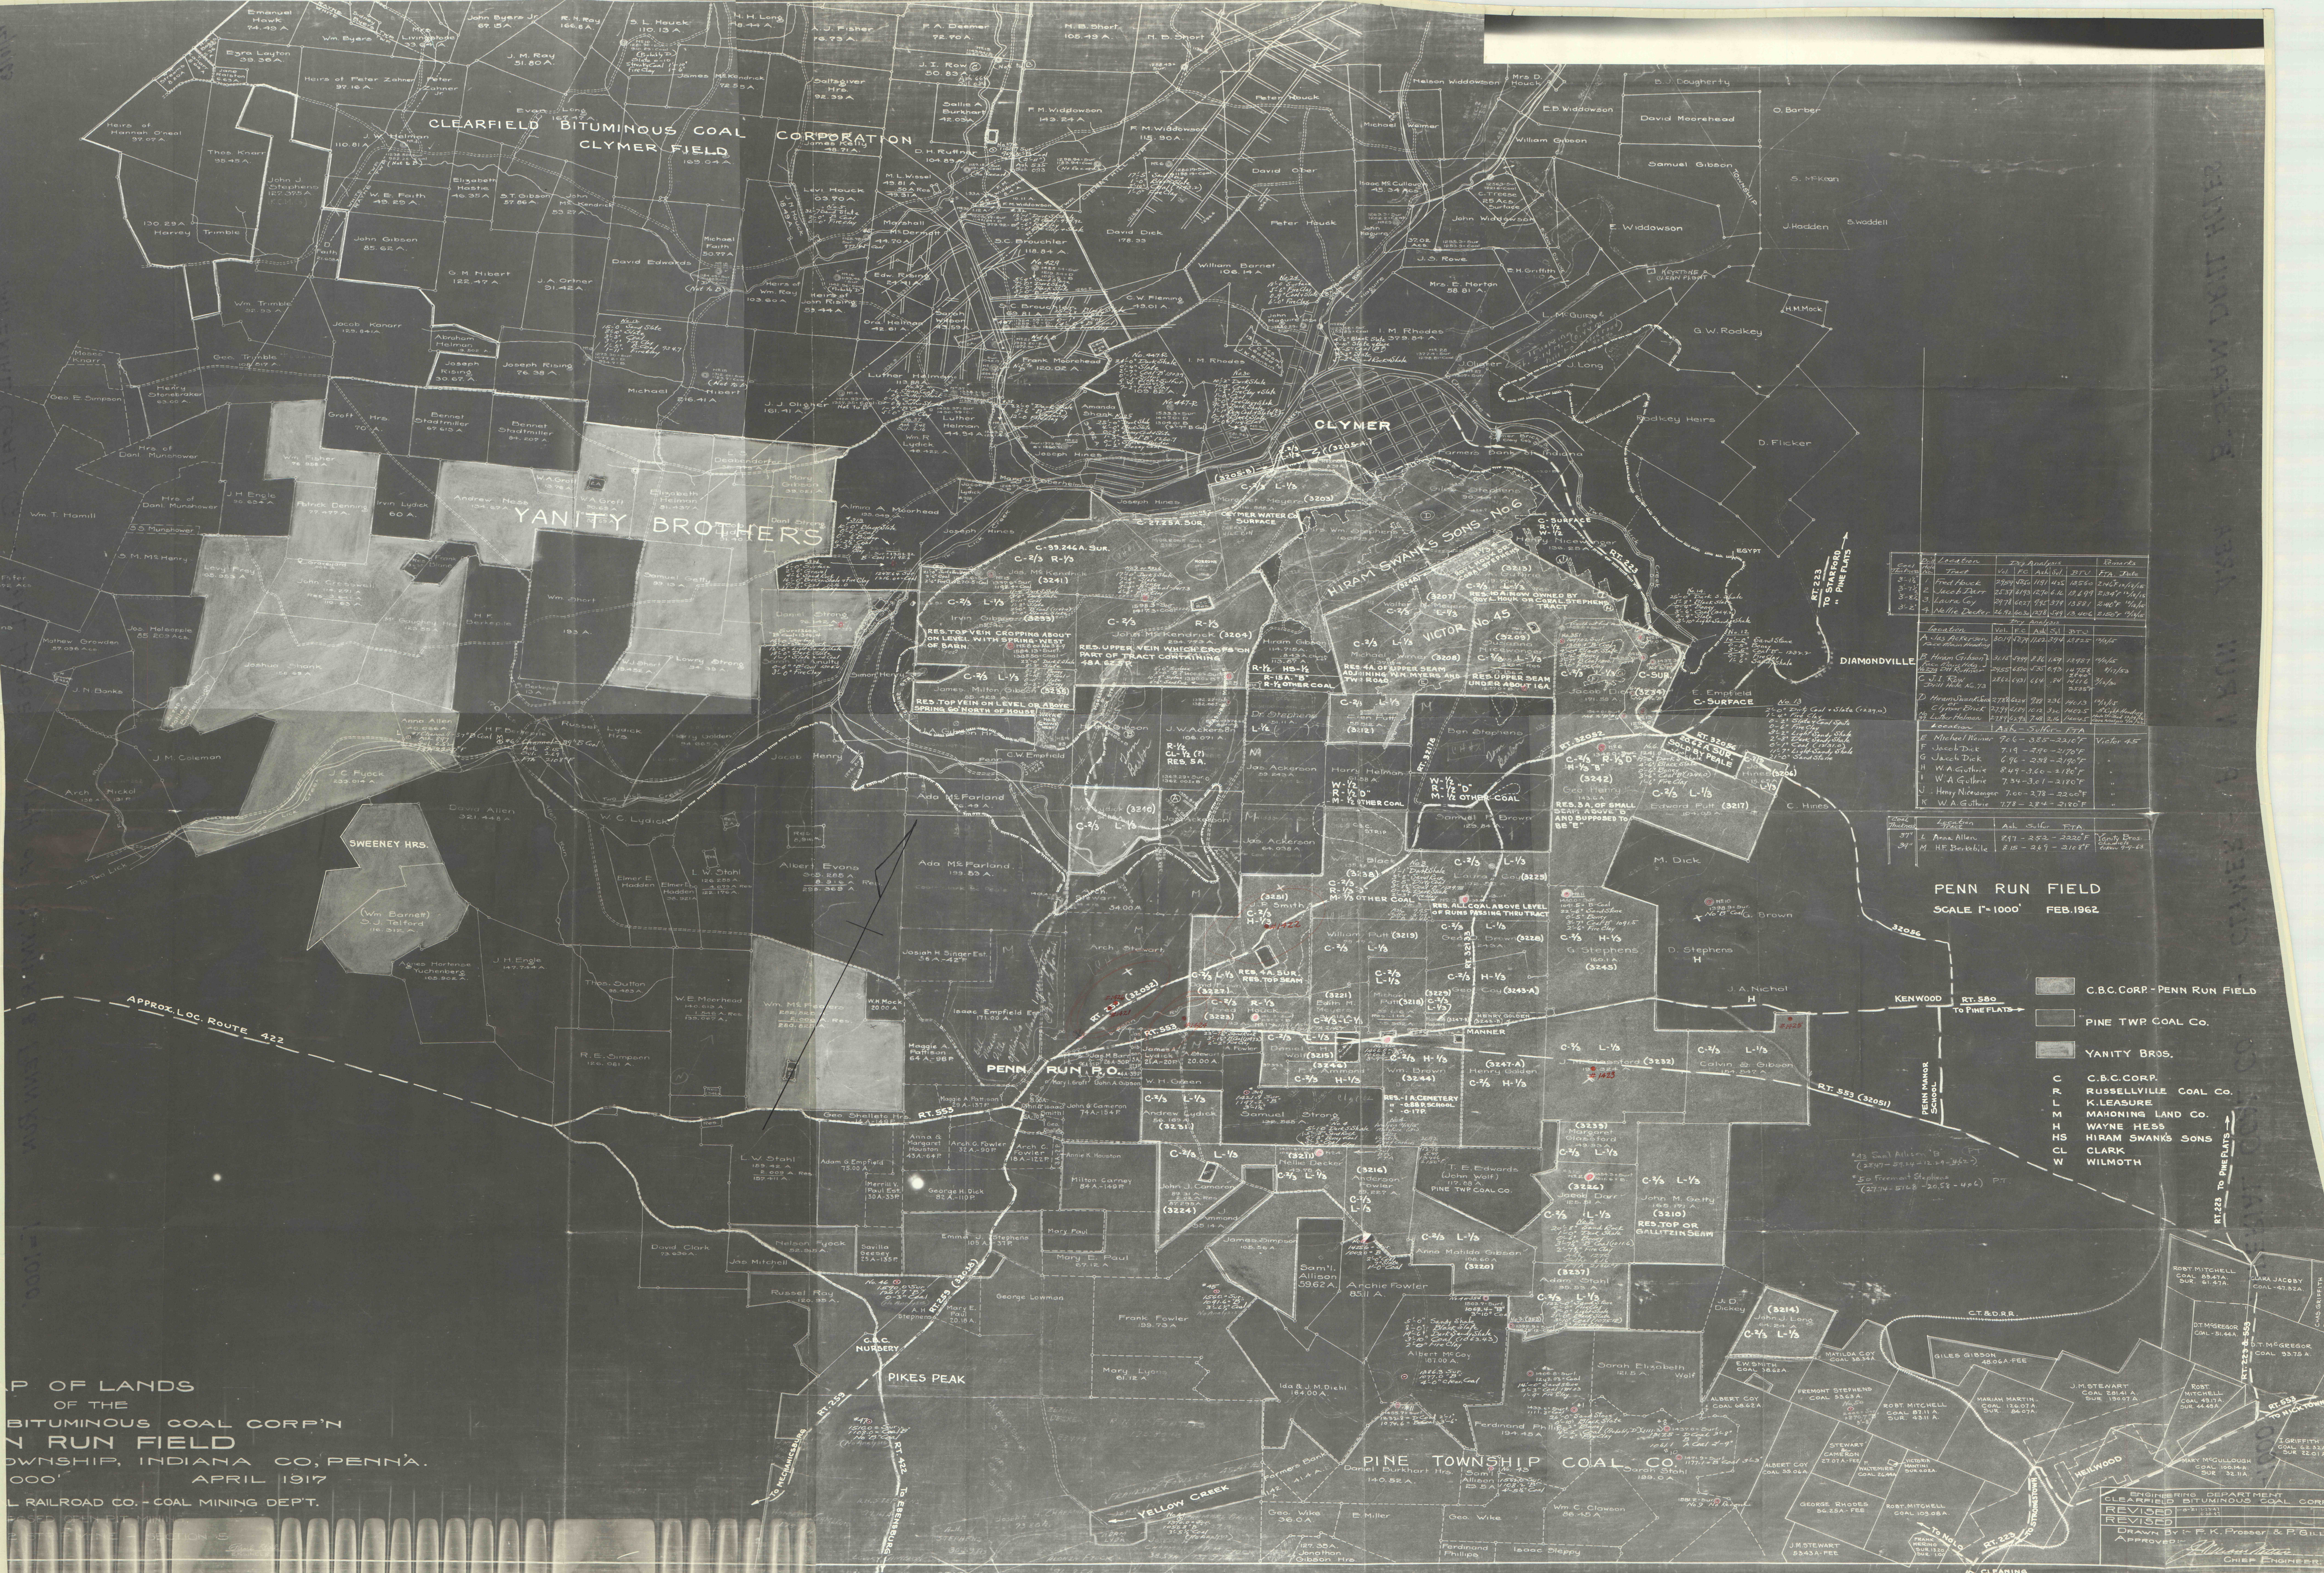


PENN RUN FIELD
SCALE 1"=1000' FEB. 1962

- C.B.C. CORP. - PENN RUN FIELD
- PINE TWP COAL CO.
- YANITY BROS.
- C.B.C. CORP. - RUSSELLVILLE COAL CO.
- K. LEASURE
- MAHONING LAND CO.
- WAYNE HESS
- HIRAM SWANK'S SONS
- CLARK
- WILMOTH

P OF LANDS
OF THE
BITUMINOUS COAL CORP'N
N RUN FIELD
OWNSHIP, INDIANA CO, PENNA.
000' APRIL 1917
L RAILROAD CO. - COAL MINING DEPT.

ENGINEERING DEPARTMENT
CLEARFIELD BITUMINOUS COAL CORP.
REVISED
DRAWN BY: F. K. Prosser & P. G. Gill
APPROVED: [Signature]
CHIEF ENGINEER