


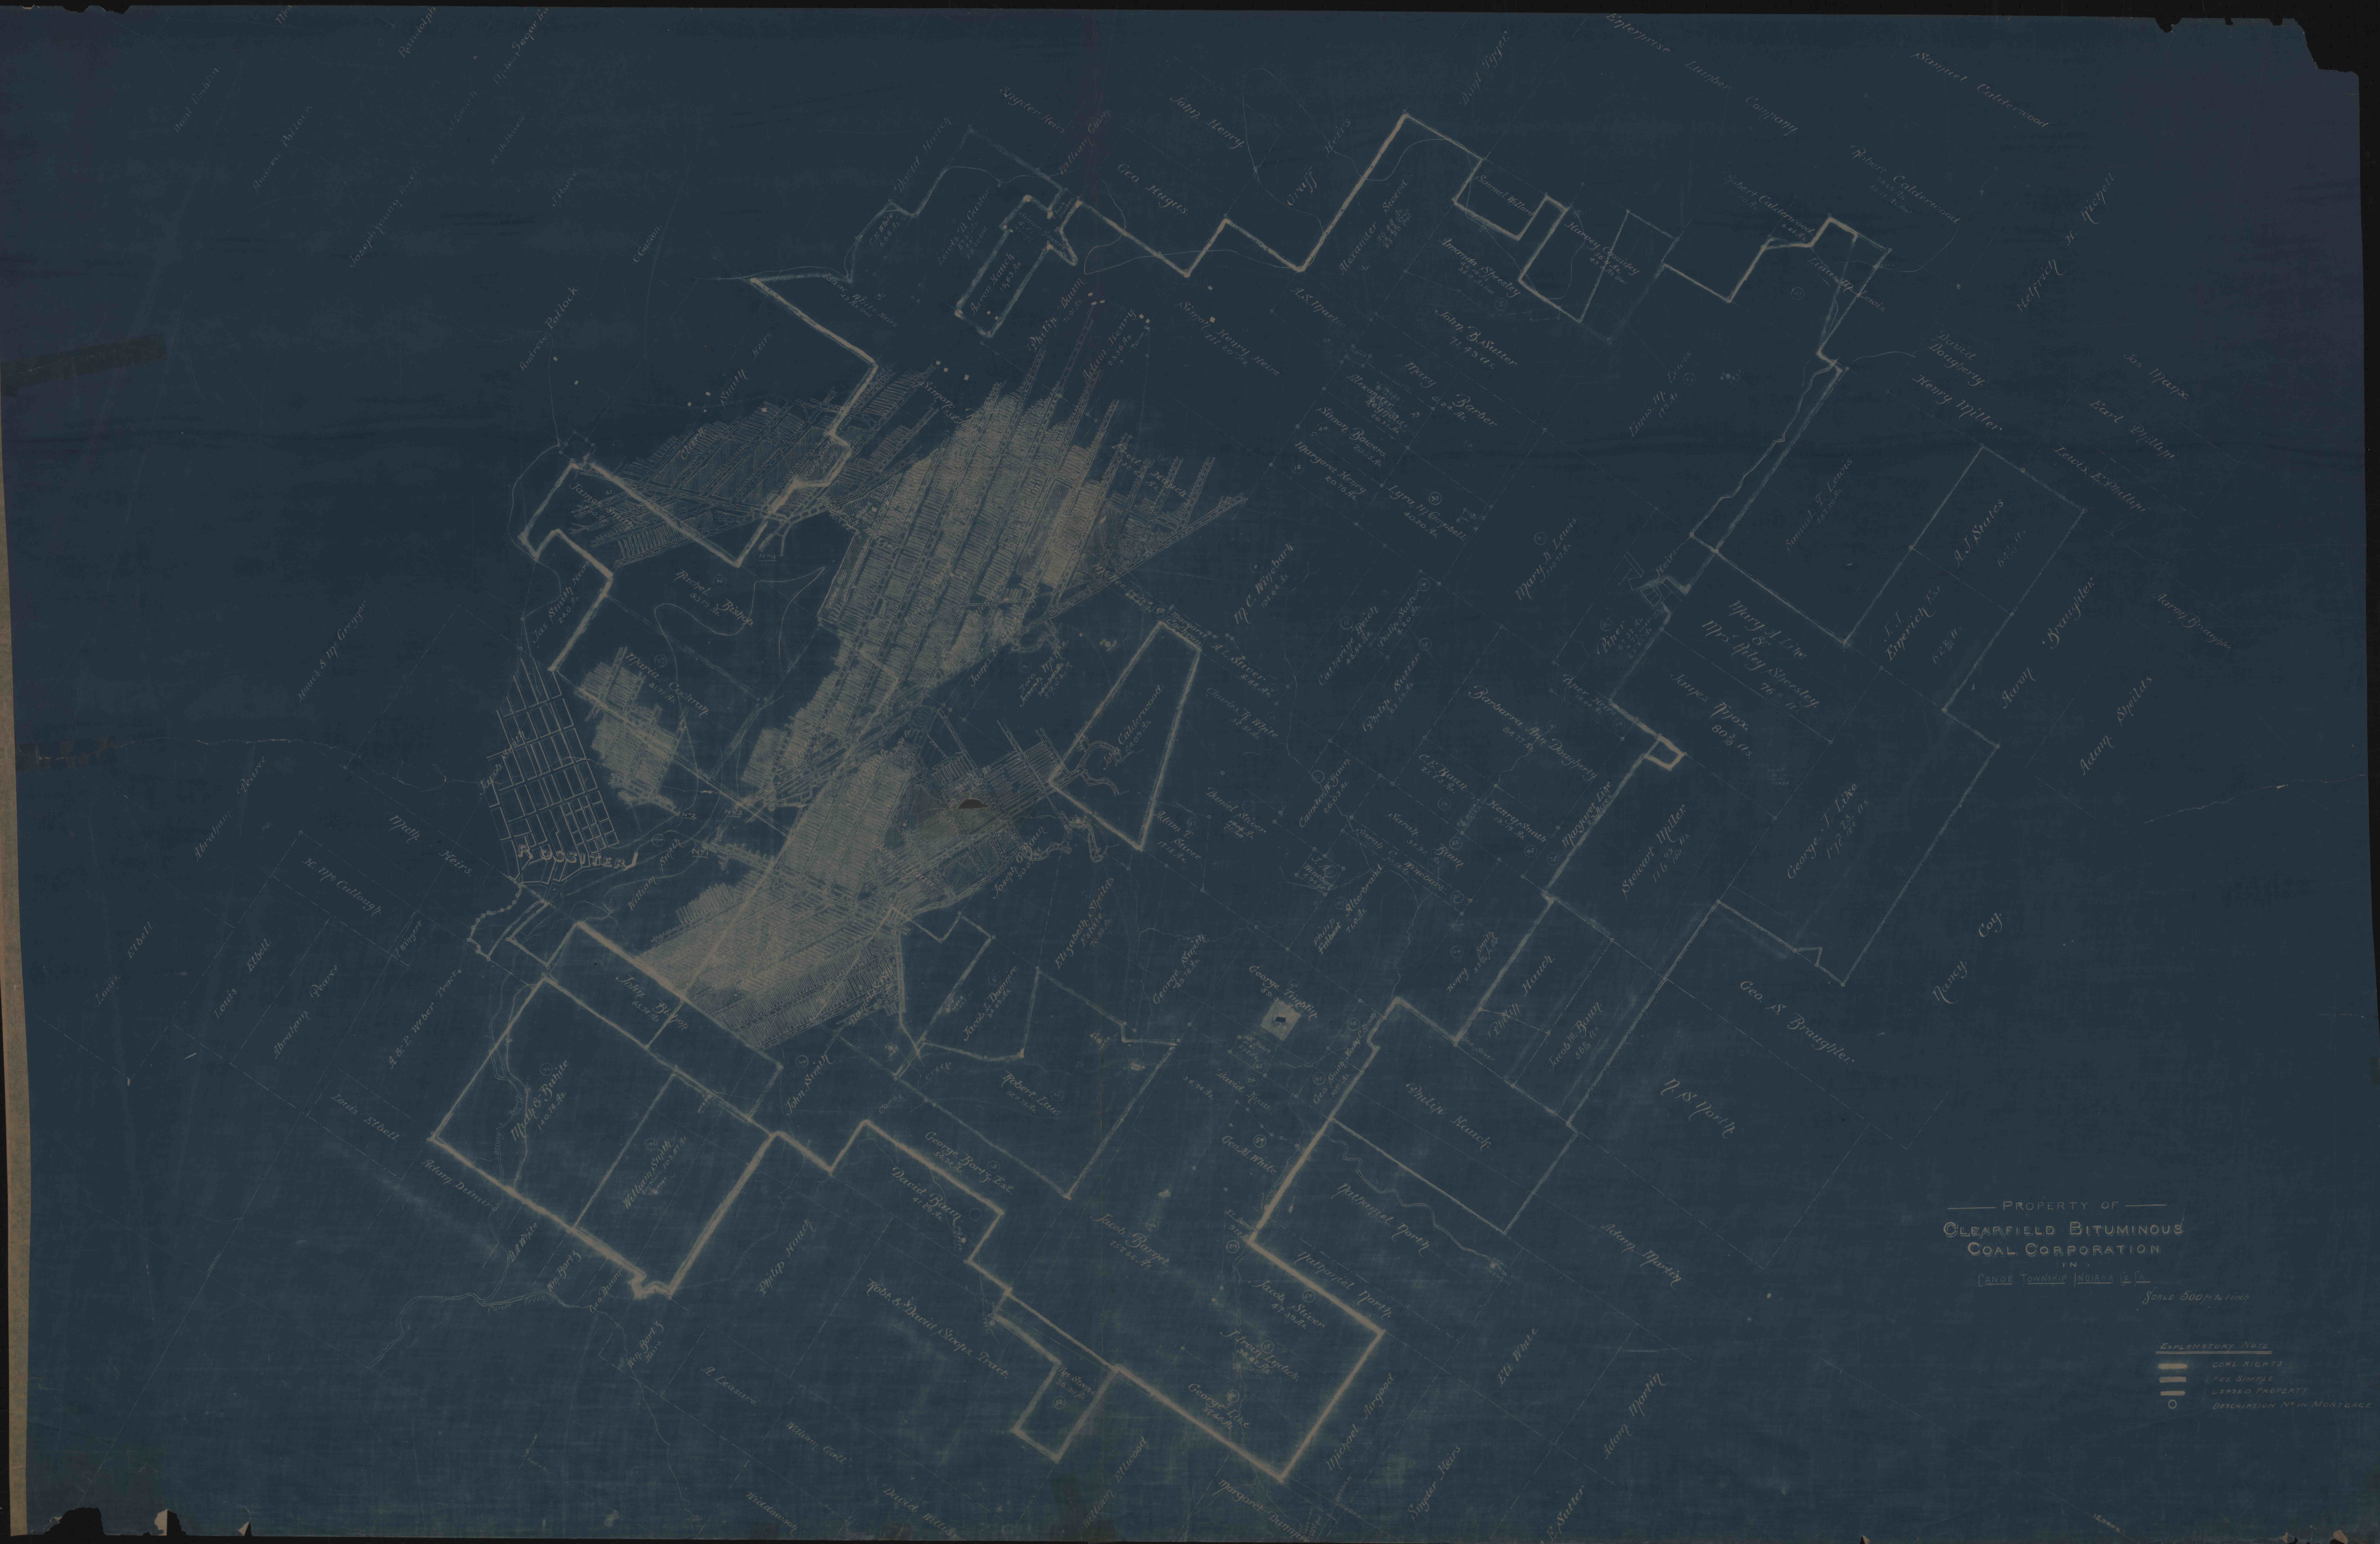

PROPERTY OF
CLEARFIELD BITUMINOUS
COAL CORPORATION
IN
Scale 500 Feet = 1 Inch

EXPLANATORY NOTE
— COAL RIGHTS
— FEE SIMPLE
— LEASED PROPERTY
○ DESCRIPTION WITH MORTGAGE