


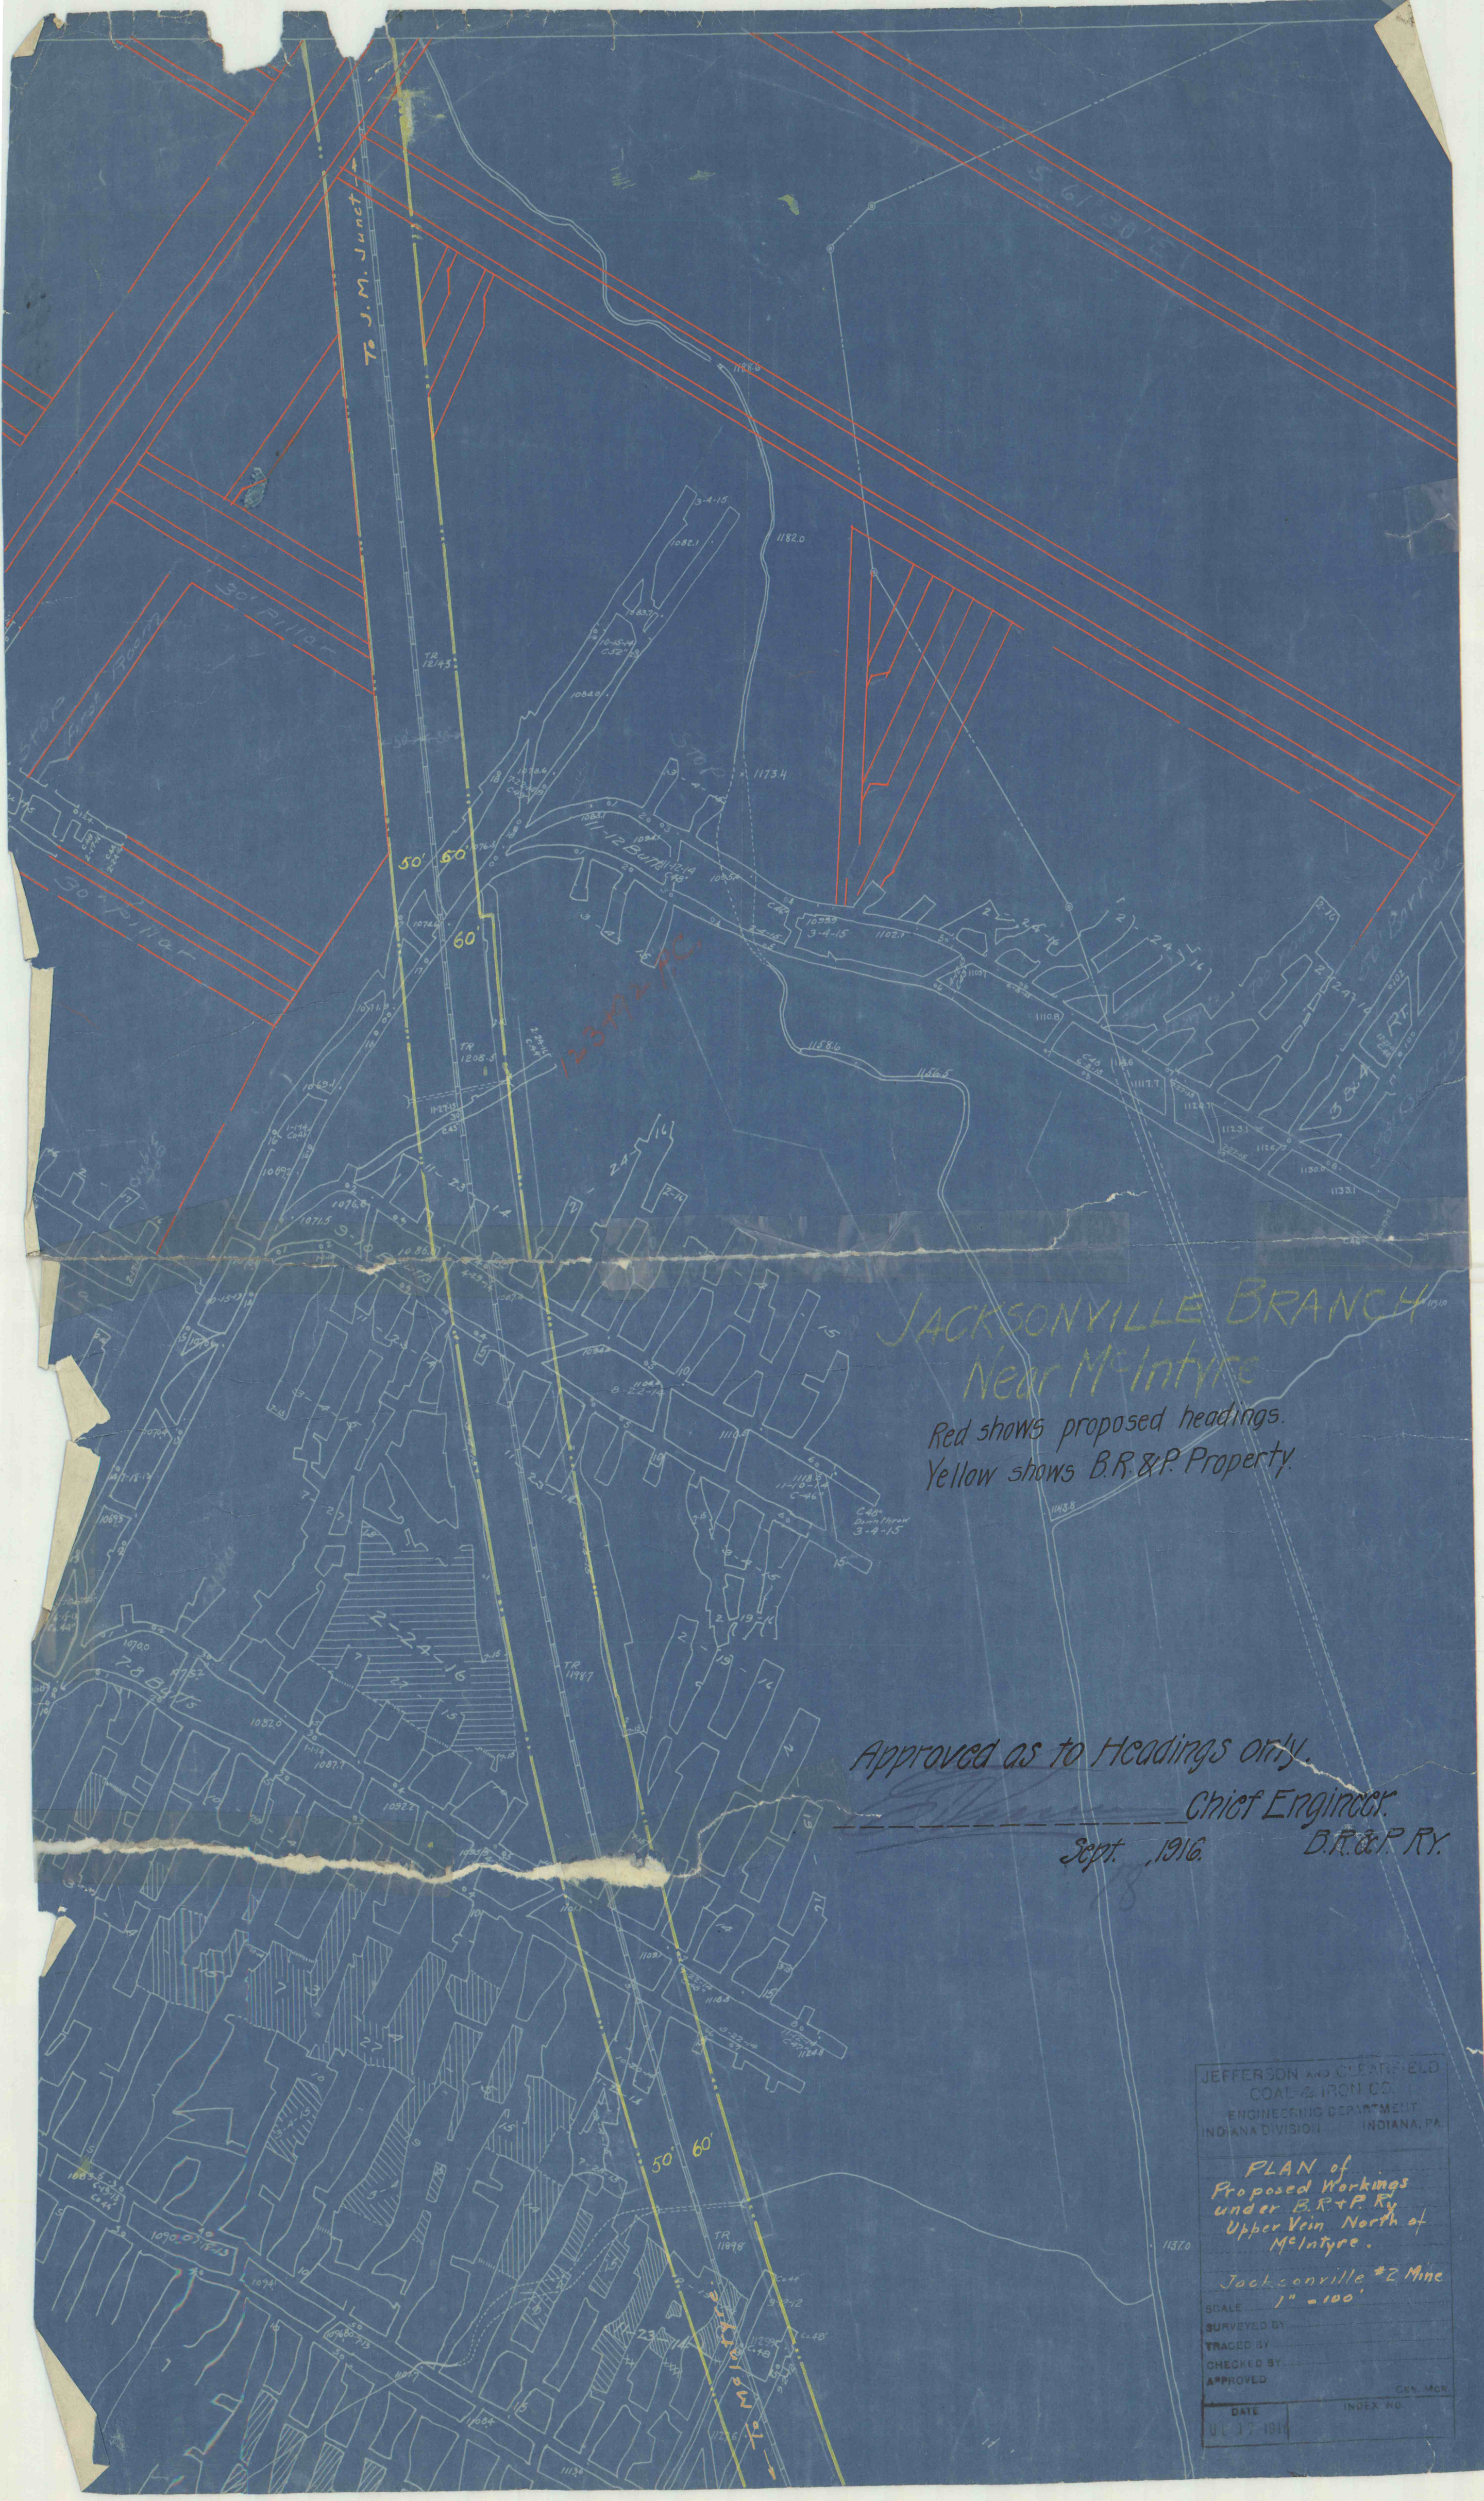

JACKSONVILLE BRANCH
Near McIntyre

Red shows proposed headings.
Yellow shows B.R. & P. Property.

Approved as to Headings only.

Chief Engineer.

Sept. 1916

B.R. & P. RY.

JEFFERSON AND CLEARFIELD
COAL & IRON CO.
ENGINEERING DEPARTMENT
INDIANA DIVISION INDIANA, PA.

PLAN of
Proposed Workings
under B.R. & P. Ry.
Upper Vein North of
McIntyre.

Jackscoville #2 Mine
1" = 100'

SCALE

SURVEYED BY

TRACED BY

CHECKED BY

APPROVED

DATE

INDEX NO.

01 17-1916

CEN. MGR.