

HUGH LOWRY

4115' To McIntyre Station →

Not approved as to
anything north of track
line

No further coal to be removed
between track and this line

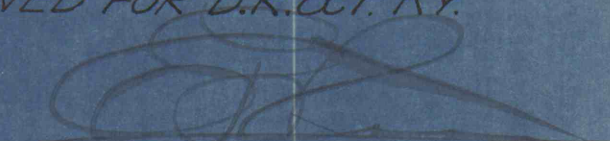
This Area to be
Exhausted with out
Further negotiations
unless otherwise notified

W. LINEAL

→ To J.M. Jct.

MCINTYRE, PA.
Map showing Coal Workings
of
J. & C. C. & Co.

APPROVED FOR B.R. & P.R.Y.


Chief Engineer

Note: No further coal to be removed between
track and line 100 feet south of track as
indicated in yellow.
Approval refers only to coal on south
side of track, between 13-14 Rt and 11-12 Rt.

W. & C. KING

11/24/11

Authorized