


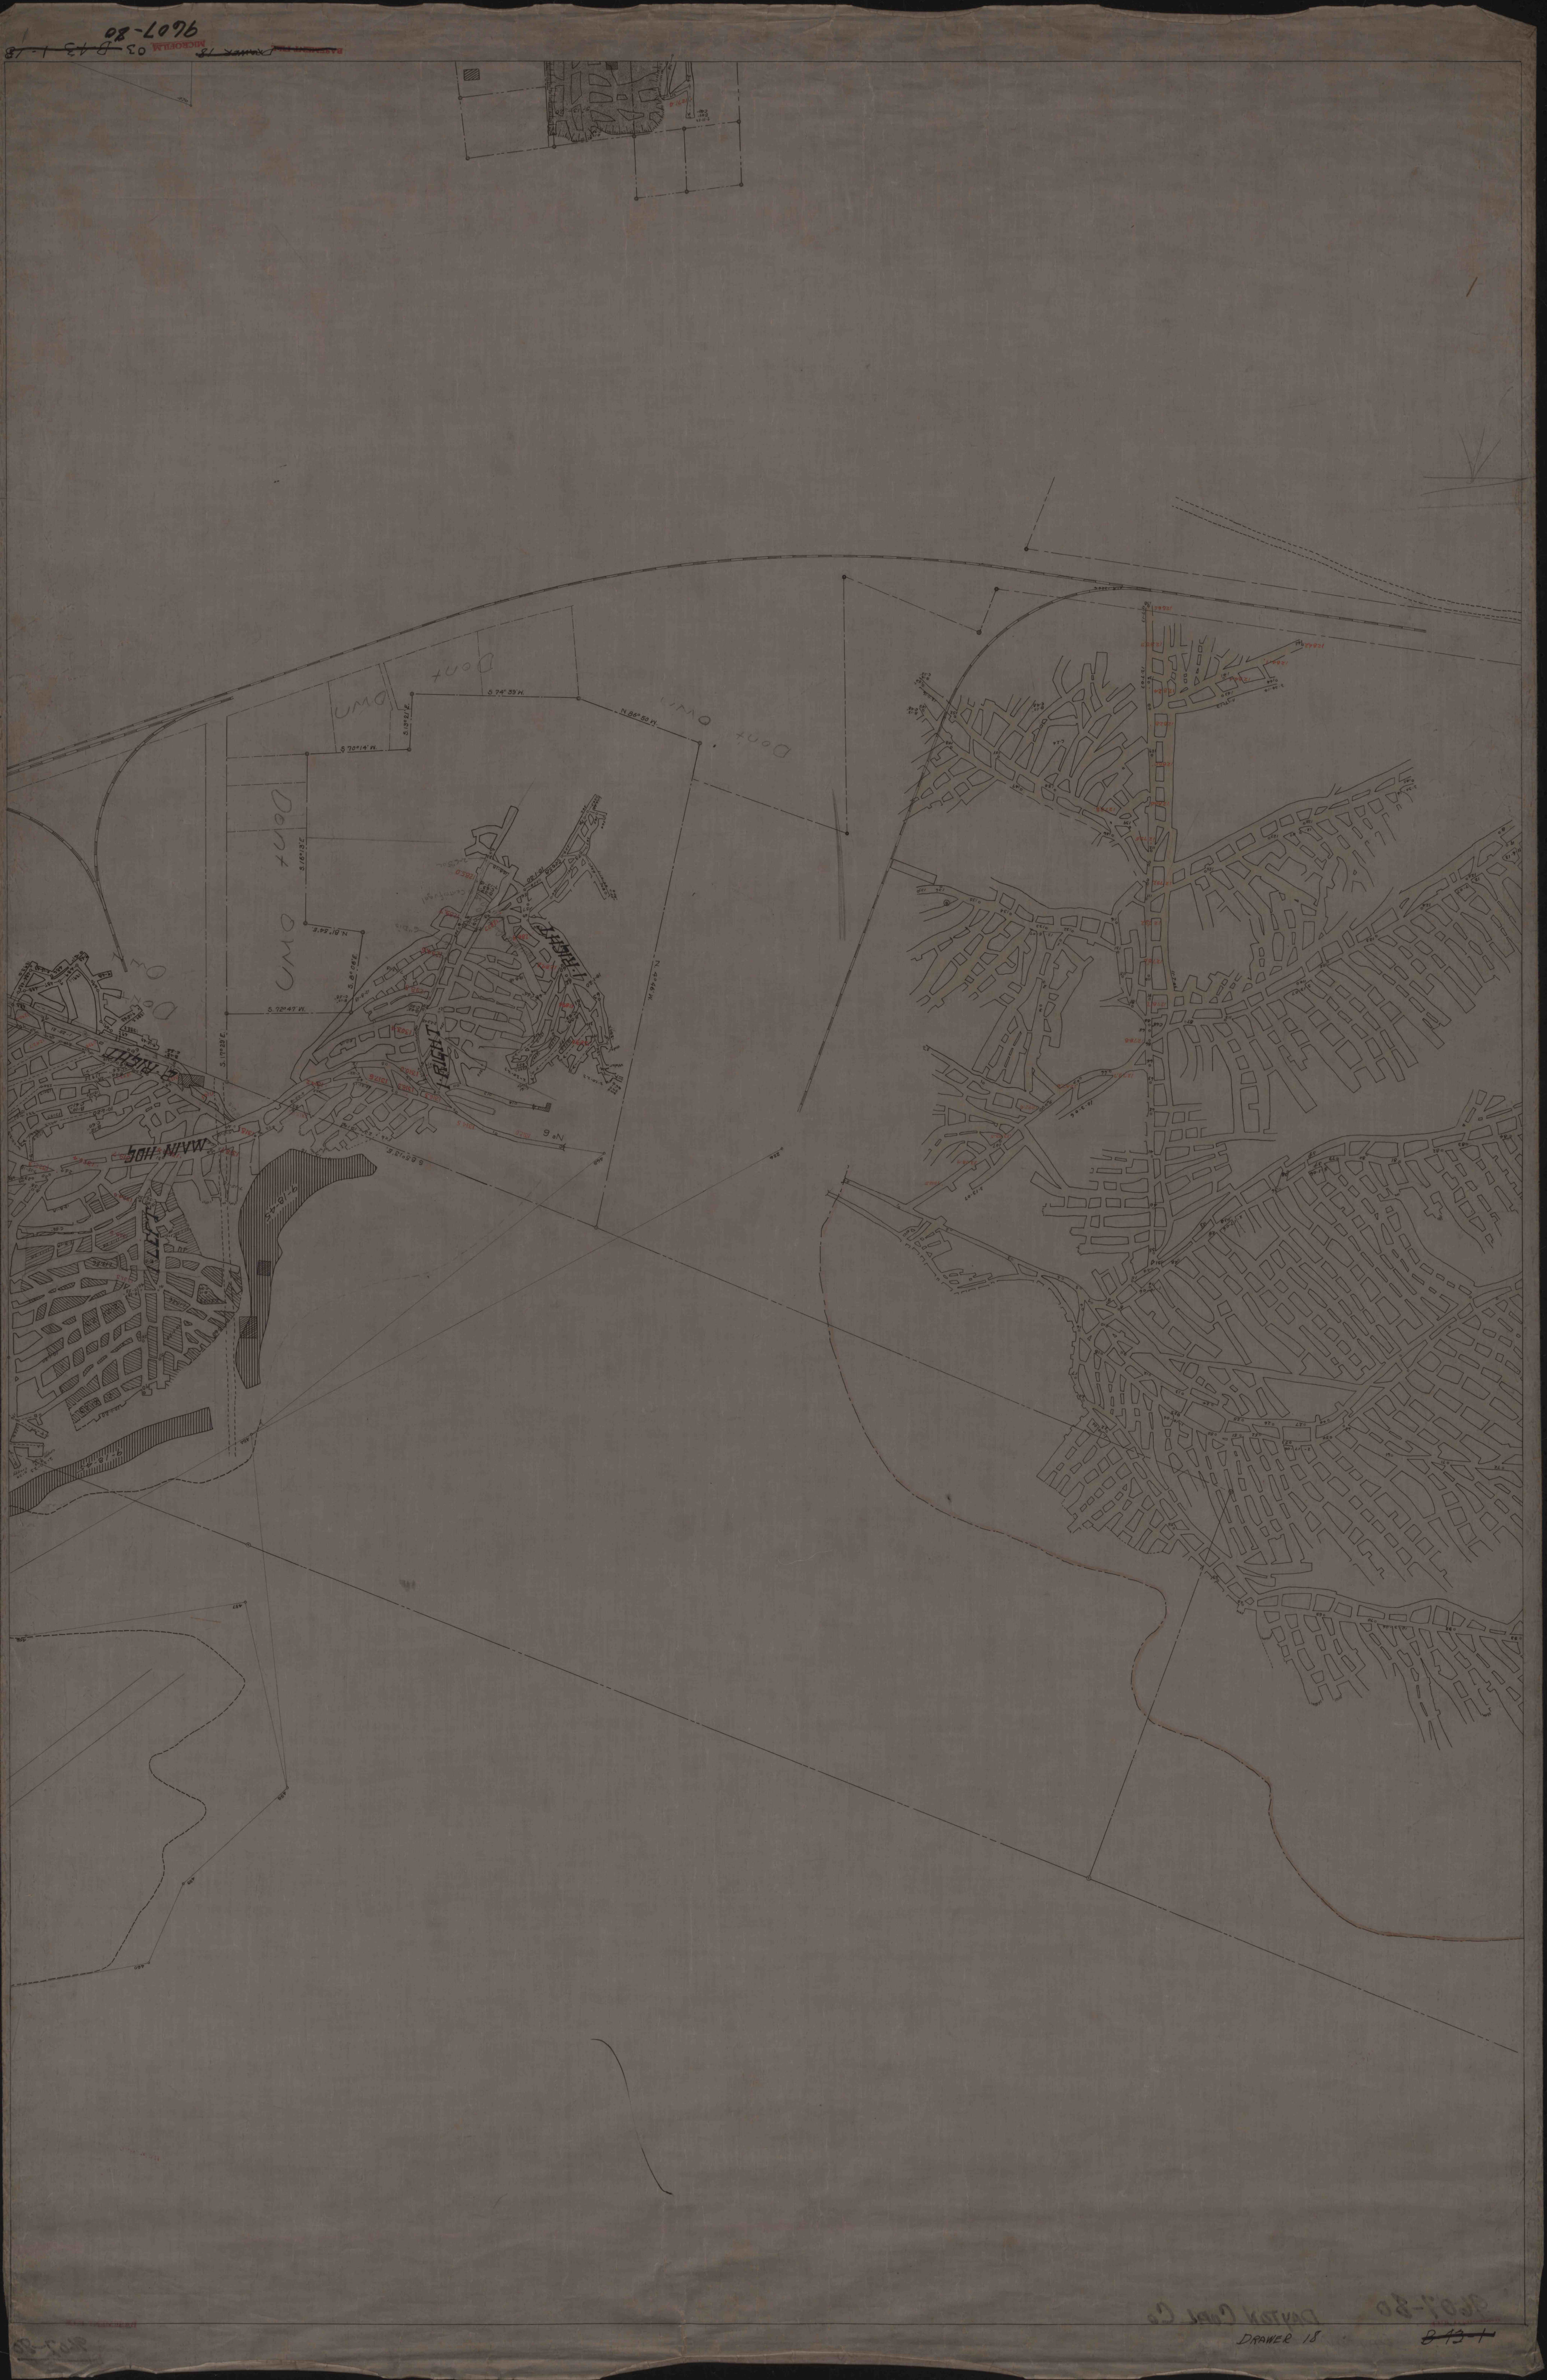

9607-80
DRAWER 15
03 043 1-18

9607-80
DRAWER 15
03 043 1-18