


2001-88
B-43

DAYTON MINE

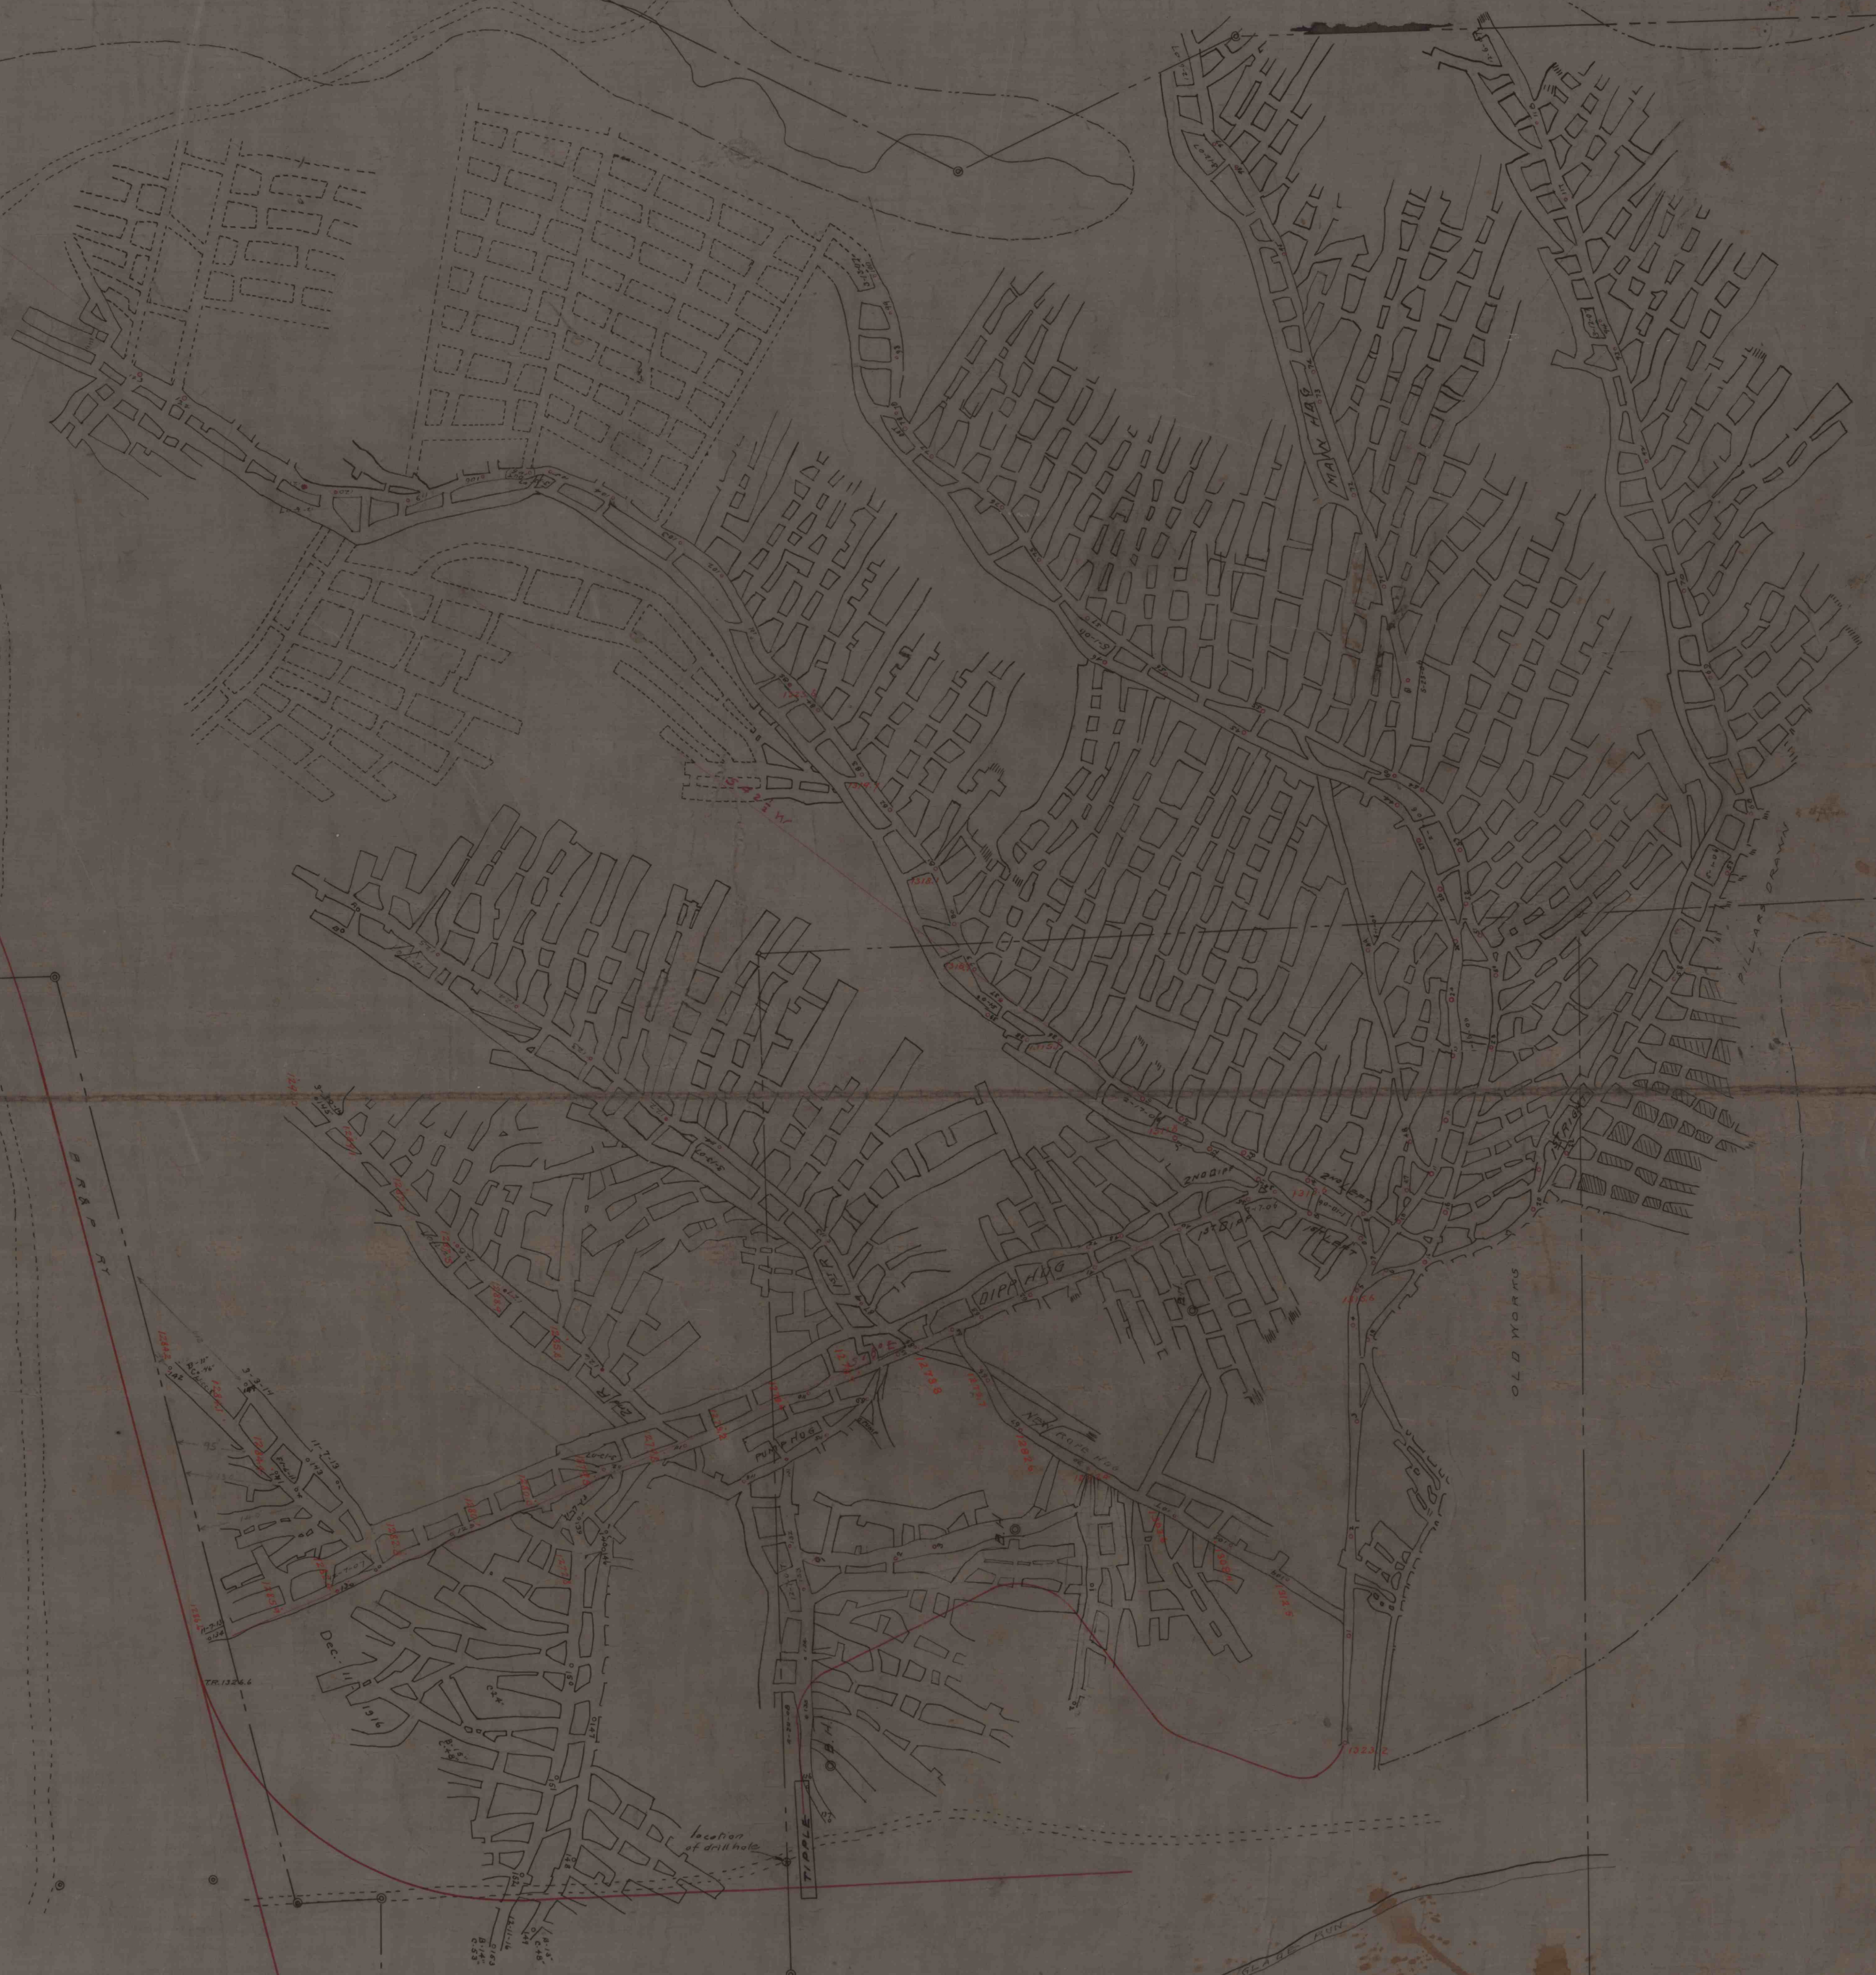

2001-88
B-43
DRAWER 18 03 B-43