


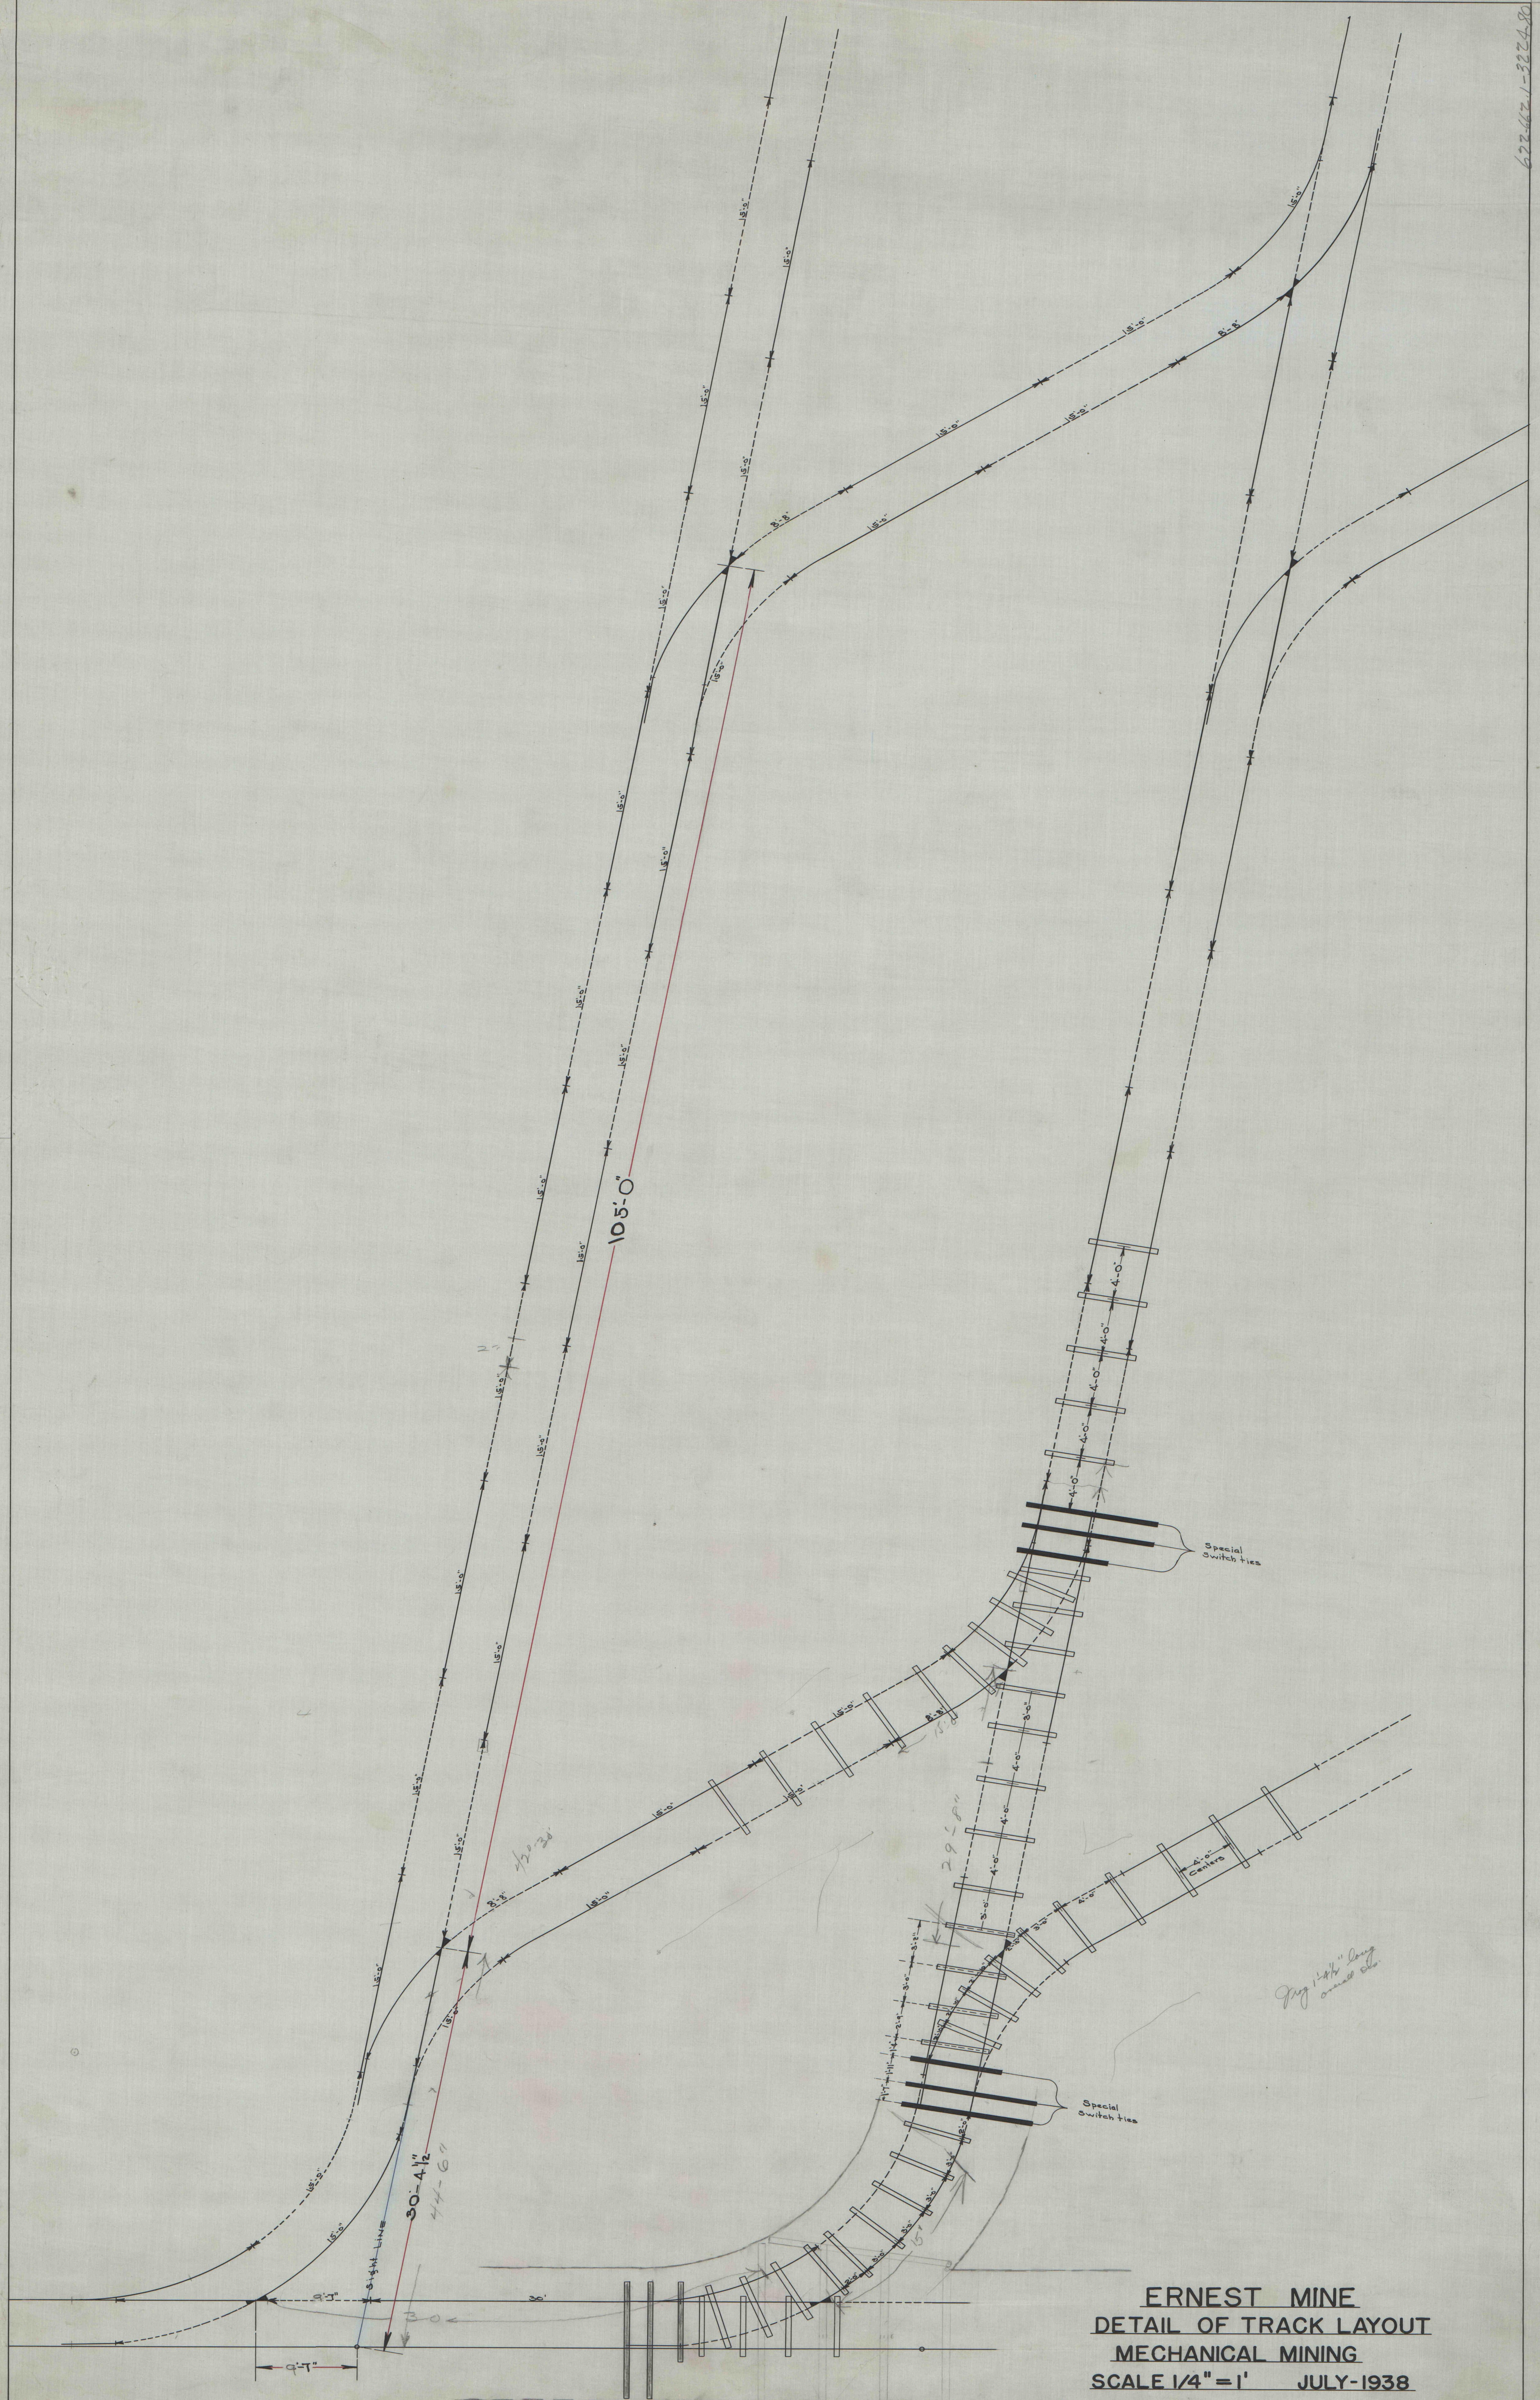

ERNEST MINE
DETAIL OF TRACK LAYOUT
MECHANICAL MINING
SCALE 1/4" = 1' JULY-1938