


LOWMAN

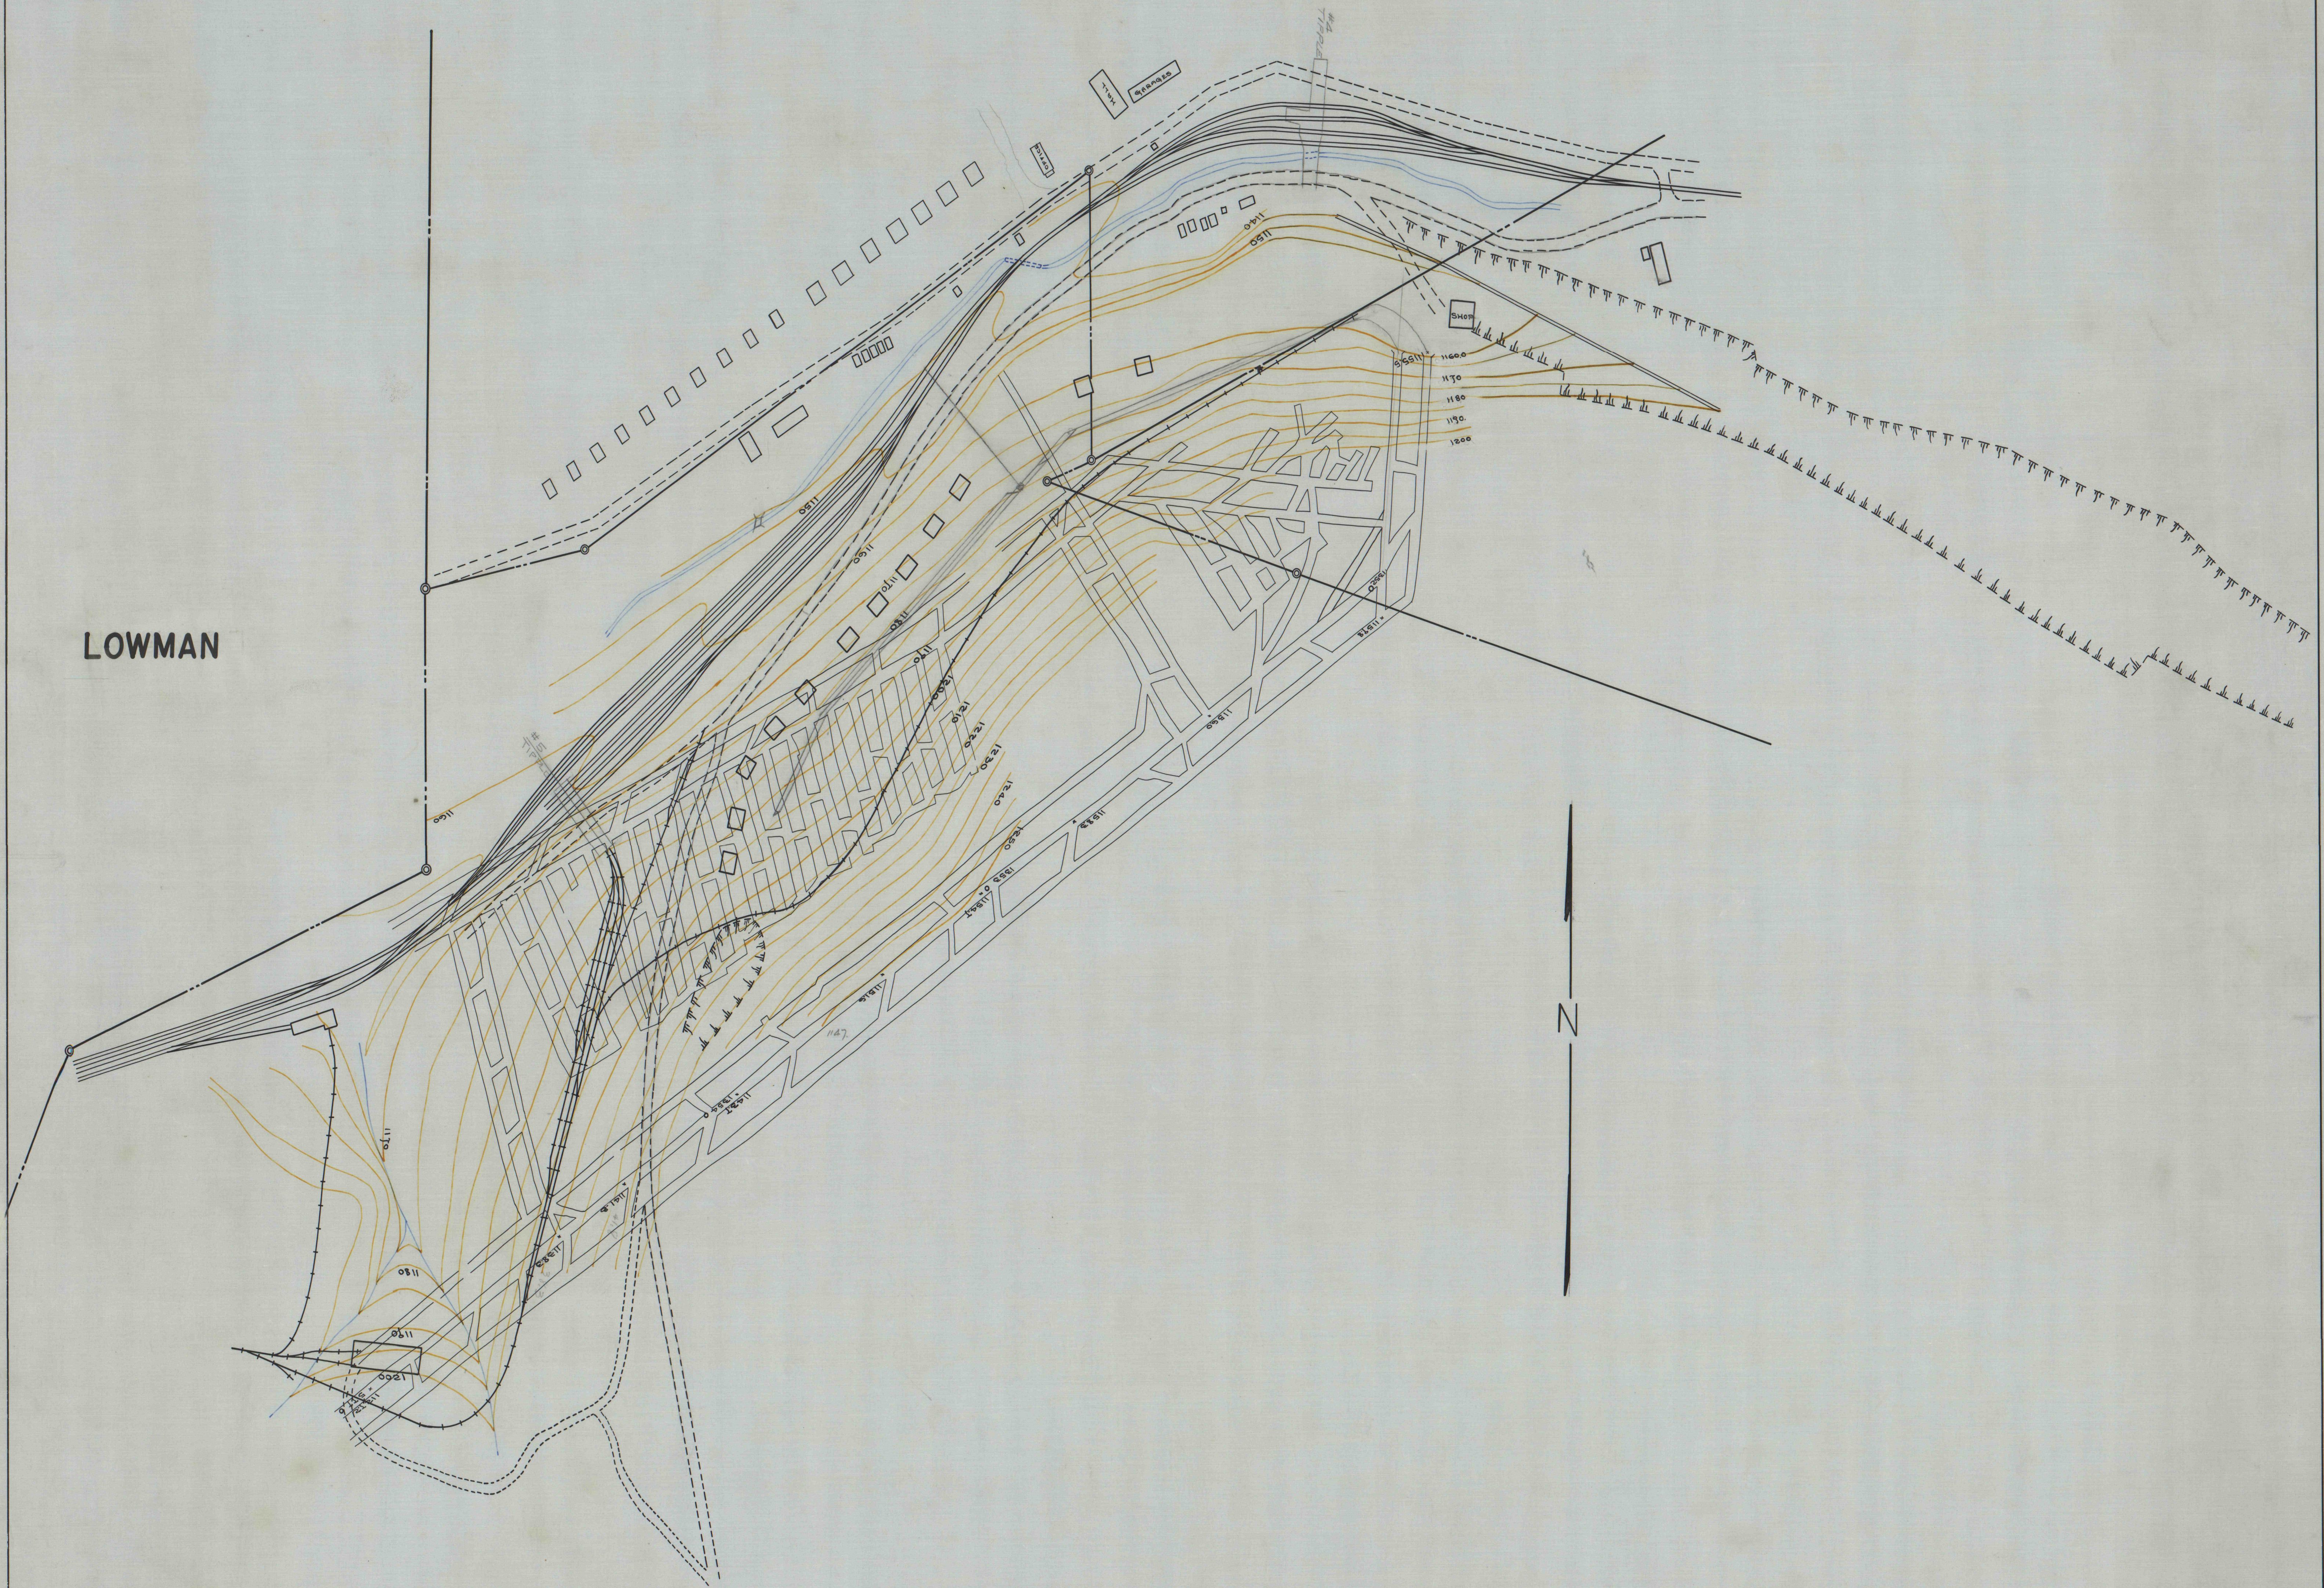

SURFACE FEATURES
BETWEEN KENT NO. 4
AND KENT NO. 5 TIPPLES
SCALE 1"=100' 11-18-36